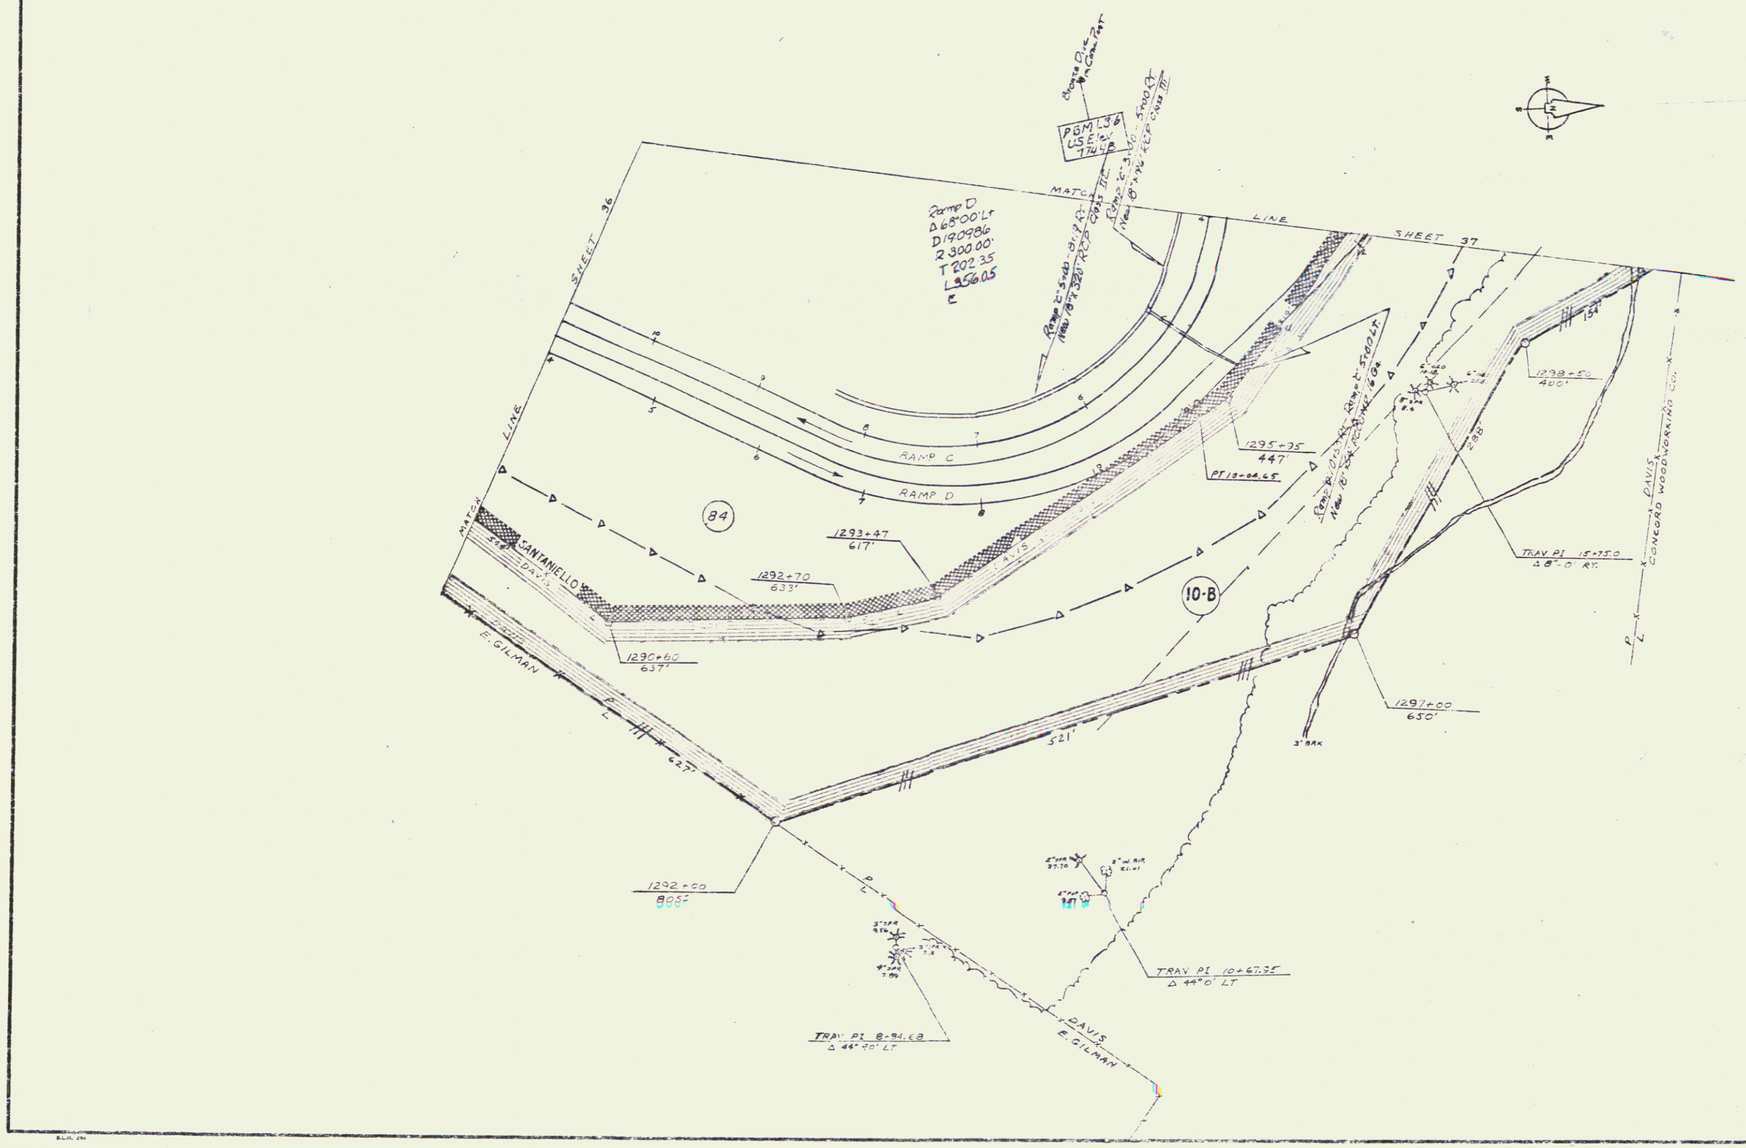

SURVEYED BY _____ DATE _____
DRAWN BY _____ DATE _____
TRACED BY _____ DATE _____

LYNDON BARTON
I 91-3(14) ROW SECT. I
SHEET 37 OF 155