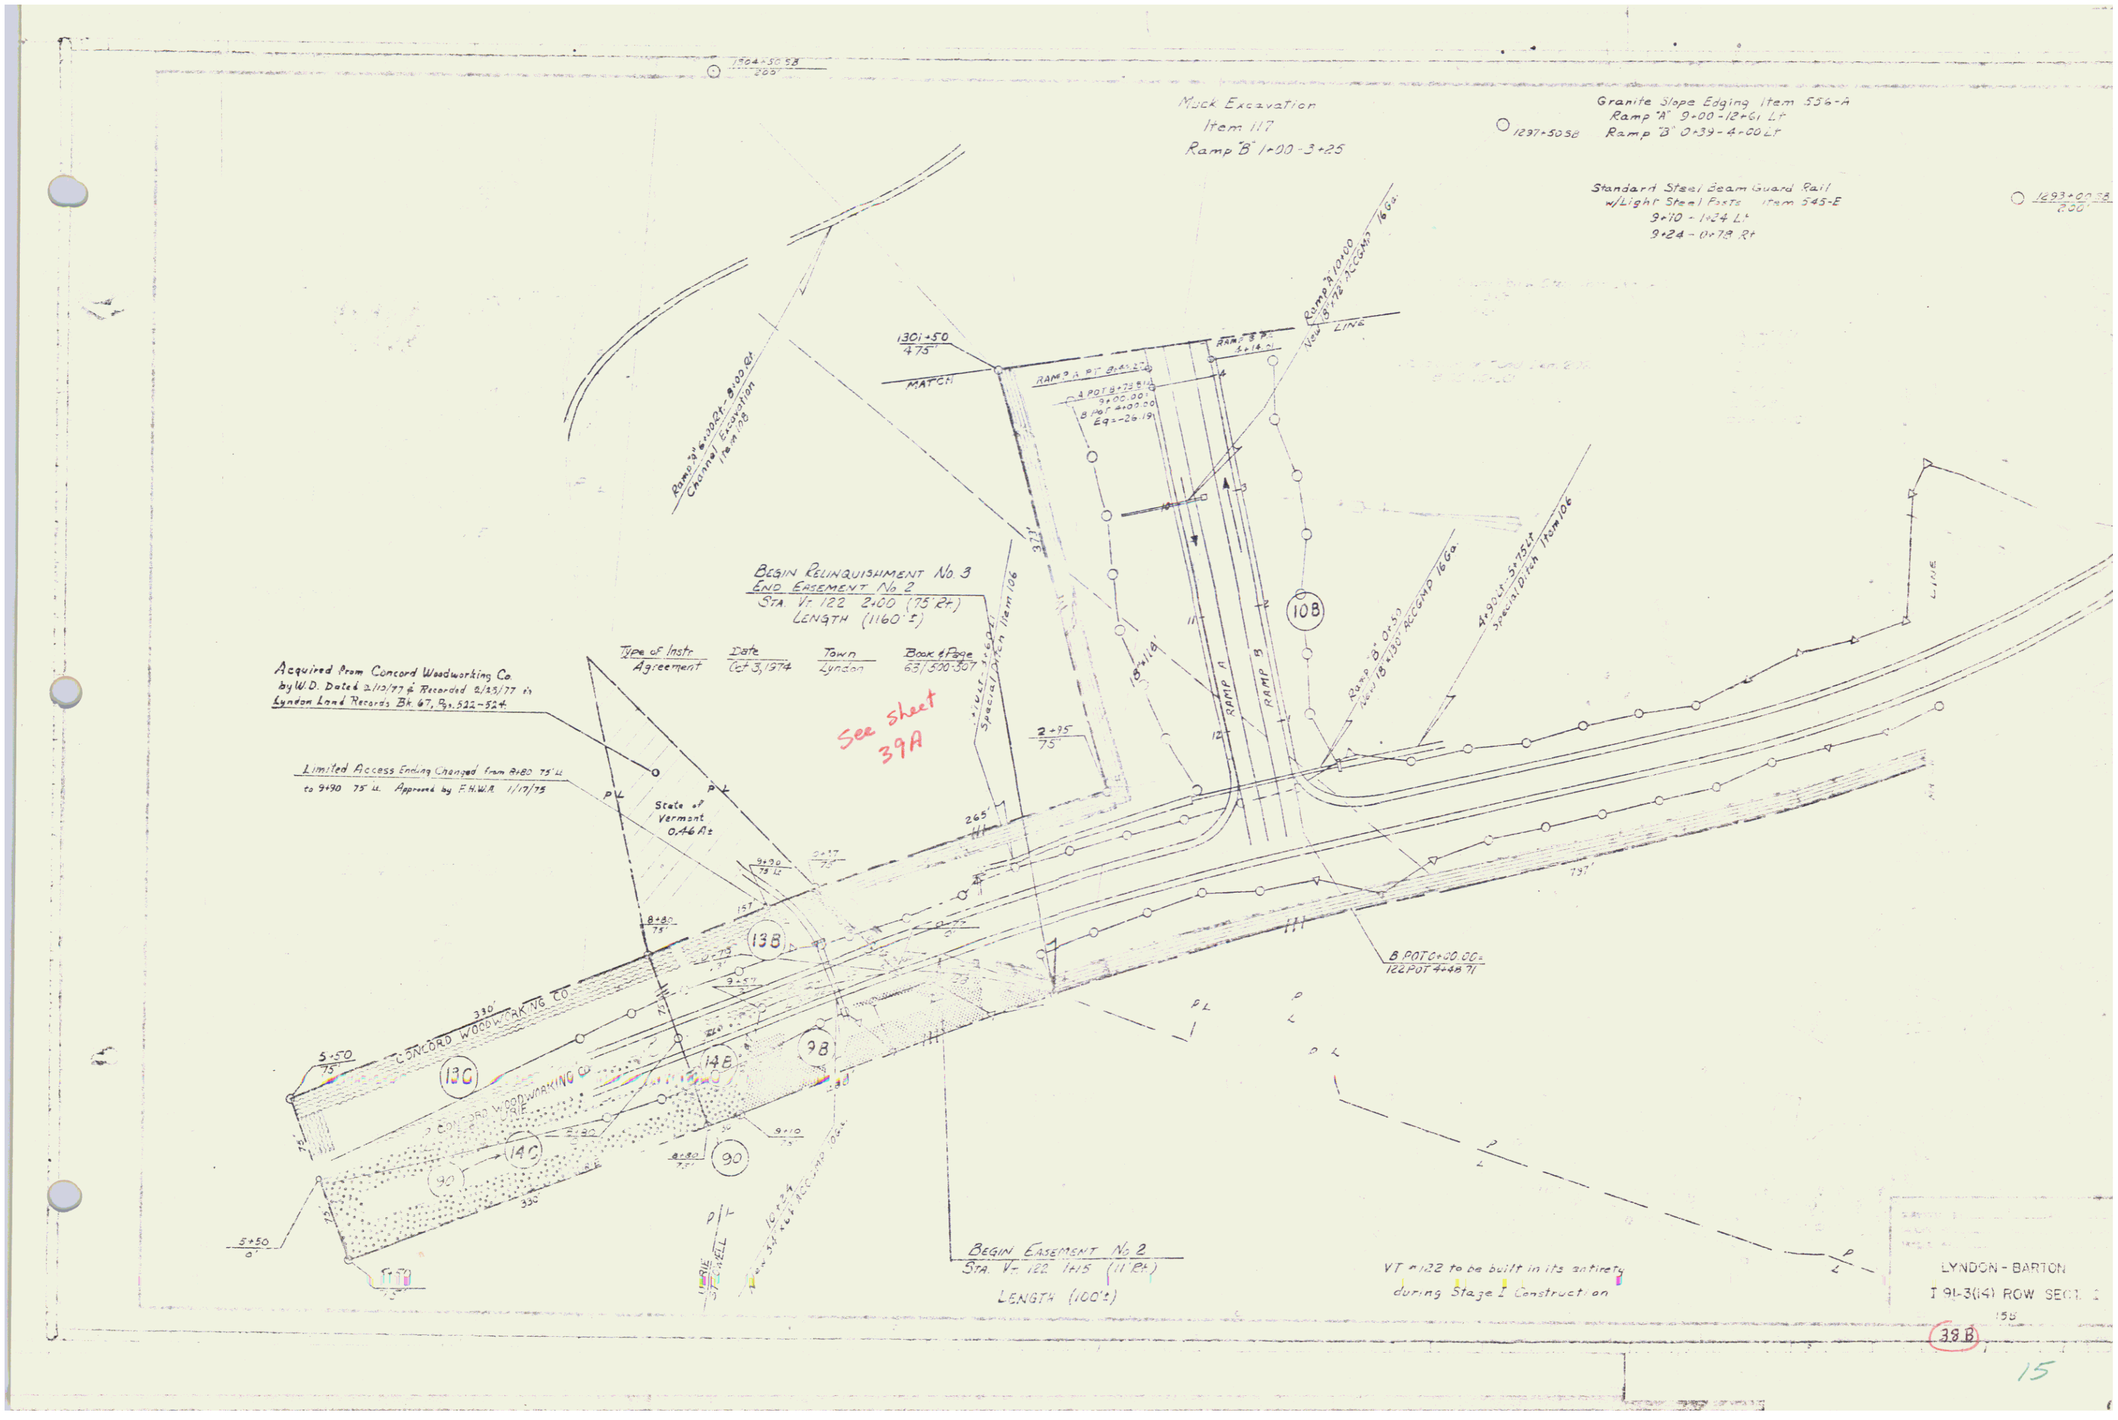
Muck Excavation
Item 117
Ramp "B" 1+00 - 3+25
Granite Slope Edging Item 556-A
Ramp "A" 9+00 - 12+61 Lt
Ramp "B" 0+39 - 4+00 Lt
Standard Steel Beam Guard Rail
w/Light Steel Posts Item 545-E
9+70 - 11+64 Lt
9+24 - 0+78 Rt
1237+50.58
1693+00.58
1301+50
475'
MATCH
Ramp "A" 10+00
View 8'-7½" ACCGND 16 Ga.
LINE
Ramp "A" 8+00 Lt
Channel Excavation
Item 106
BEGIN RELINQUISHMENT No. 3
END EASEMENT No. 2
STA. VT 122 2+00 (75' Rt)
LENGTH (1160' ±)
Type of Instr. Agreement
Date Oct 3, 1974
Town Lyndon
Book & Page 63/500-507
Acquired from Concord Woodworking Co.
by W.D. Dated 2/10/77 & Recorded 2/23/77 in
Lyndon Land Records Bk. 67, Pg. 522-524.
Limited Access Ending Changed from 8+80 75' Lt
to 9+90 75' Lt. Approved by F.H.W.A. 11/17/75
See sheet 39A
State of Vermont
0.46 Ac
Special Ditch Item 106
RAMP A
RAMP B
10B
4+30 Lt - 5+75 Lt
Special Ditch Item 106
Ramp "B" 0+50
View 8'-7½" ACCGND 16 Ga.
2+95
75'
265'
797'
13B
9+90
75' Lt
8+80
75'
9+70
75'
9+24
75'
9+10
75'
8+80
75'
9B
14B
9C
14C
13C
CONCORD WOODWORKING CO.
330'
5+50
75'
5+50
0'
B POT 0+00.00±
122 POT 4+48.71
BEGIN EASEMENT No. 2
STA. VT 122 1+15 (11' Rt)
LENGTH (100' ±)
VT #122 to be built in its entirety
during Stage I Construction
LYNDON - BARTON
I 91-3(14) ROW SECT. 1
38B
15