


Mass Fill (Light Type) Item 512
Ramp D 16' 75" EA - NB 1303+75 EA

Sub Base of Sand

Muck Excavation
Item 117
SB 1300+00 - 1305+00
NB 1300+00 - 1305+00


Treated Timber Curb

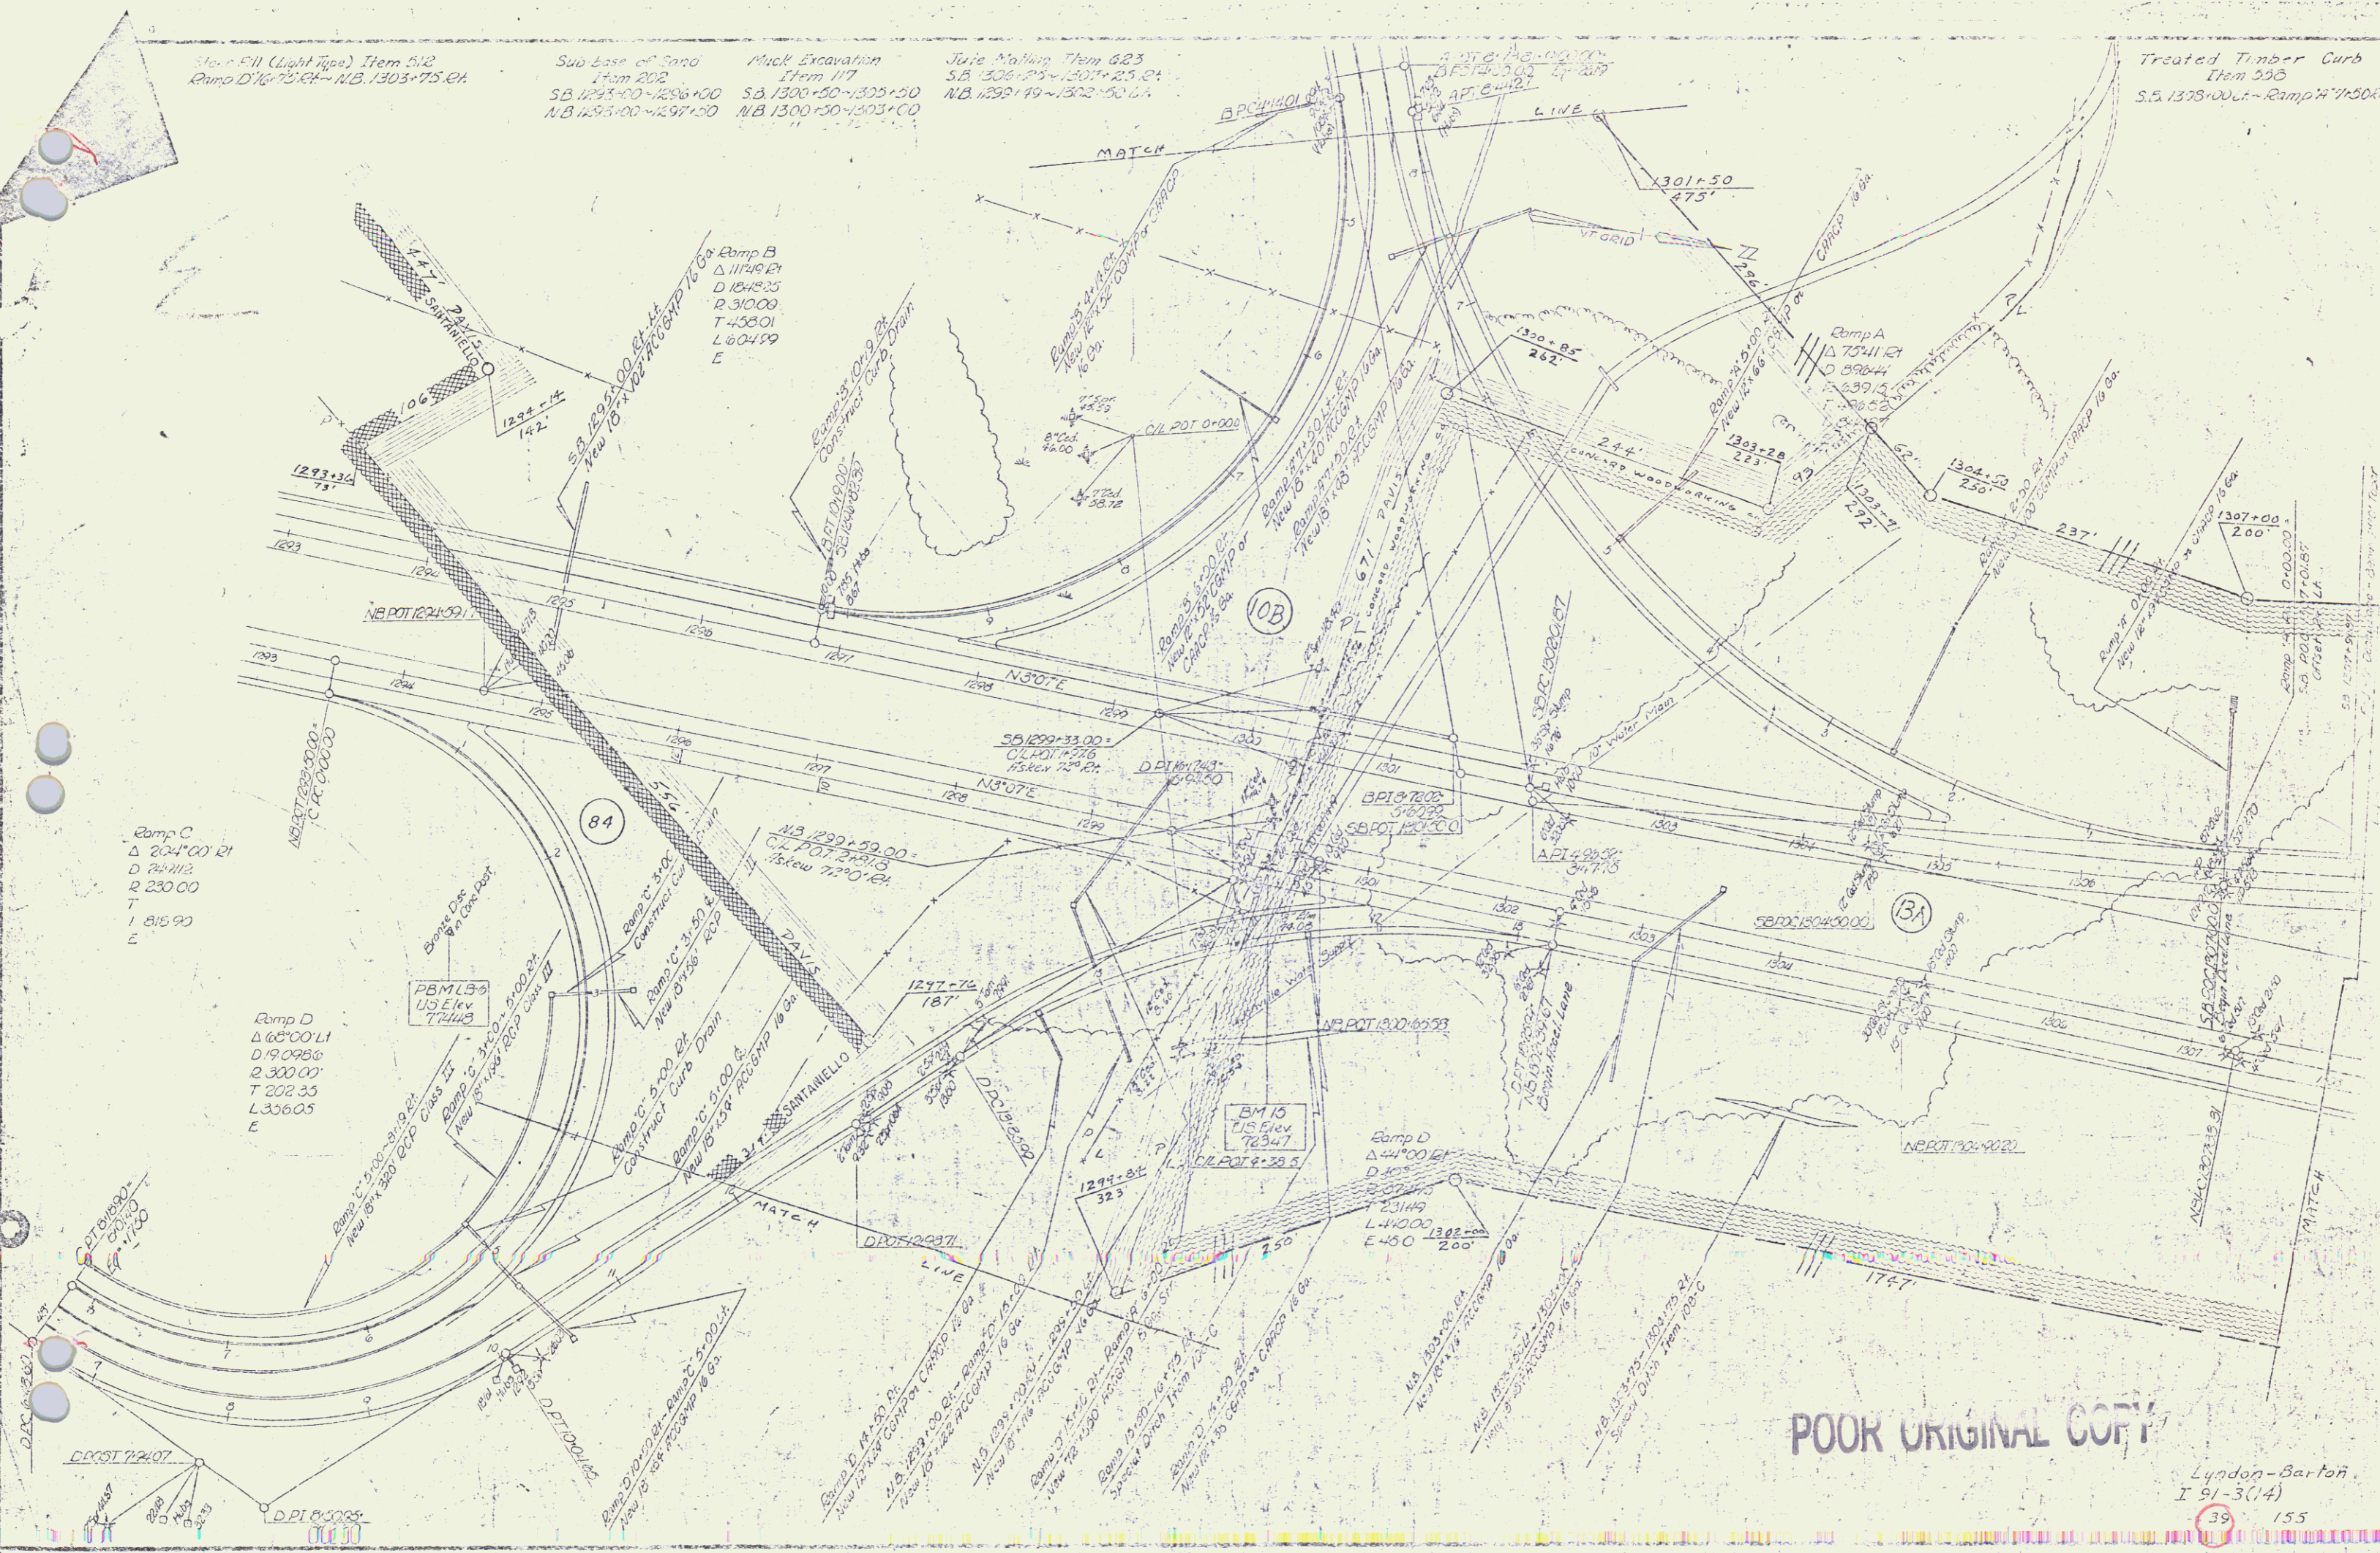

POOR ORIGINAL COPY

Lyndon-Barton
I 91-3(14)
39 155