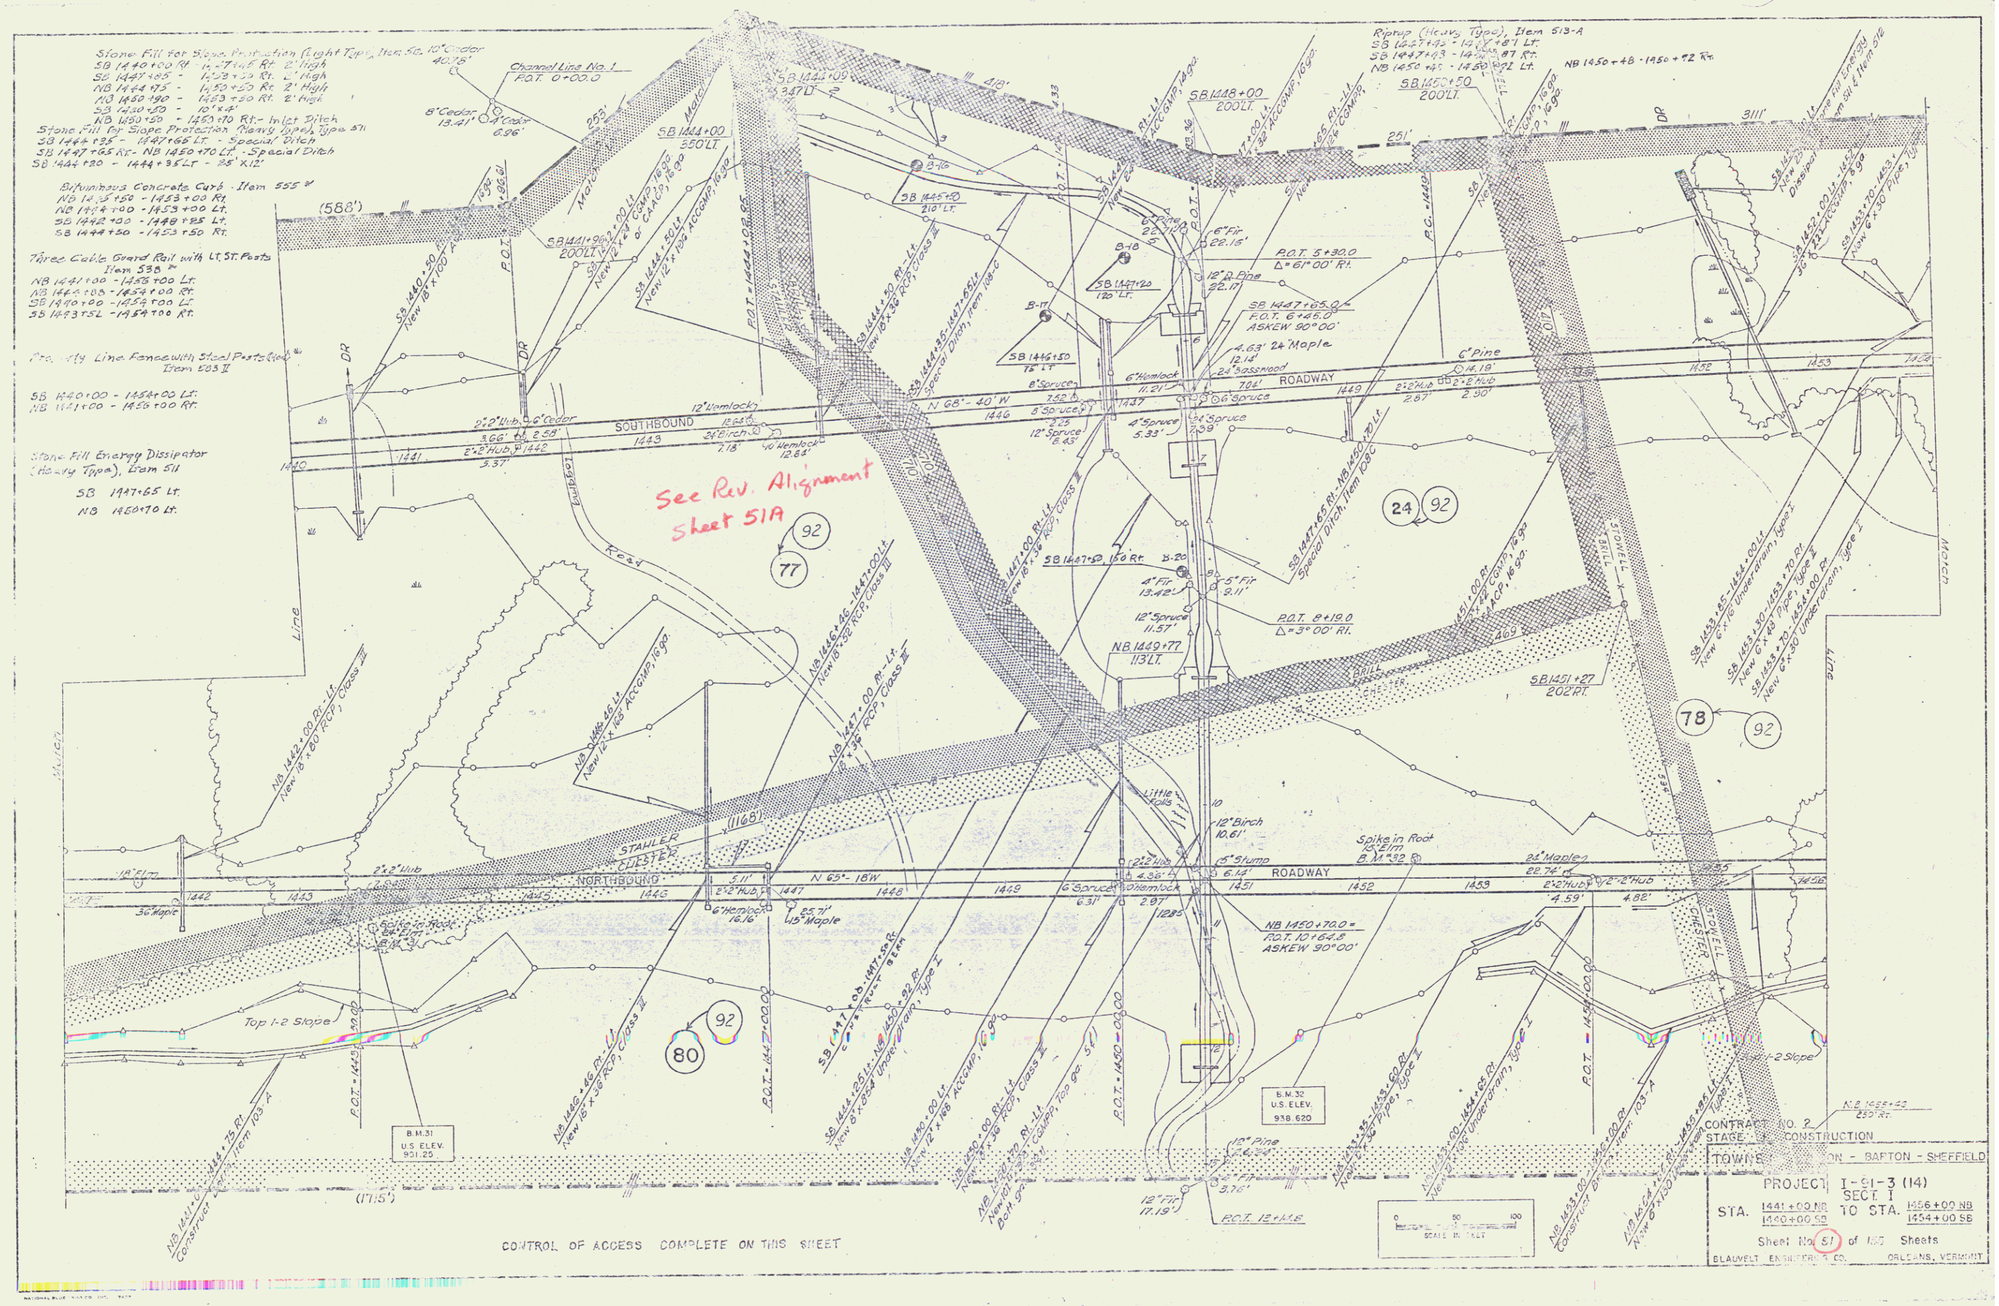
SOUTHBOUND
NORTHBOUND
ROADWAY
See Rev. Alignment Sheet 51A
CONTROL OF ACCESS COMPLETE ON THIS SHEET
CONTRACT NO. 2
STAGE CONSTRUCTION
TOWNS ON - BARTON - SHEFFIELD
PROJECT I-91-3 (14)
SECT. I
STA. 1441+00 NB 1440+00 SB TO STA. 1456+00 NB 1454+00 SB
Sheet No. 51 of 157 Sheets
BLAUVELT ENGINEERING CO. ORLEANS, VERMONT

31