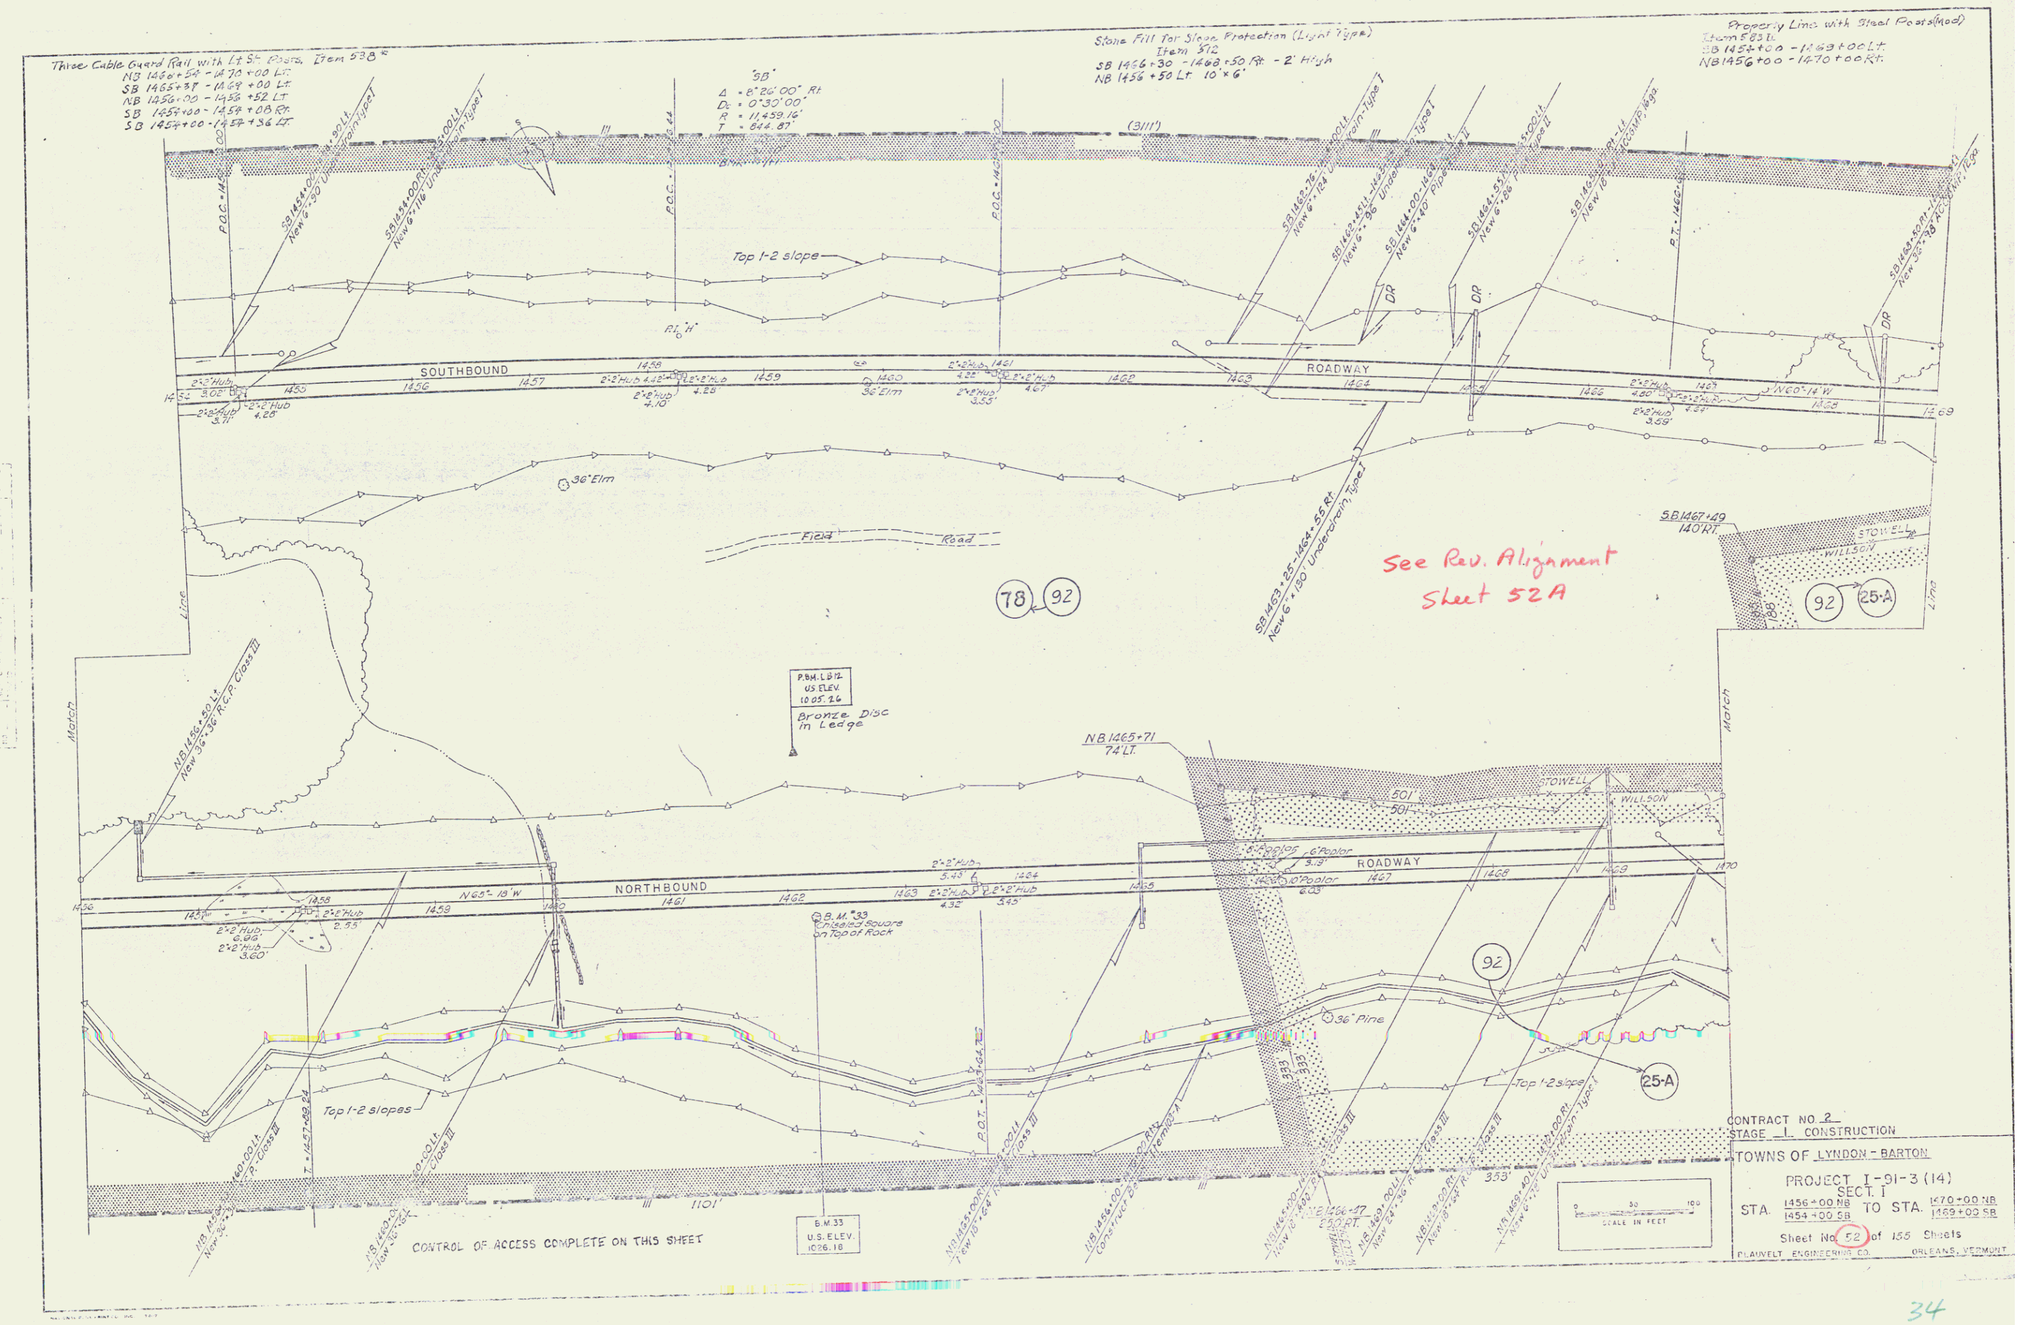

CONTRACT NO. 2
STAGE I. CONSTRUCTION
TOWNS OF LYNDON - BARTON
PROJECT I-91-3 (14)
SECT. I
STA. 1456+00 NB / 1454+00 SB TO STA. 1470+00 NB / 1469+00 SB
Sheet No. 52 of 155 Sheets
FLAUVELT ENGINEERING CO. ORLEANS, VERMONT