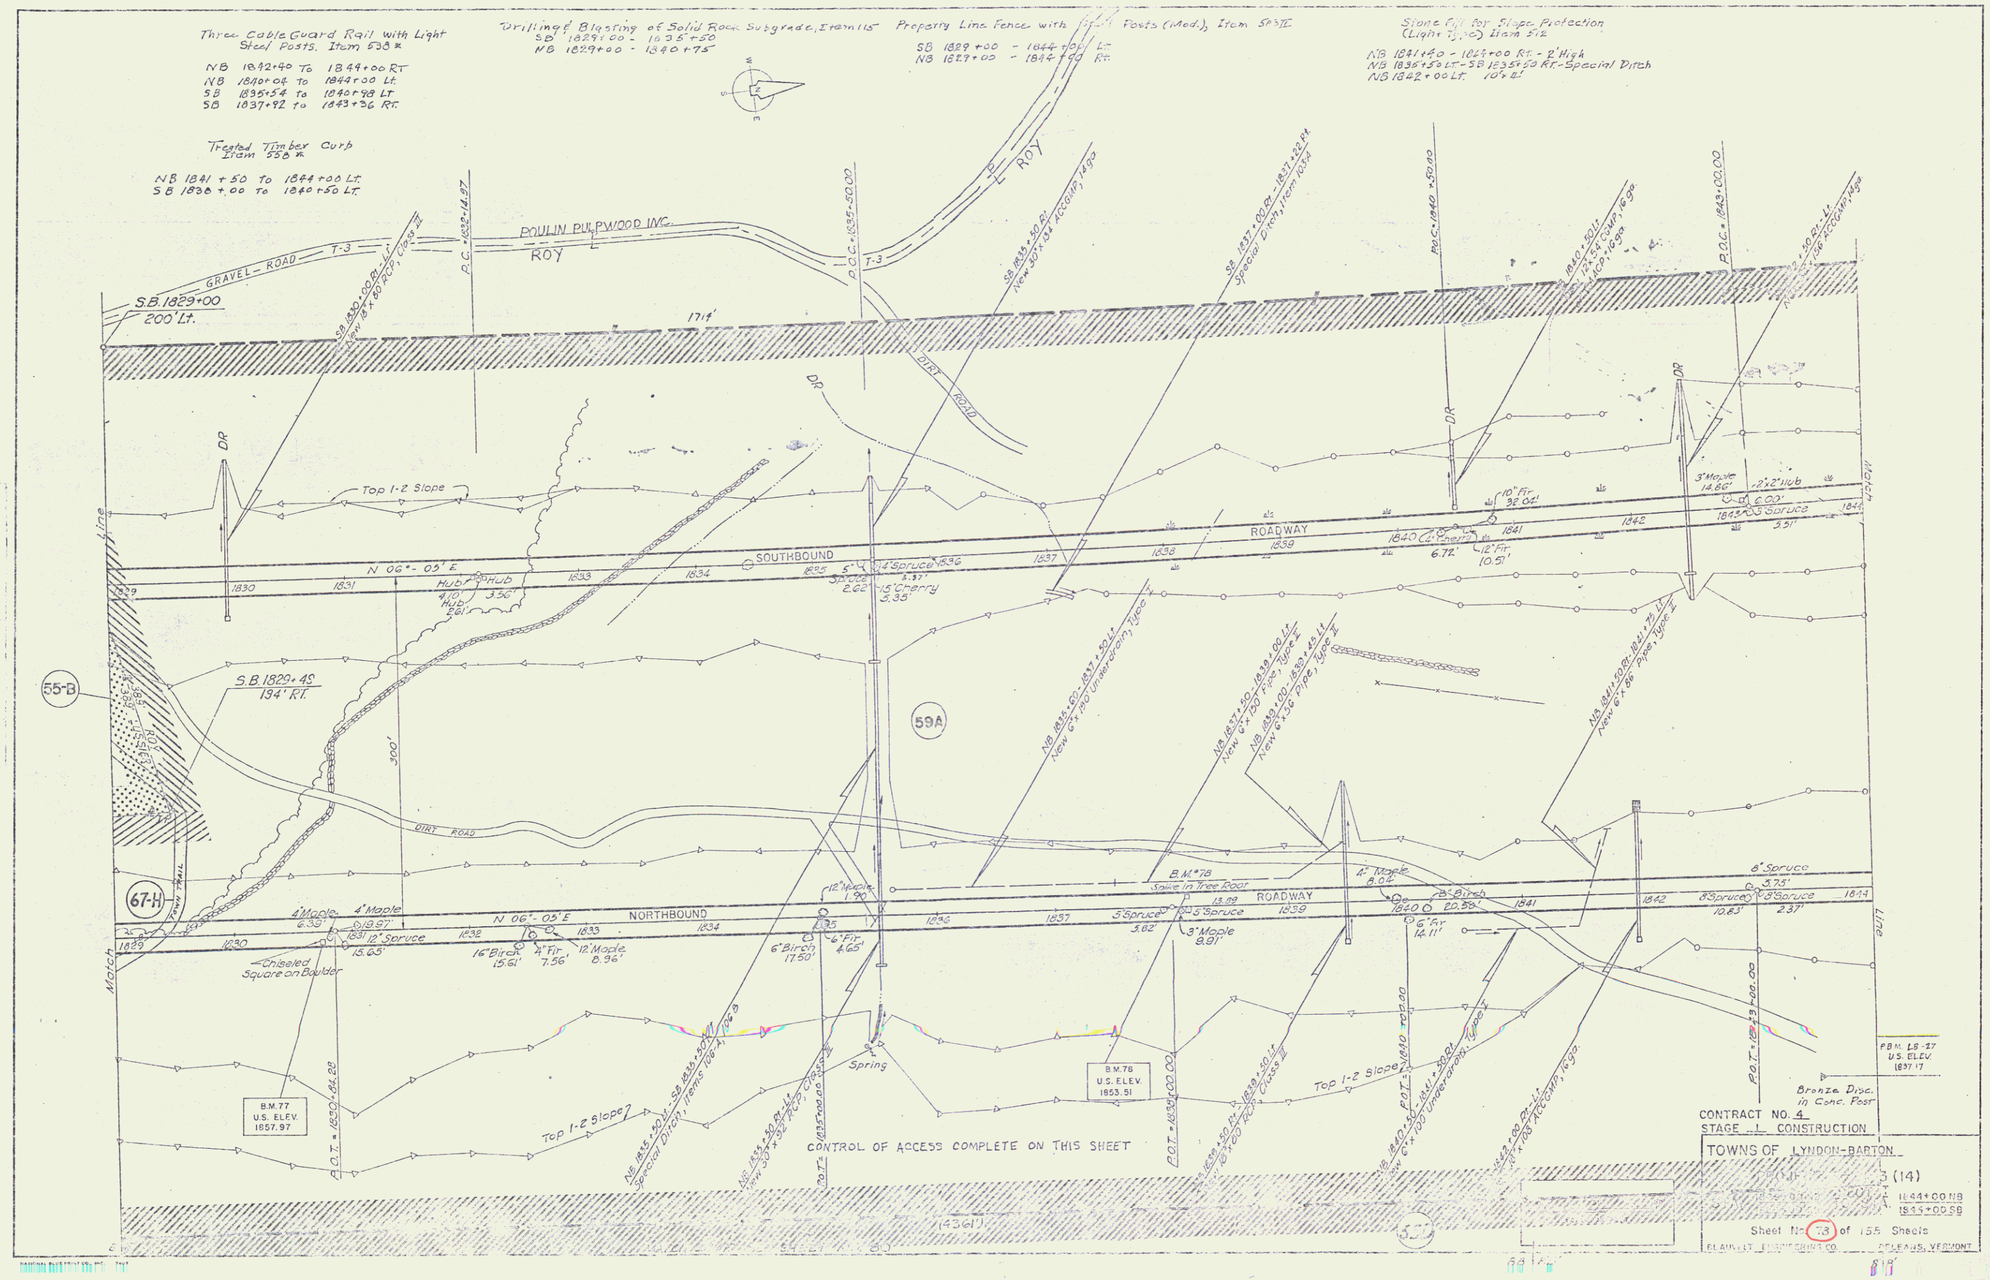
Three Cable Guard Rail with Light Steel Posts. Item 538 R
NB 1842+40 To 1844+00 RT
NB 1840+04 to 1844+00 Lt.
SB 1835+54 to 1840+98 LT.
SB 1837+82 to 1843+36 RT.
Treated Timber Curb Item 556 R
NB 1841+50 to 1844+00 Lt.
SB 1836+00 to 1840+50 Lt.
Drilling & Blasting of Solid Rock Subgrade, Item 115
SB 1829+00 - 1835+50
NB 1829+00 - 1840+75
Property Line Fence with Posts (Mod.), Item 543 II
SB 1829+00 - 1844+00 Lt.
NB 1829+00 - 1844+00 Rt.
Stone Fill for Slope Protection (Light Tj, o) Item 512
NB 1841+40 - 1844+00 Rt. - 2' High
NB 1836+50 Lt. - SB 1835+50 Rt. - Special Ditch
NB 1842+00 Lt. 10' x 2'
POULIN PULPWOOD INC.
ROY
GRAVEL ROAD
S.B. 1829+00
200' Lt.
1714'
DIRT ROAD
Top 1-2 Slope
N 06°- 05' E
SOUTHBOUND
ROADWAY
S.B. 1829+49
194' Rt.
55-B
59A
67-H
NORTHBOUND
Chiseled Square on Boulder
B.M. 77
U.S. ELEV.
1857.97
B.M. 76
U.S. ELEV.
1853.51
Spring
CONTROL OF ACCESS COMPLETE ON THIS SHEET
FBM. LS-27
U.S. ELEV.
1837.17
Bronze Disc. in Conc. Post
CONTRACT NO. 4
STAGE 1 CONSTRUCTION
TOWNS OF LYNDON-BARTON
Sheet No. 73 of 155 Sheets

67