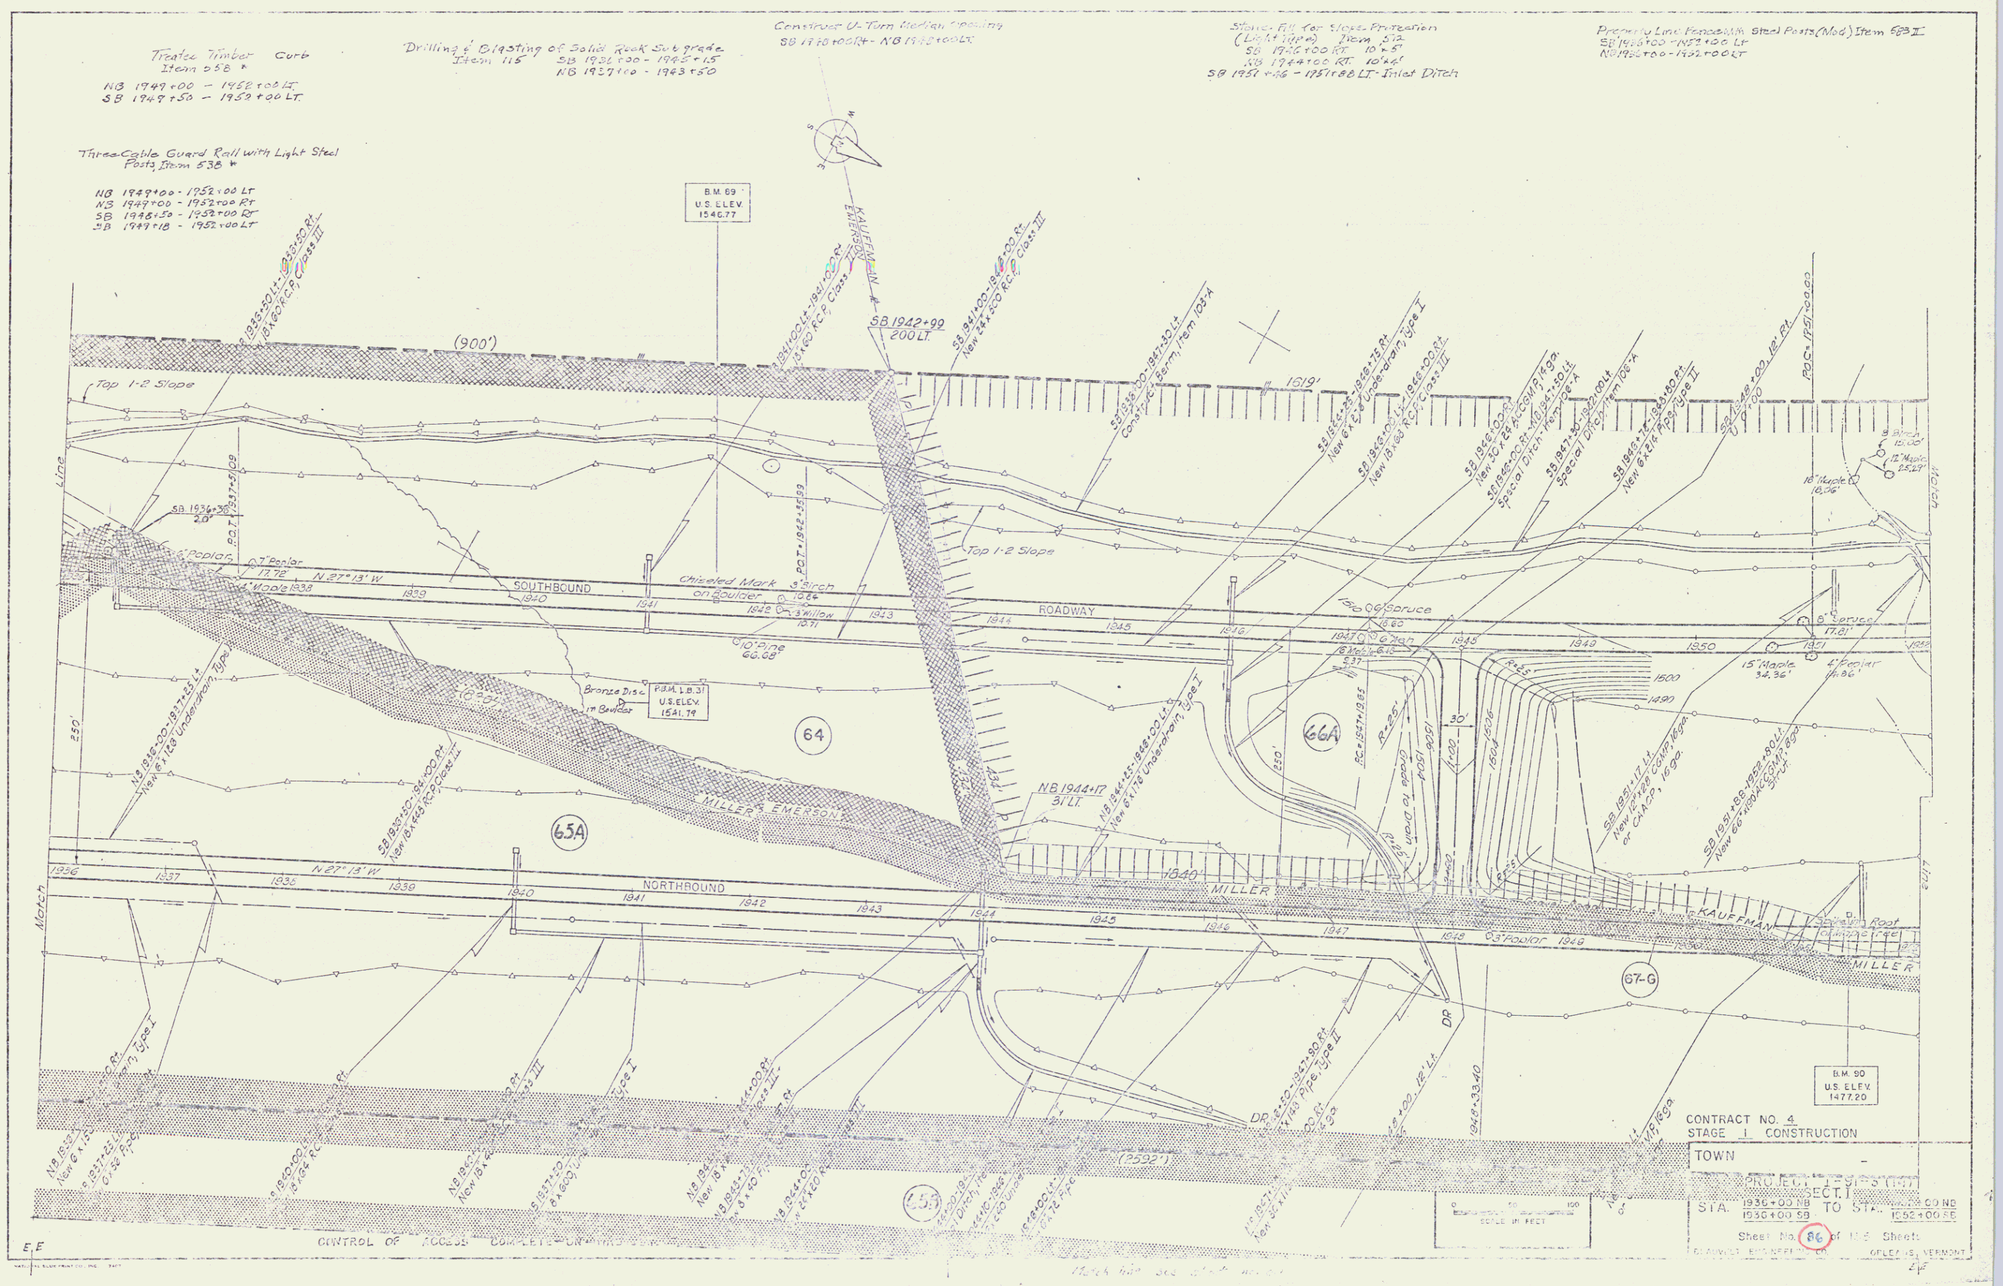
Treated Timber Curb
Item 538 *
NB 1949+00 - 1952+00 LT
SB 1949+50 - 1952+00 LT
Drilling & Blasting of Solid Rock Subgrade
Item 115
SB 1931+30 - 1945+15
NB 1927+00 - 1943+50
Construct U-Turn Median Opening
SB 1948+00 RT - NB 1948+00 LT
Stone Fill for Slope Protection
(Light Type)
Item 512
SB 1946+00 RT 10'±5'
NB 1944+00 RT 10'±5'
SB 1951+66 - 1951+88 LT - Inlet Ditch
Property Line Fence with Steel Posts (Mod.) Item 613 I
SB 1945+00 - 1952+00 LT
NB 1950+00 - 1952+00 LT
Three-Cable Guard Rail with Light Steel Posts Item 538 *
NB 1949+00 - 1952+00 LT
NB 1949+00 - 1952+00 RT
SB 1948+50 - 1952+00 RT
SB 1949+18 - 1952+00 LT
B.M. 69
U.S. ELEV.
1540.77
KAUFFMAN
EMERSON
SB 1942+99
200 LT
(900')
1619'
Top 1-2 Slope
SOUTHBOUND
ROADWAY
NORTHBOUND
MILLER
KAUFFMAN
EMERSON
Chiseled Mark
on Boulder
Bronze Disc
in Concrete
P.B.M. 1.B.31
U.S. ELEV.
1541.79
64
65A
66A
67-G
NB 1944+17
31' LT.
N 27° 13' W
B.M. 90
U.S. ELEV.
1477.20
CONTROL OF ACCESS COMPLETE
CONTRACT NO. 4
STAGE 1 CONSTRUCTION
TOWN -
PROJECT I-91-3 (147)
STA. 1936+00 NB TO STA. 1952+00 NB
1930+00 SB 1952+00 SB
Sheet No. 86 of 105 Sheets
SCALE IN FEET
GREENFIELD, VERMONT

75