







* STAGE 2 CONSTRUCTION

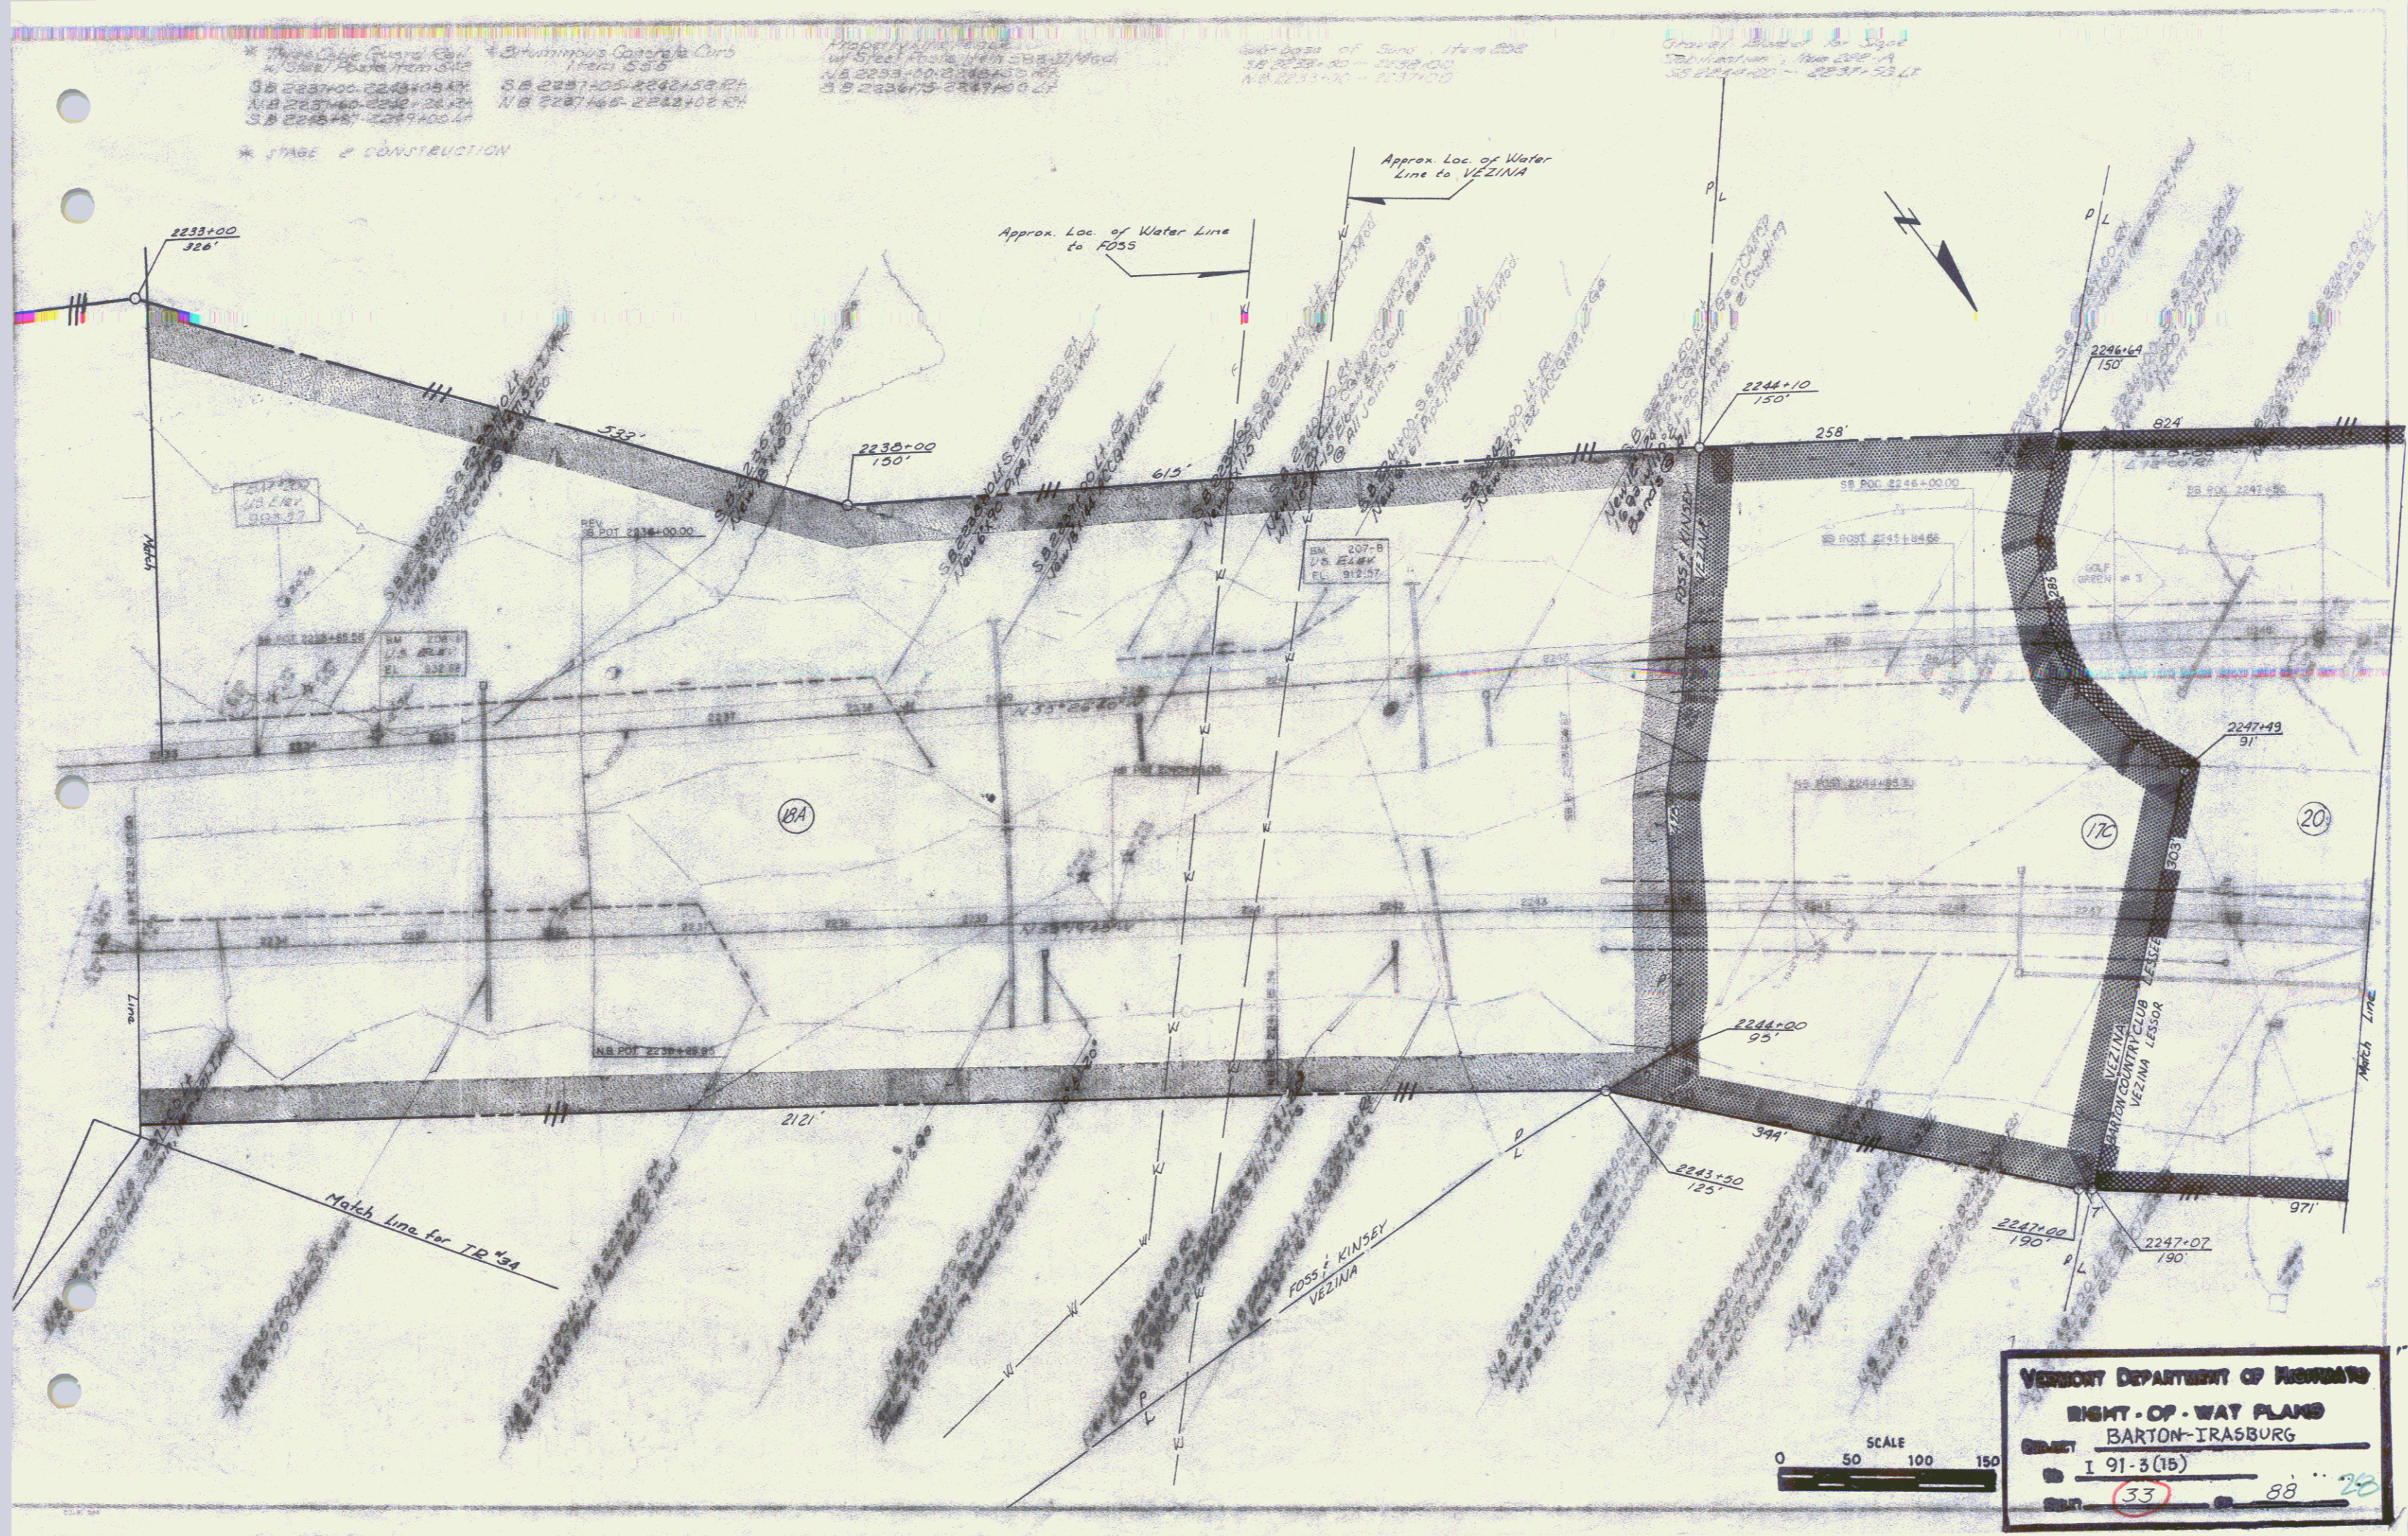

VERMONT DEPARTMENT OF HIGHWAYS
RIGHT-OF-WAY PLANS
BARTON-IRASBURG
 SHEET I 91-3 (15)
 33 88 20

