


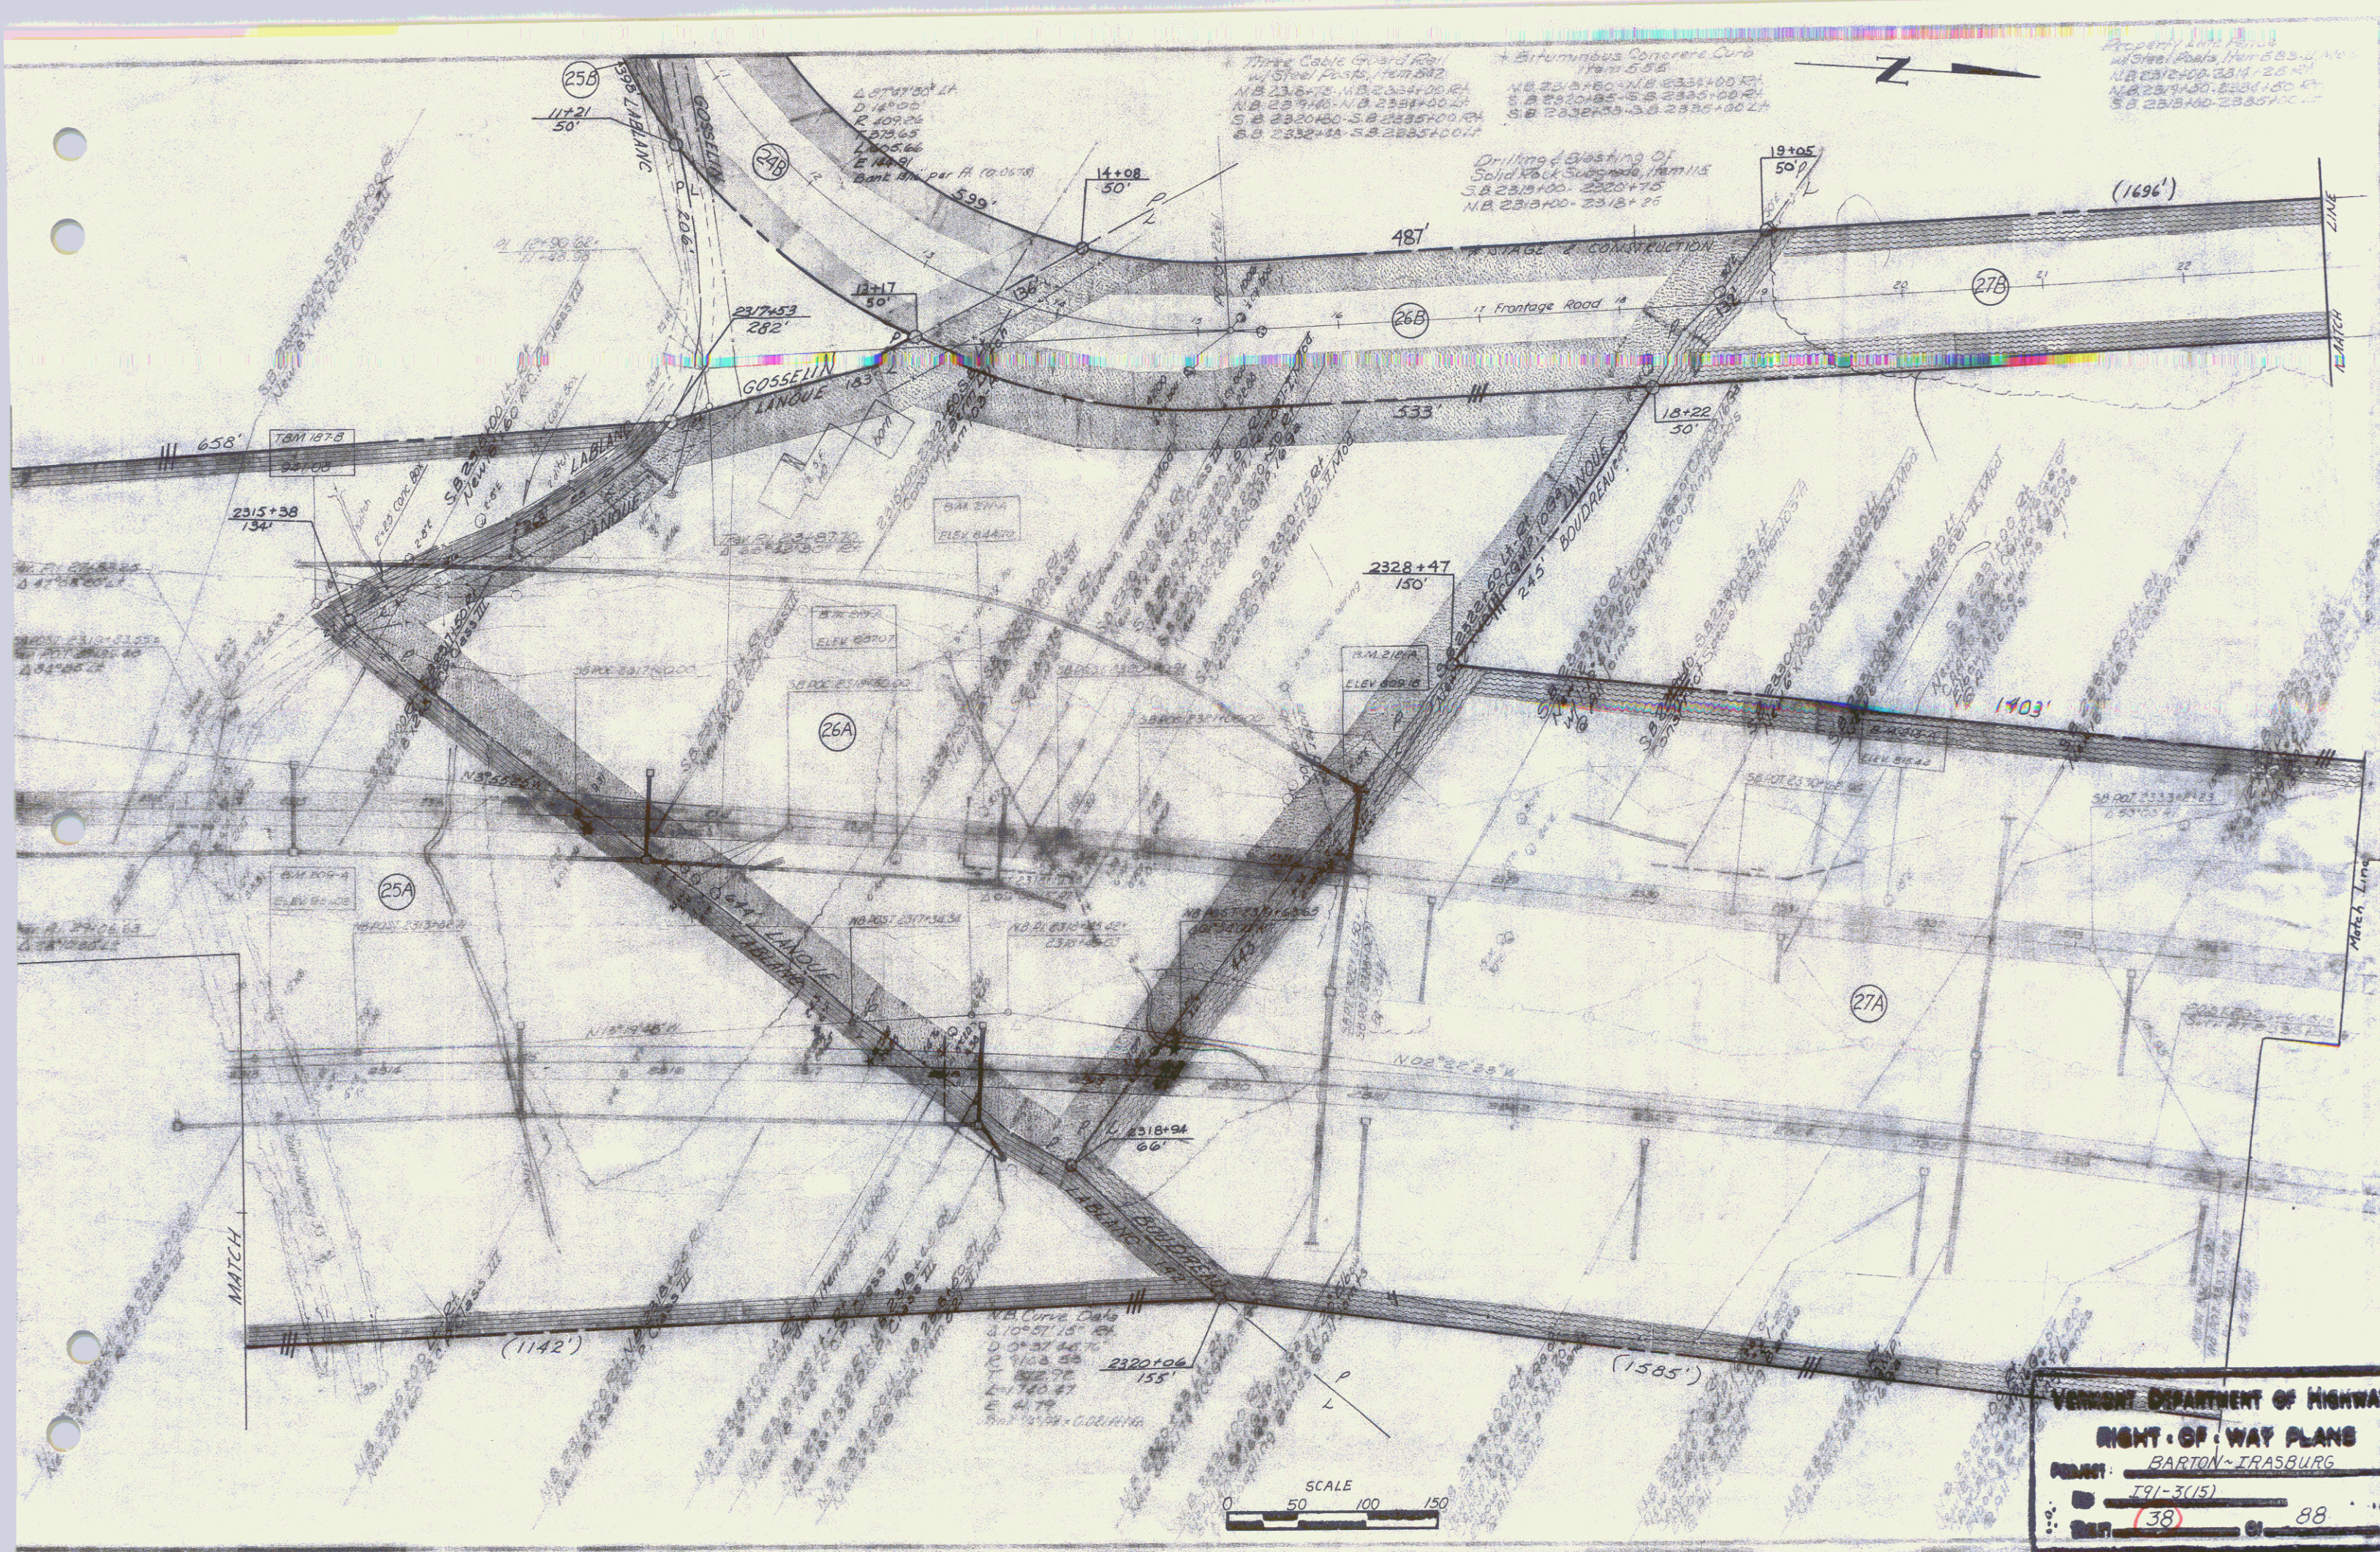

VERMONT DEPARTMENT OF HIGHWAYS
RIGHT-OF-WAY PLANS
PROJECT: BARTON-IRASBURG
SHEET: 38 OF 88