





* STAGE 2 CONSTRUCTION

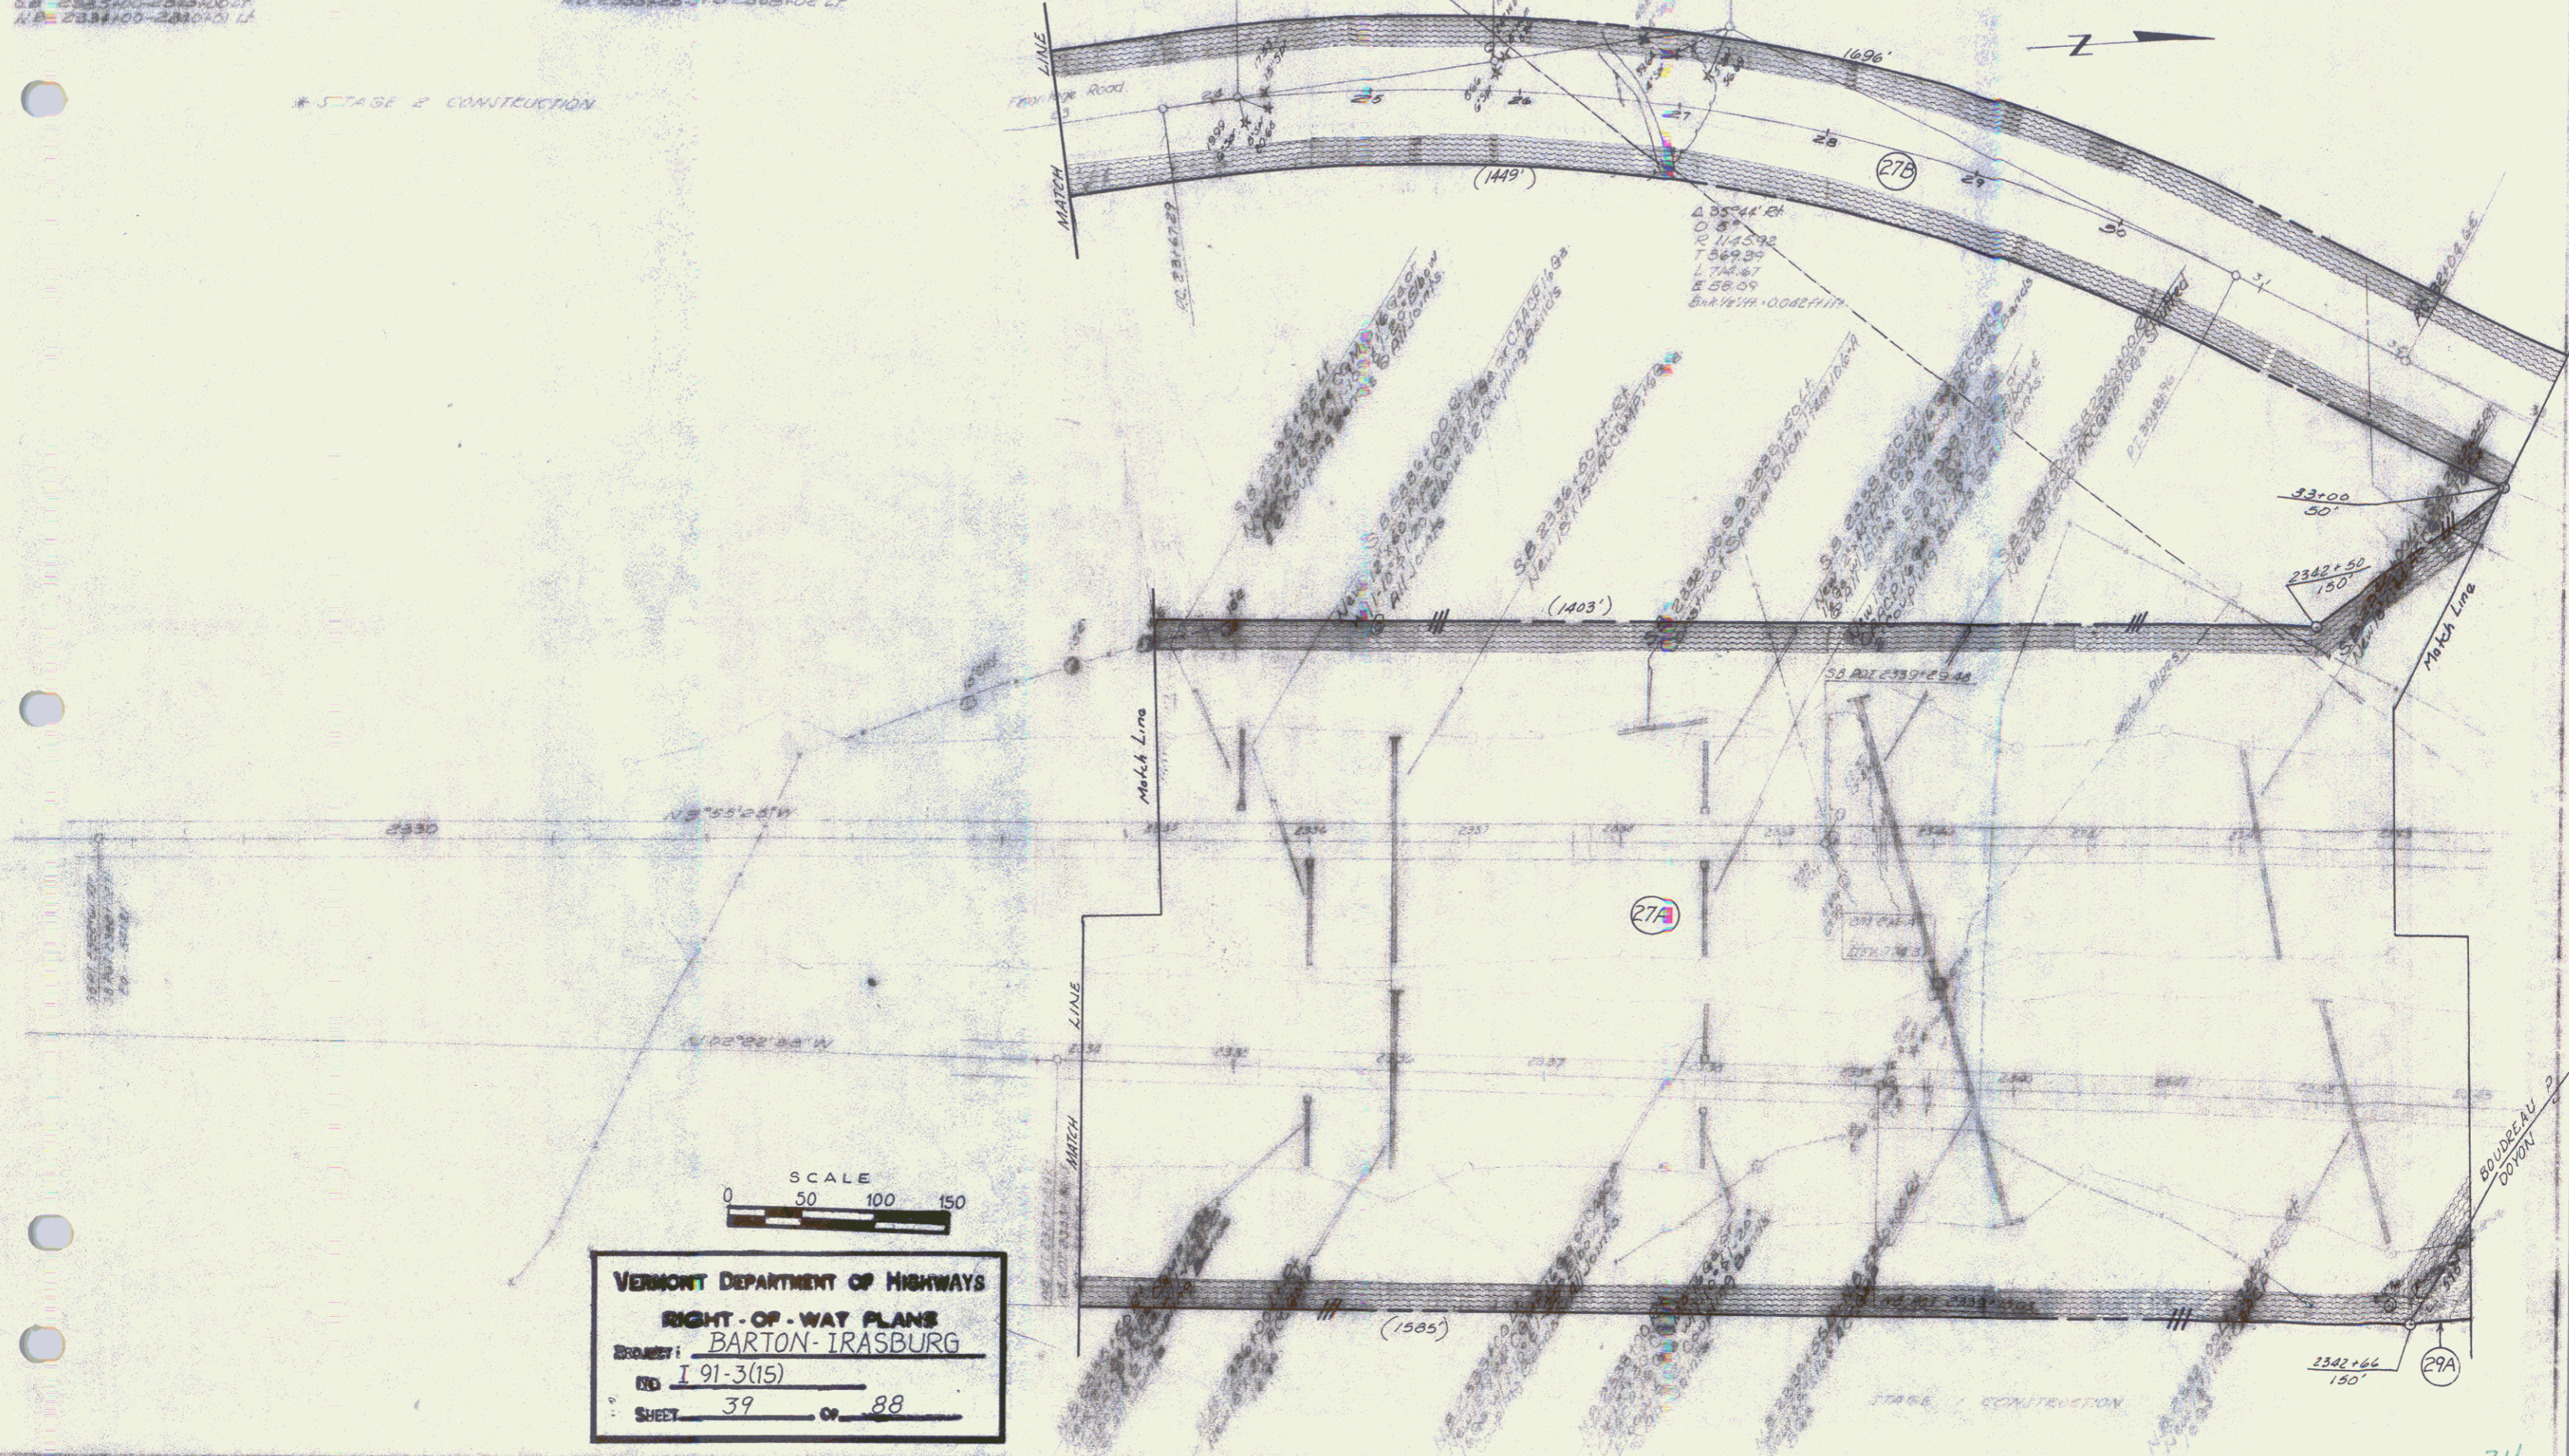

VERMONT DEPARTMENT OF HIGHWAYS
RIGHT-OF-WAY PLANS
 BOROUGH: BARTON-IRASBURG
 RD: I 91-3(15)
 SHEET: 39 OF 88

SHEET 39 34