










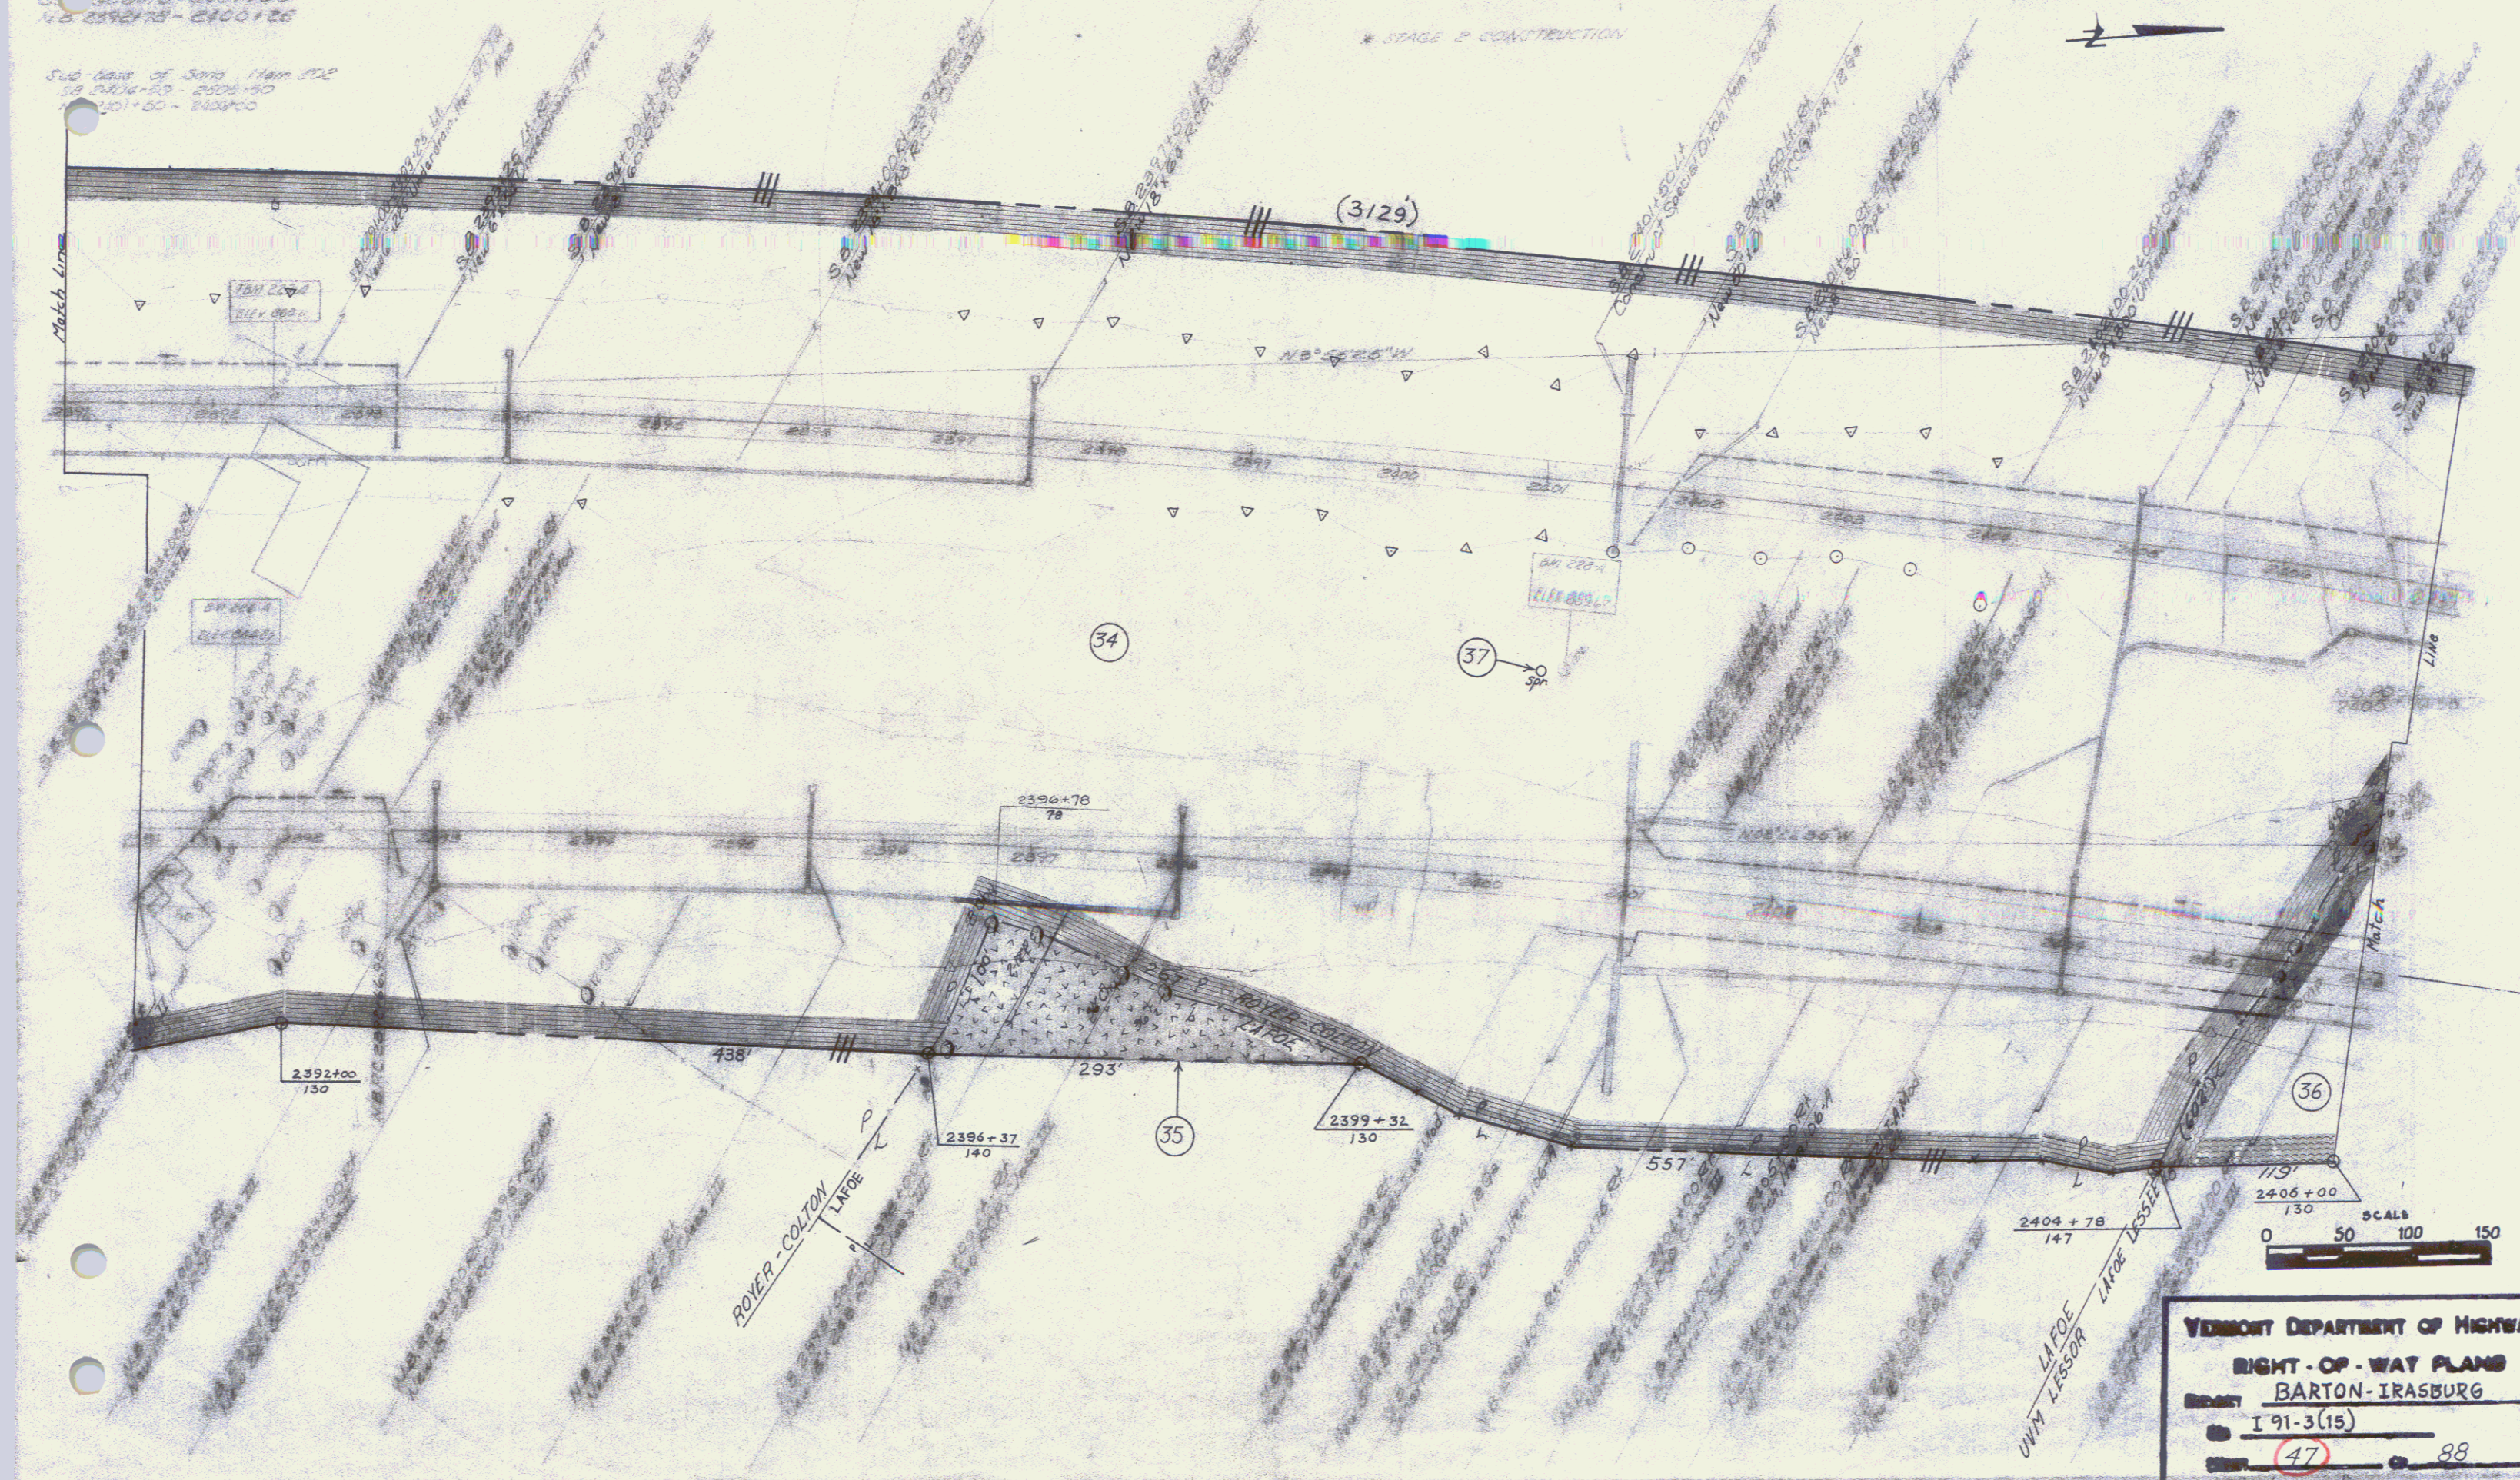

VERMONT DEPARTMENT OF HIGHWAY
RIGHT-OF-WAY PLANS
BARTON-IRASBURG
 I 91-3(15)
 47 88