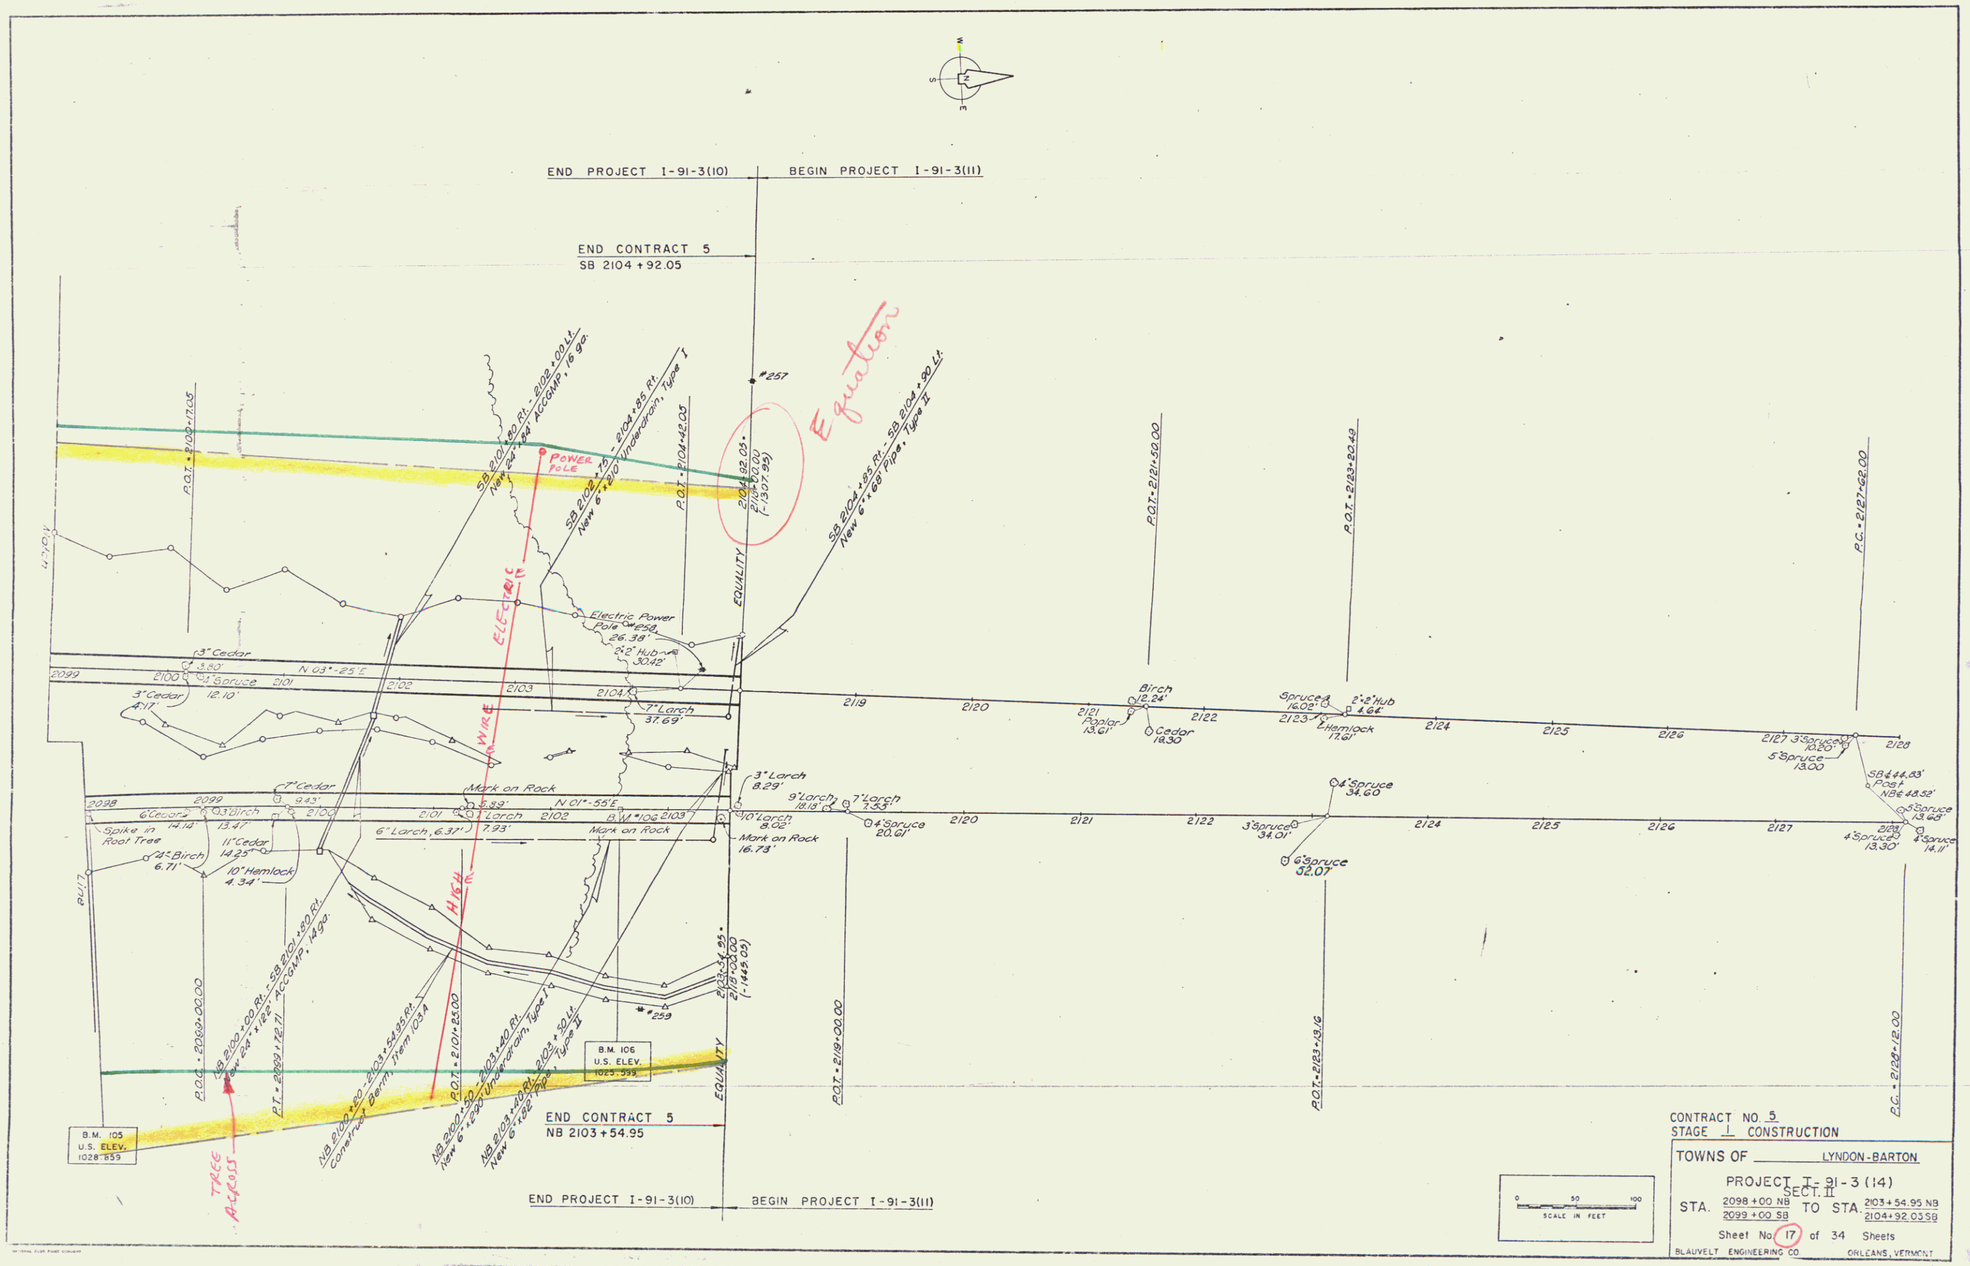
END PROJECT I-91-3(10)
BEGIN PROJECT I-91-3(11)
END CONTRACT 5
SB 2104 + 92.05
Equation
POWER POLE
ELECTRIC
WIRE
HIGH
TREE ACROSS
EQUALITY
Electric Power Pole #258
B.M. 105
U.S. ELEV. 1028.859
B.M. 106
U.S. ELEV. 1025.599
END CONTRACT 5
NB 2103 + 54.95
END PROJECT I-91-3(10)
BEGIN PROJECT I-91-3(11)
SCALE IN FEET
CONTRACT NO. 5
STAGE I CONSTRUCTION
TOWNS OF LYNDON-BARTON
PROJECT I-91-3 (14) SECT. II
STA. 2098 + 00 NB / 2099 + 00 SB TO STA. 2103 + 54.95 NB / 2104 + 92.03 SB
Sheet No. 17 of 34 Sheets
BLAUVELT ENGINEERING CO.
ORLEANS, VERMONT
PLAN
MAY 9 1974
52