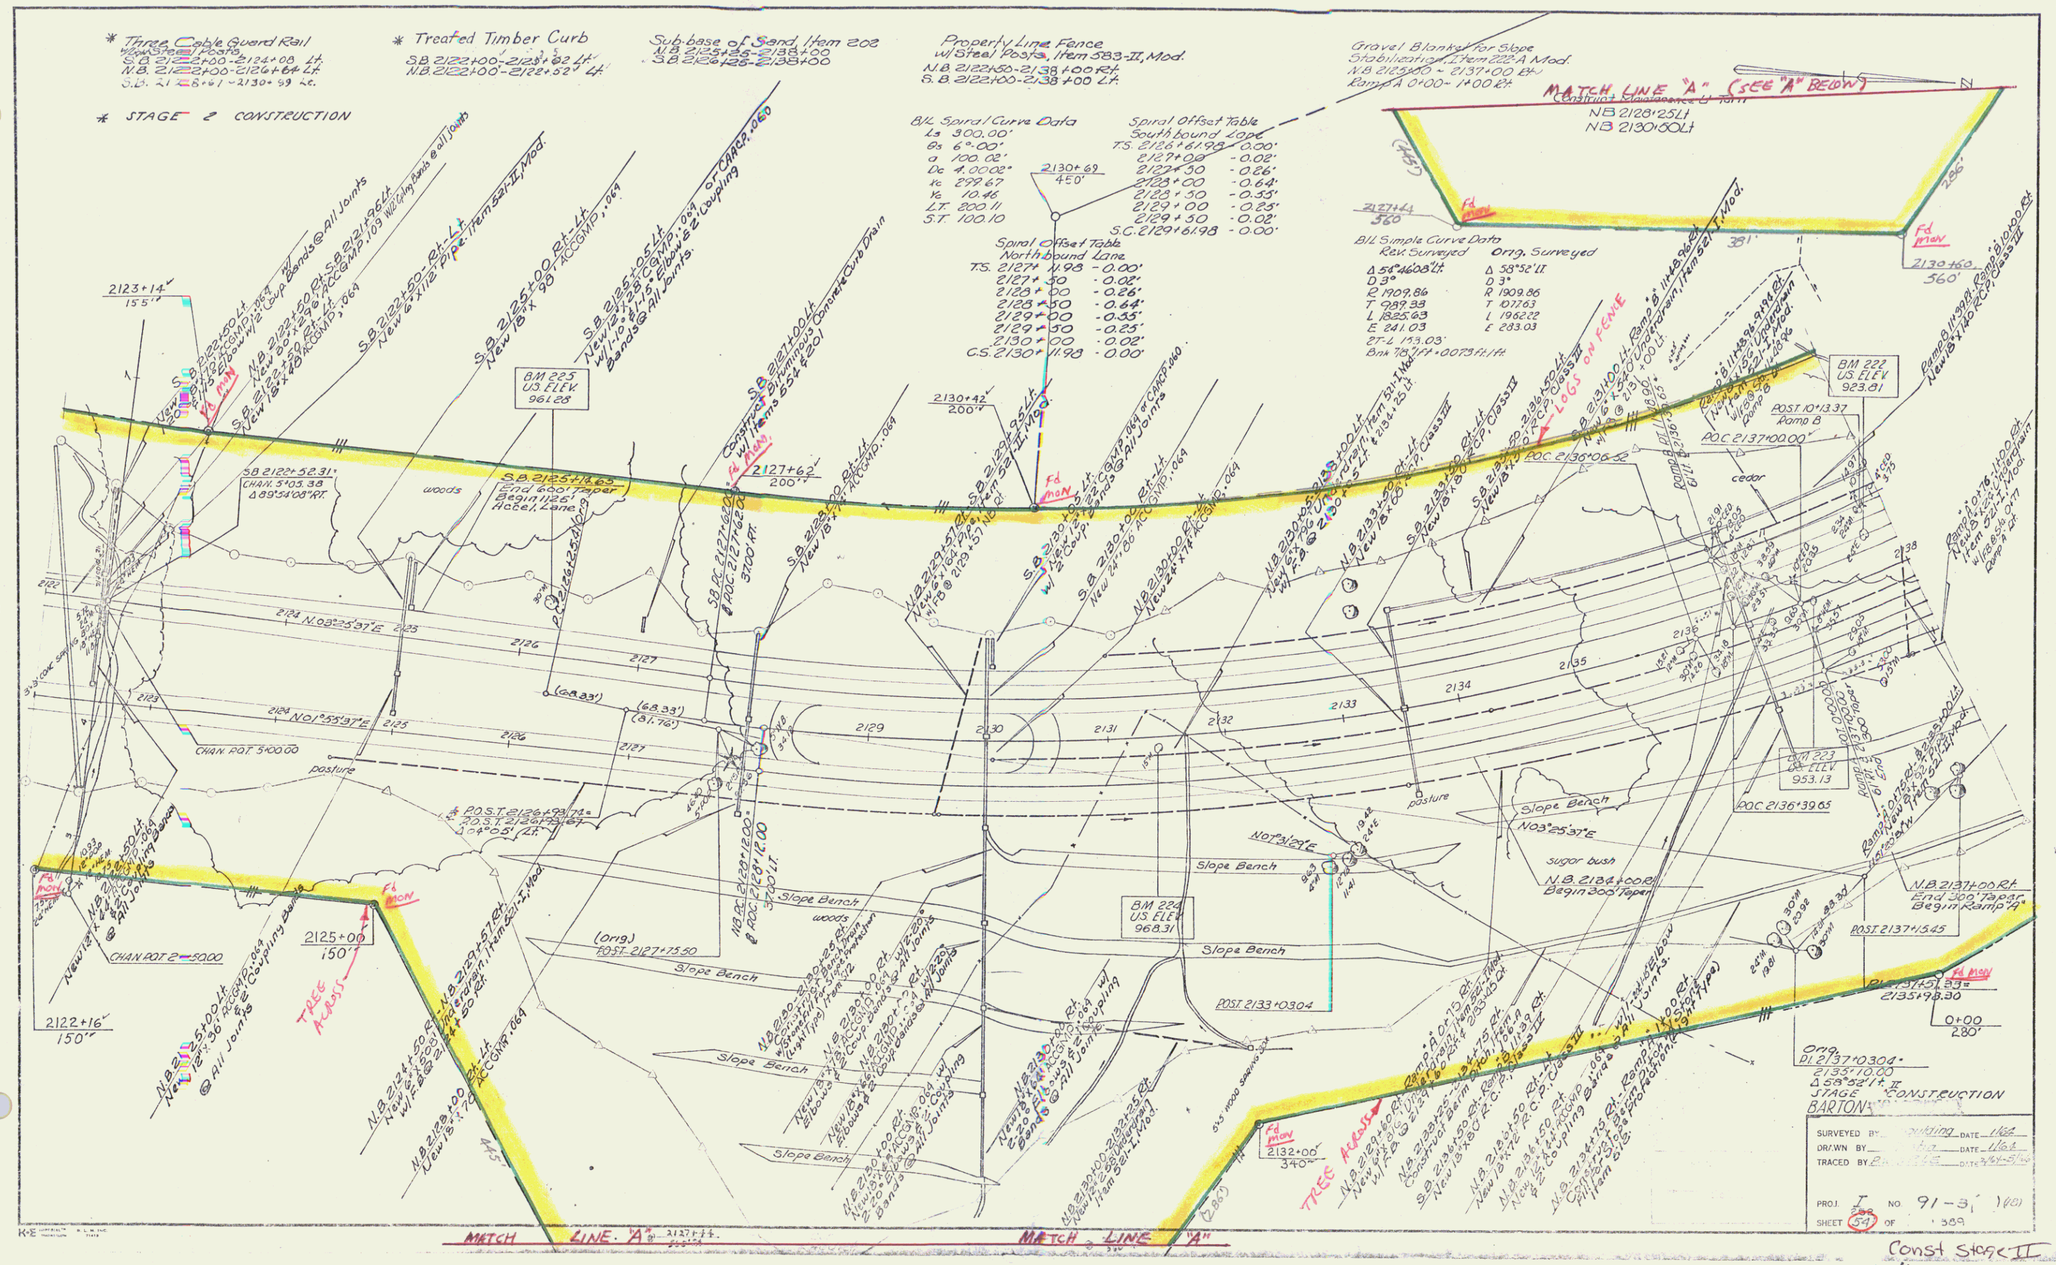
* Three Cable Guard Rail
* Treated Timber Curb
Sub-base of Sand, Item 208
Property Line Fence
Gravel Blanket for Slope Stabilization, Item 222-A Mod.
* STAGE 2 CONSTRUCTION
MATCH LINE "A" (SEE "A" BELOW)
B/L Spiral Curve Data
Spiral Offset Table
B/L Simple Curve Data
BM 225 US ELEV 961.28
BM 224 US ELEV 968.31
BM 223 US ELEV 953.13
BM 222 US ELEV 923.81
A-LOGS ON FENCE
TREE ACCESS
Slope Bench
pasture
woods
cedar
sugar bush
MATCH LINE "A"
STAGE CONSTRUCTION
SURVEYED BY
DR/WN BY
TRACED BY
PROJ. NO. 91-3
SHEET 54 OF 389
Const Stage II
54 JUL 11