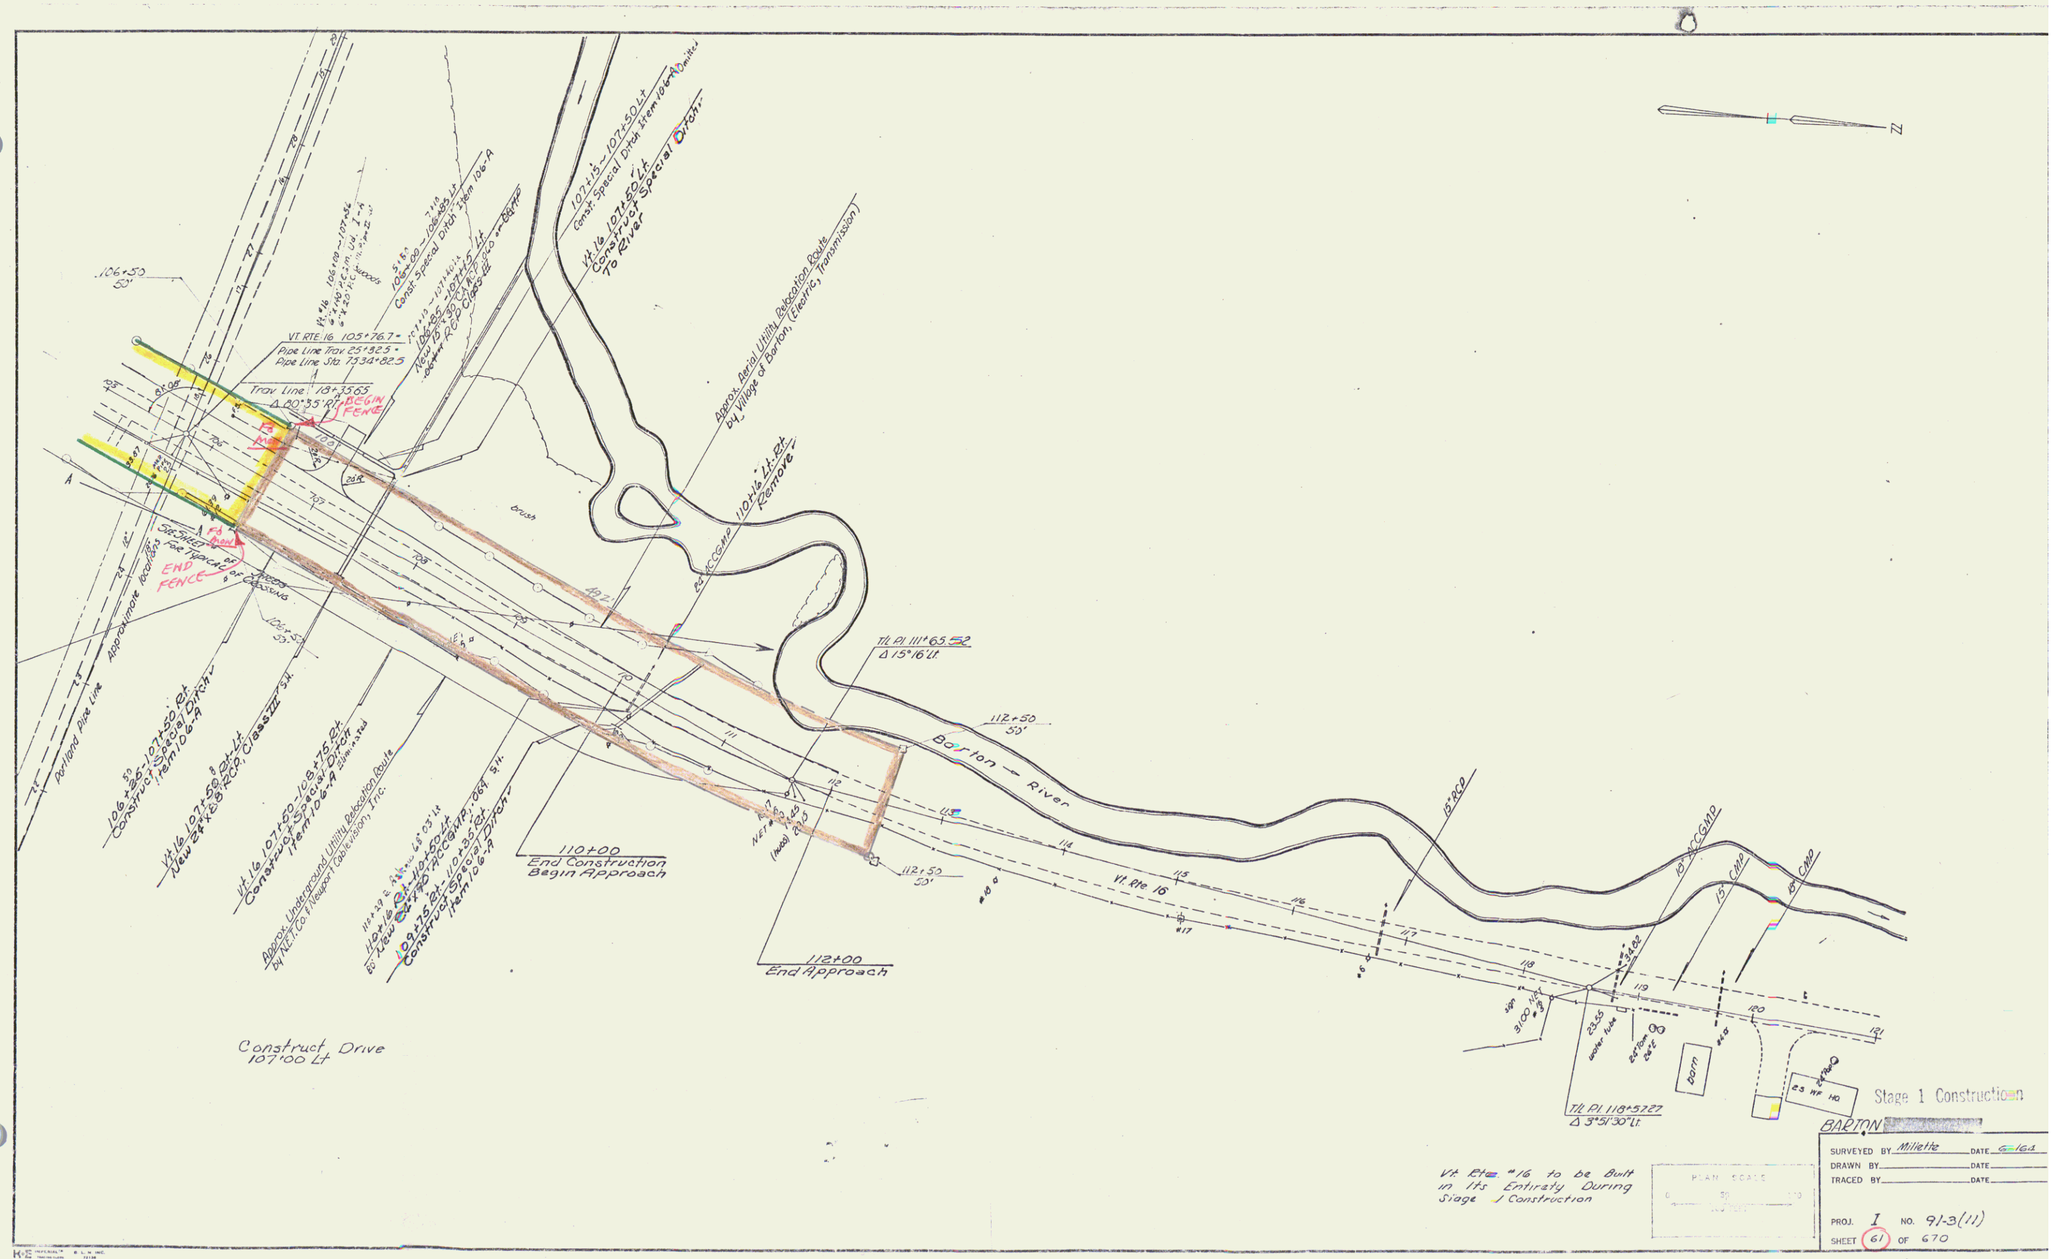
N
Vt. Rte. 16 105+76.7±
Pipe Line Trav 85+92.5±
Pipe Line Sta. 73+34.82.5
Trav. Line 13+35.65
Δ 20°35' Rt.
BEGIN FENCE
END FENCE
Approximate Rod Line
Portland Pipe Line
Approx. Aerial Utility Relocation Poles by Village of Barton, (Electric, Transmission)
Vt. Rte. 16
Barton River
T/L Pi 111+65.52
Δ 15°16' Lt.
112+50
50'
110+00
End Construction
Begin Approach
112+00
End Approach
Construct Drive
107+00 Lt
T/L Pi 118+57.27
Δ 3°51'30" Lt.
barn
Stage 1 Construction
BARTON
SURVEYED BY Milette
DATE 6-16-6
DRAWN BY
DATE
TRACED BY
DATE
PROJ. I NO. 91-3(11)
SHEET 61 OF 670
Vt. Rte. 16 to be Built in its Entirety During Stage 1 Construction
PLAN SCALE
JUL 11 1974
57