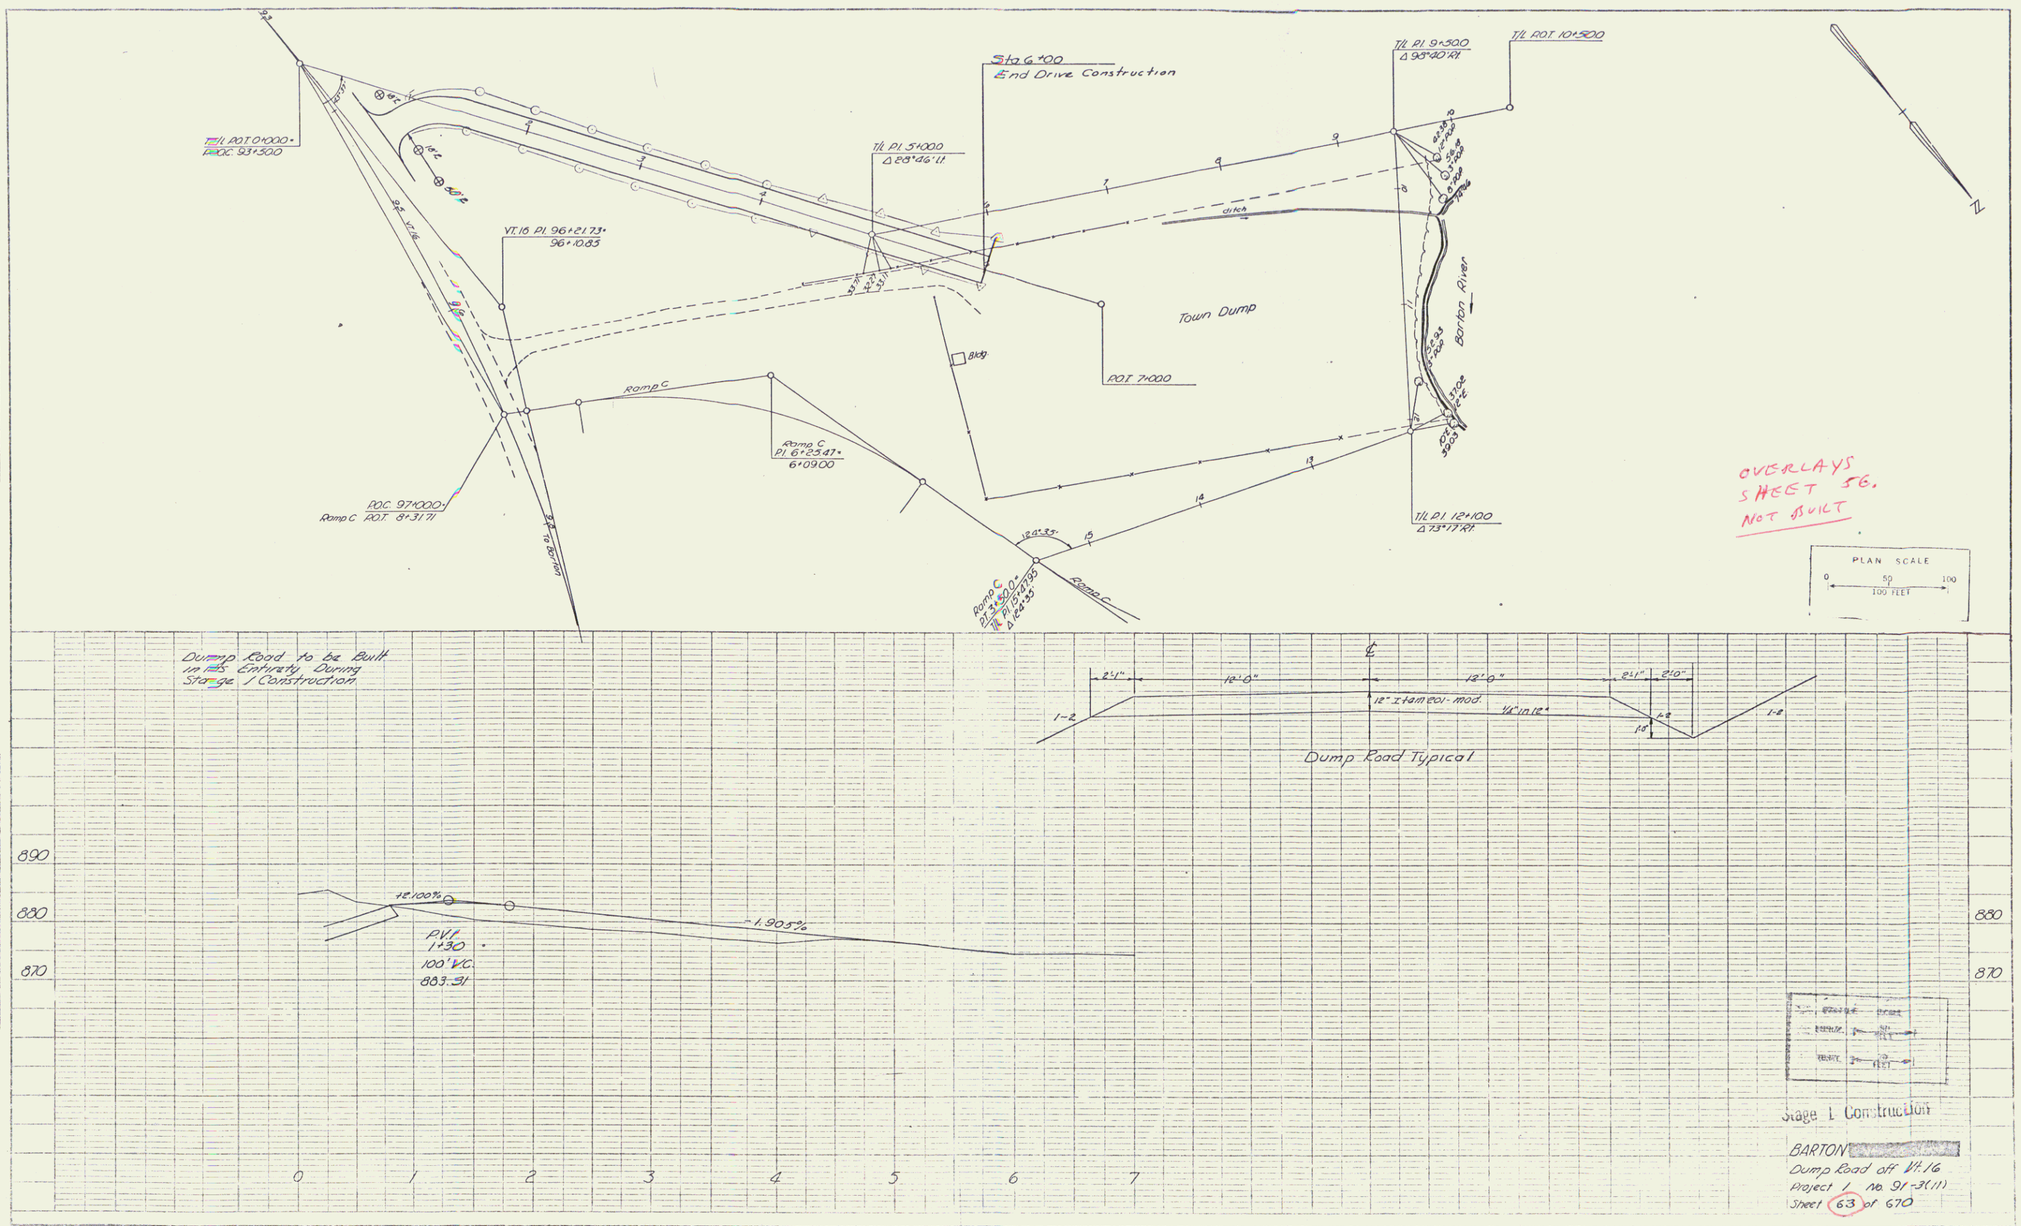
T/L P.O.T. 0+000±
P.O.C. 93+500
T/L P.I. 5+000
Δ 28°46'11"
Sta 6+00
End Drive Construction
T/L P.I. 9+500
Δ 93°40'Rt.
T/L P.O.T. 10+500
VT.16 P.I. 96+21.73±
96+10.85
Town Dump
Bldg
P.O.T. 7+000
Barton River
ditch
Ramp C
Ramp C
P.I. 6+25.47±
6+09.00
P.O.C. 97+000±
Ramp C P.O.T. 8+31.71
Ramp C
P.I. 3+50.0±
P.I. 3+47.90
Δ 12°35'
T/L P.I. 12+100
Δ 73°17'Rt.
OVERLAYS
SHEET 56.
NOT BUILT
PLAN SCALE
0 50 100
100 FEET
Dump Road to be Built in its Entirety During Stage 1 Construction
12°-0"
12°-0"
12" Ξ tamped-mod.
1½" in 12"
Dump Road Typical
890
880
870
+2.100%
-1.905%
PVI
1+30
100' V.C.
883.31
0
1
2
3
4
5
6
7
Stage 1 Construction
BARTON
Dump Road off VT.16
Project 1 No. 91-3(11)
Sheet 63 of 670
JUL 11 1974
58