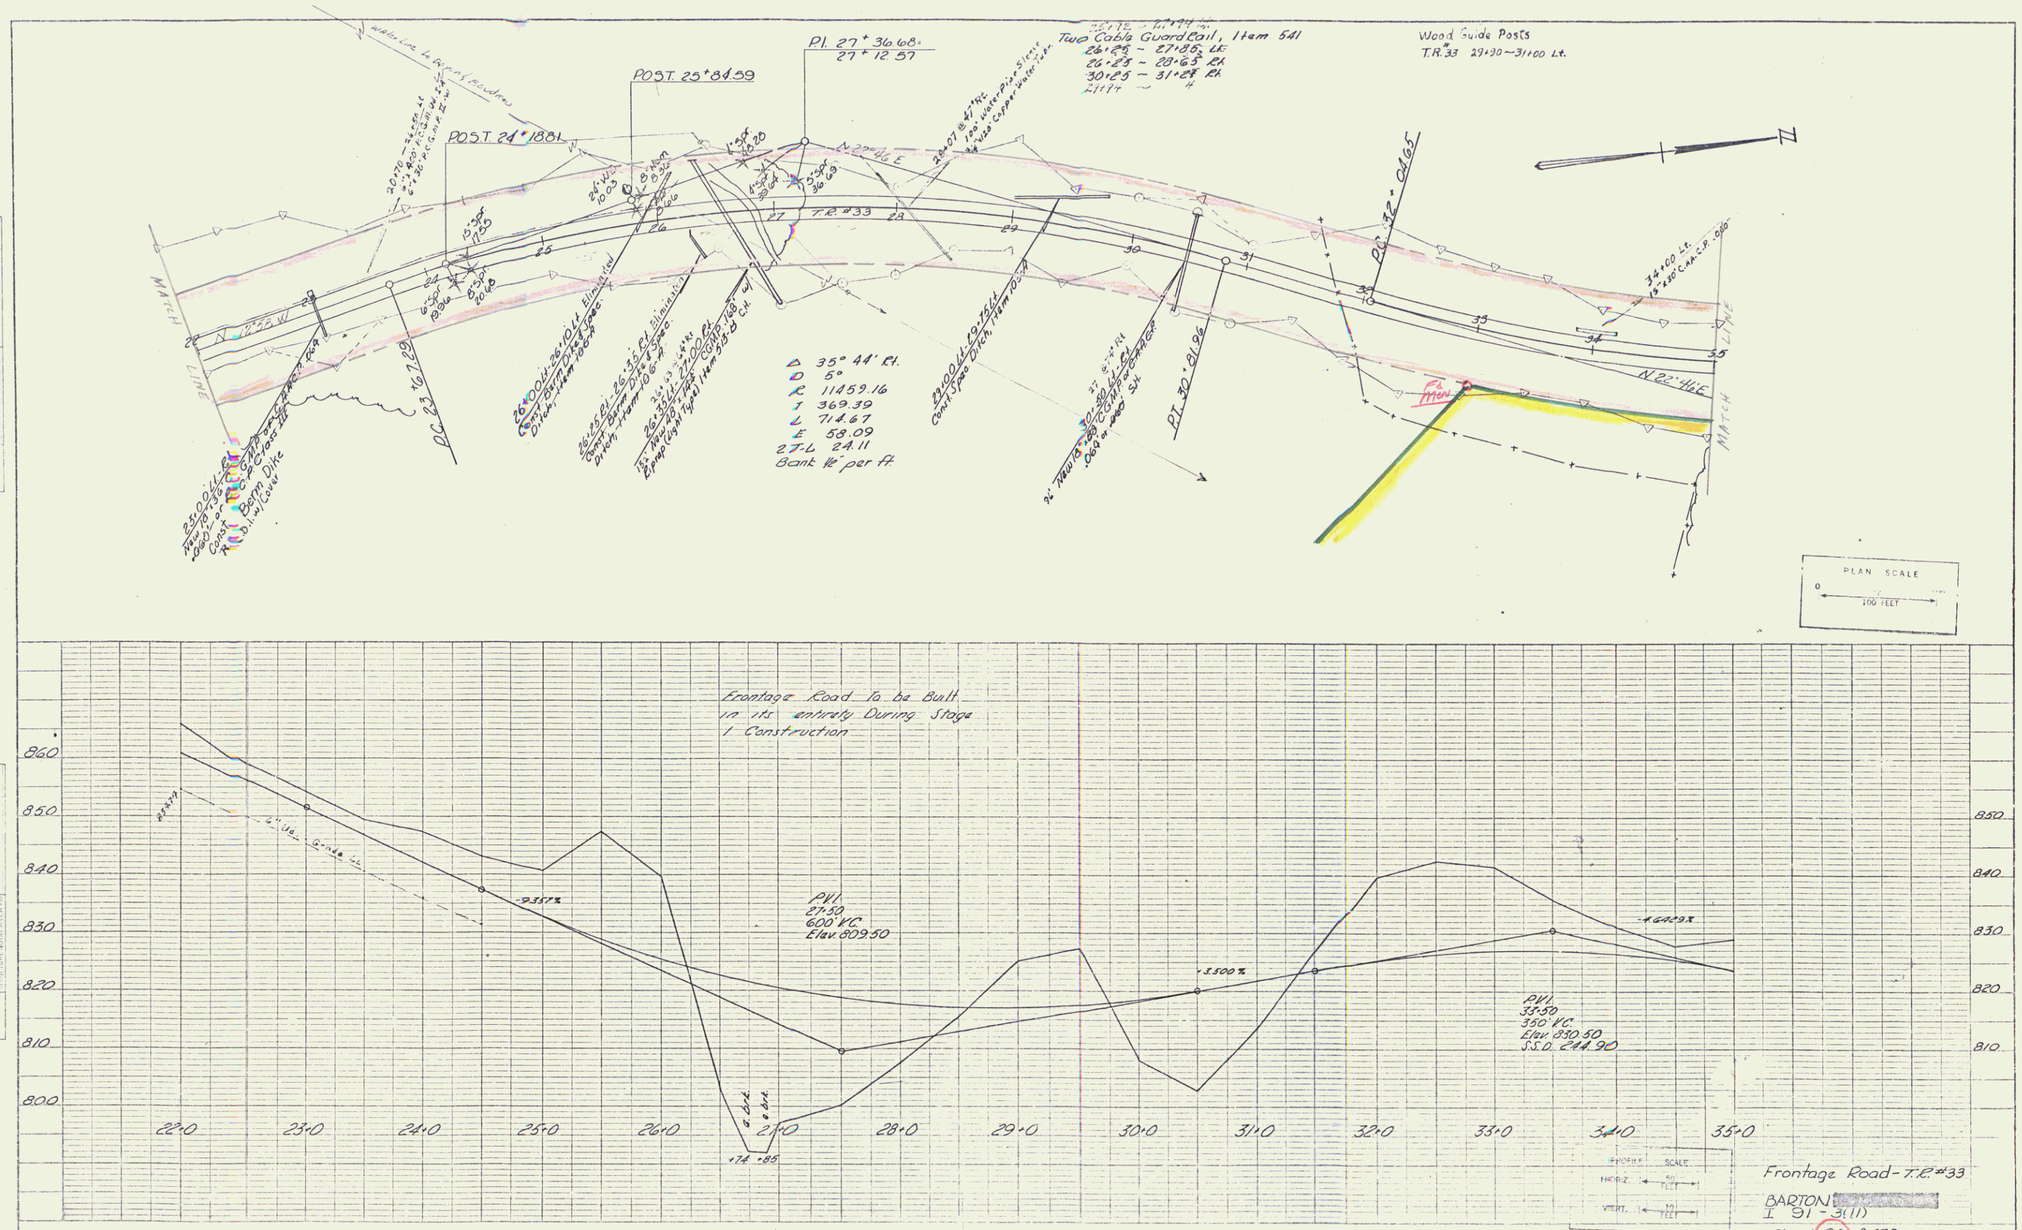

75

JUL 11 1974