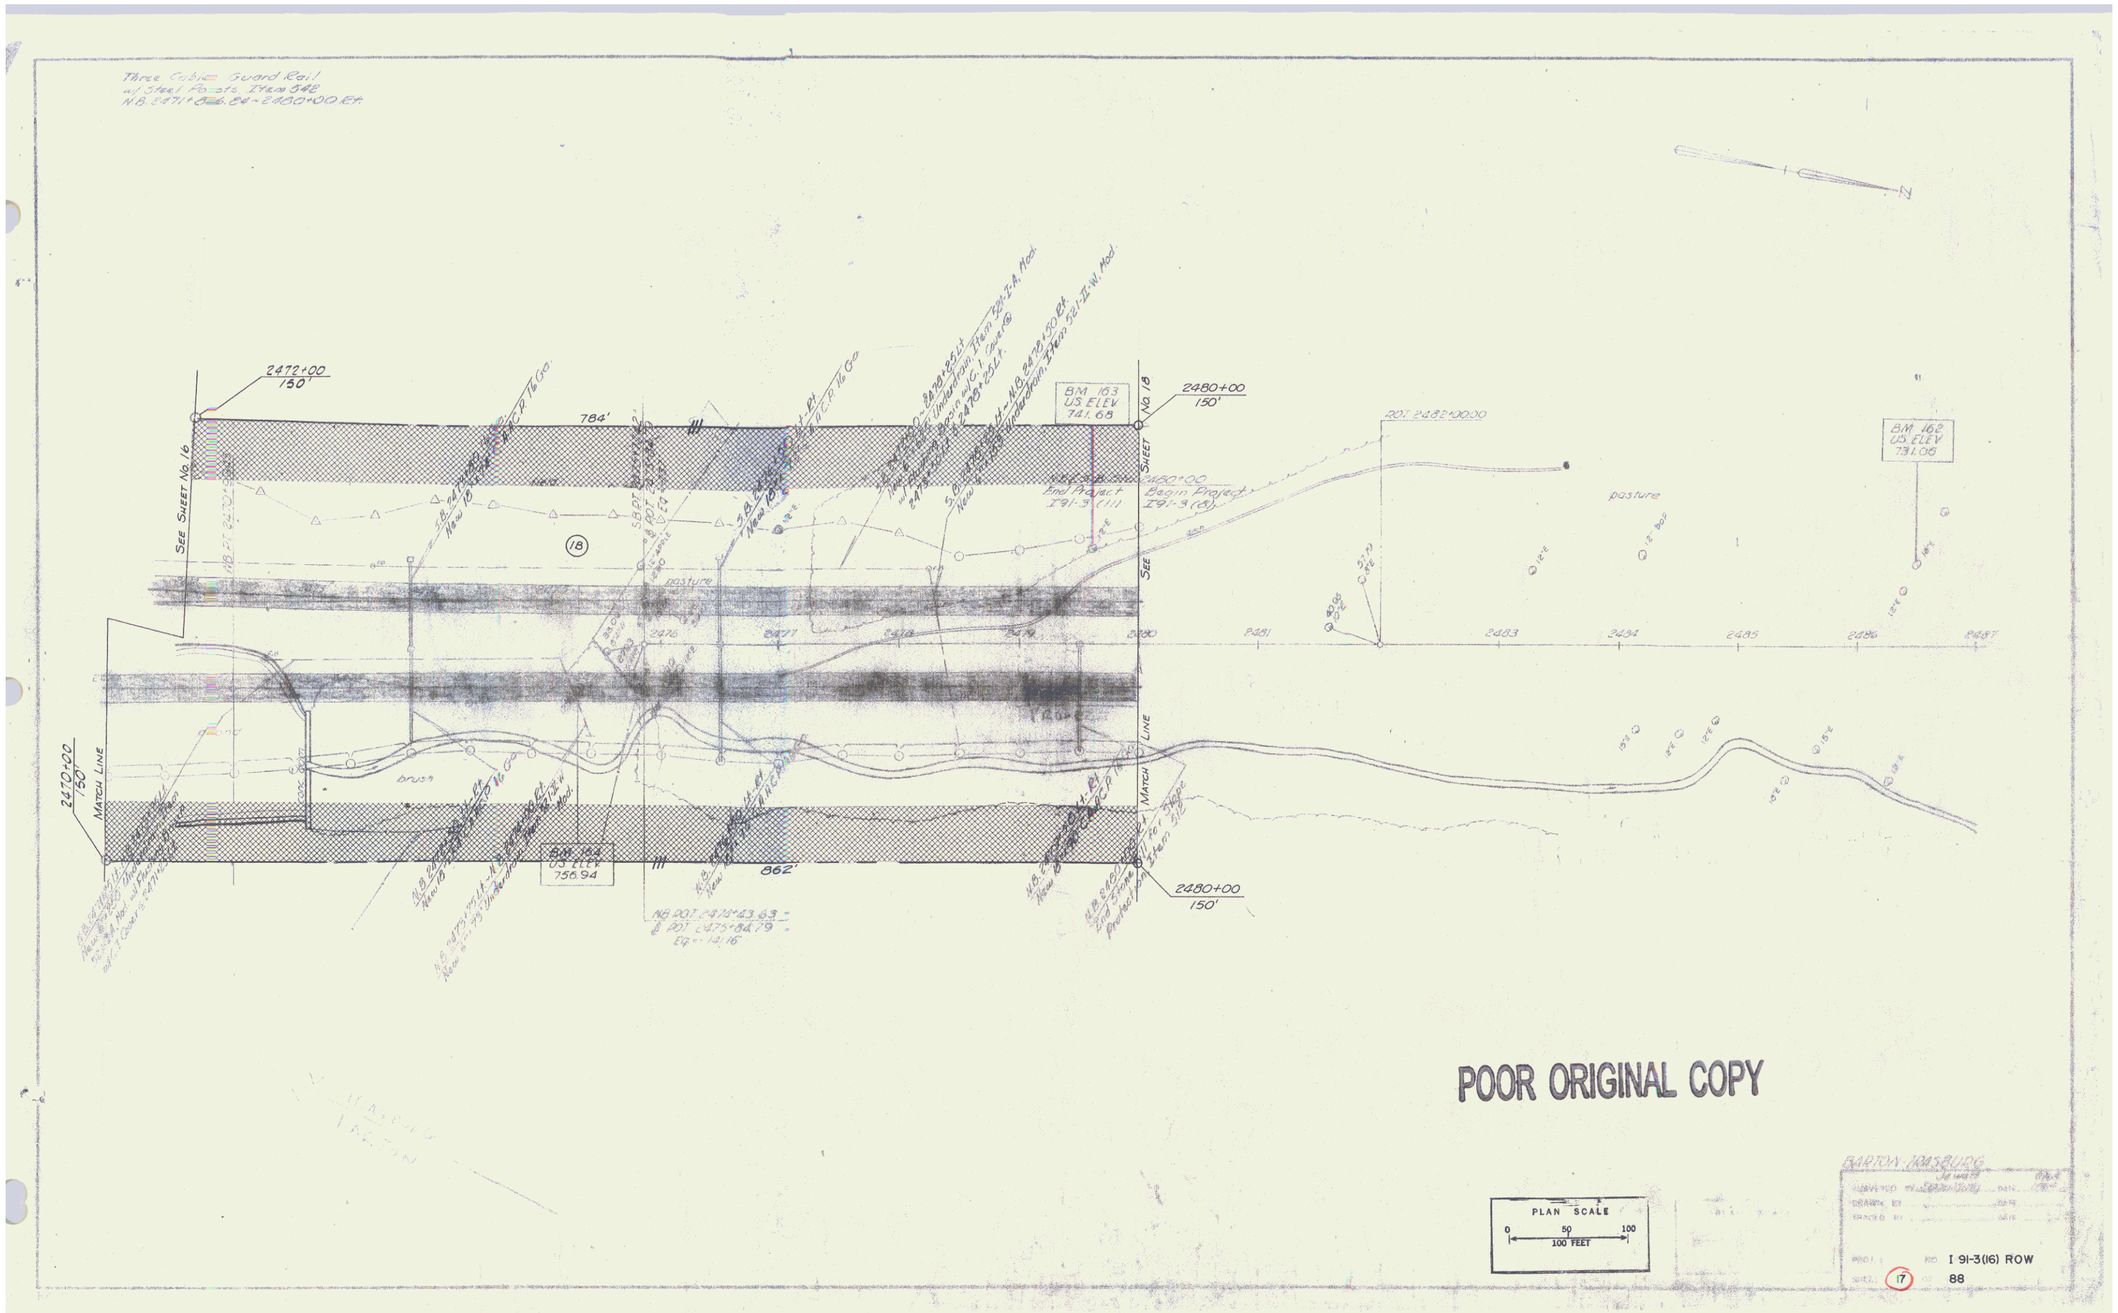
Three Cable Guard Rail
w/ Steel Posts Item 948
N.B. 2471+86.88 - 2480+00 Rt.
2472+00
150'
784'
BM 163
US ELEV
741.68
2480+00
150'
SEE SHEET No. 16
SEE SHEET No. 18
End Project
I91-3 (11)
Begin Project
I91-3 (8)
pasture
brush
2470+00
150'
MATCH LINE
BM 164
US ELEV
750.94
862'
2480+00
150'
BM 162
US ELEV
731.06
2476
2477
2478
2479
2480
2481
2483
2484
2485
2486
2487
POOR ORIGINAL COPY
PLAN SCALE
0
50
100
100 FEET
BARTON-MASLUPG
I 91-3(16) ROW
17
88

16