NOTE: THIS PLAN IS FOR GENERAL LAYOUT OF PROPOSED RIGHT OF WAY ACQUISITION AREAS AND IS NOT FOR RECORDING PURPOSES. A FINAL PERIMETER SURVEY MAP PREPARED BY A LICENSED SURVEYOR WILL BE REQUIRED FOR DEEDING PURPOSES.

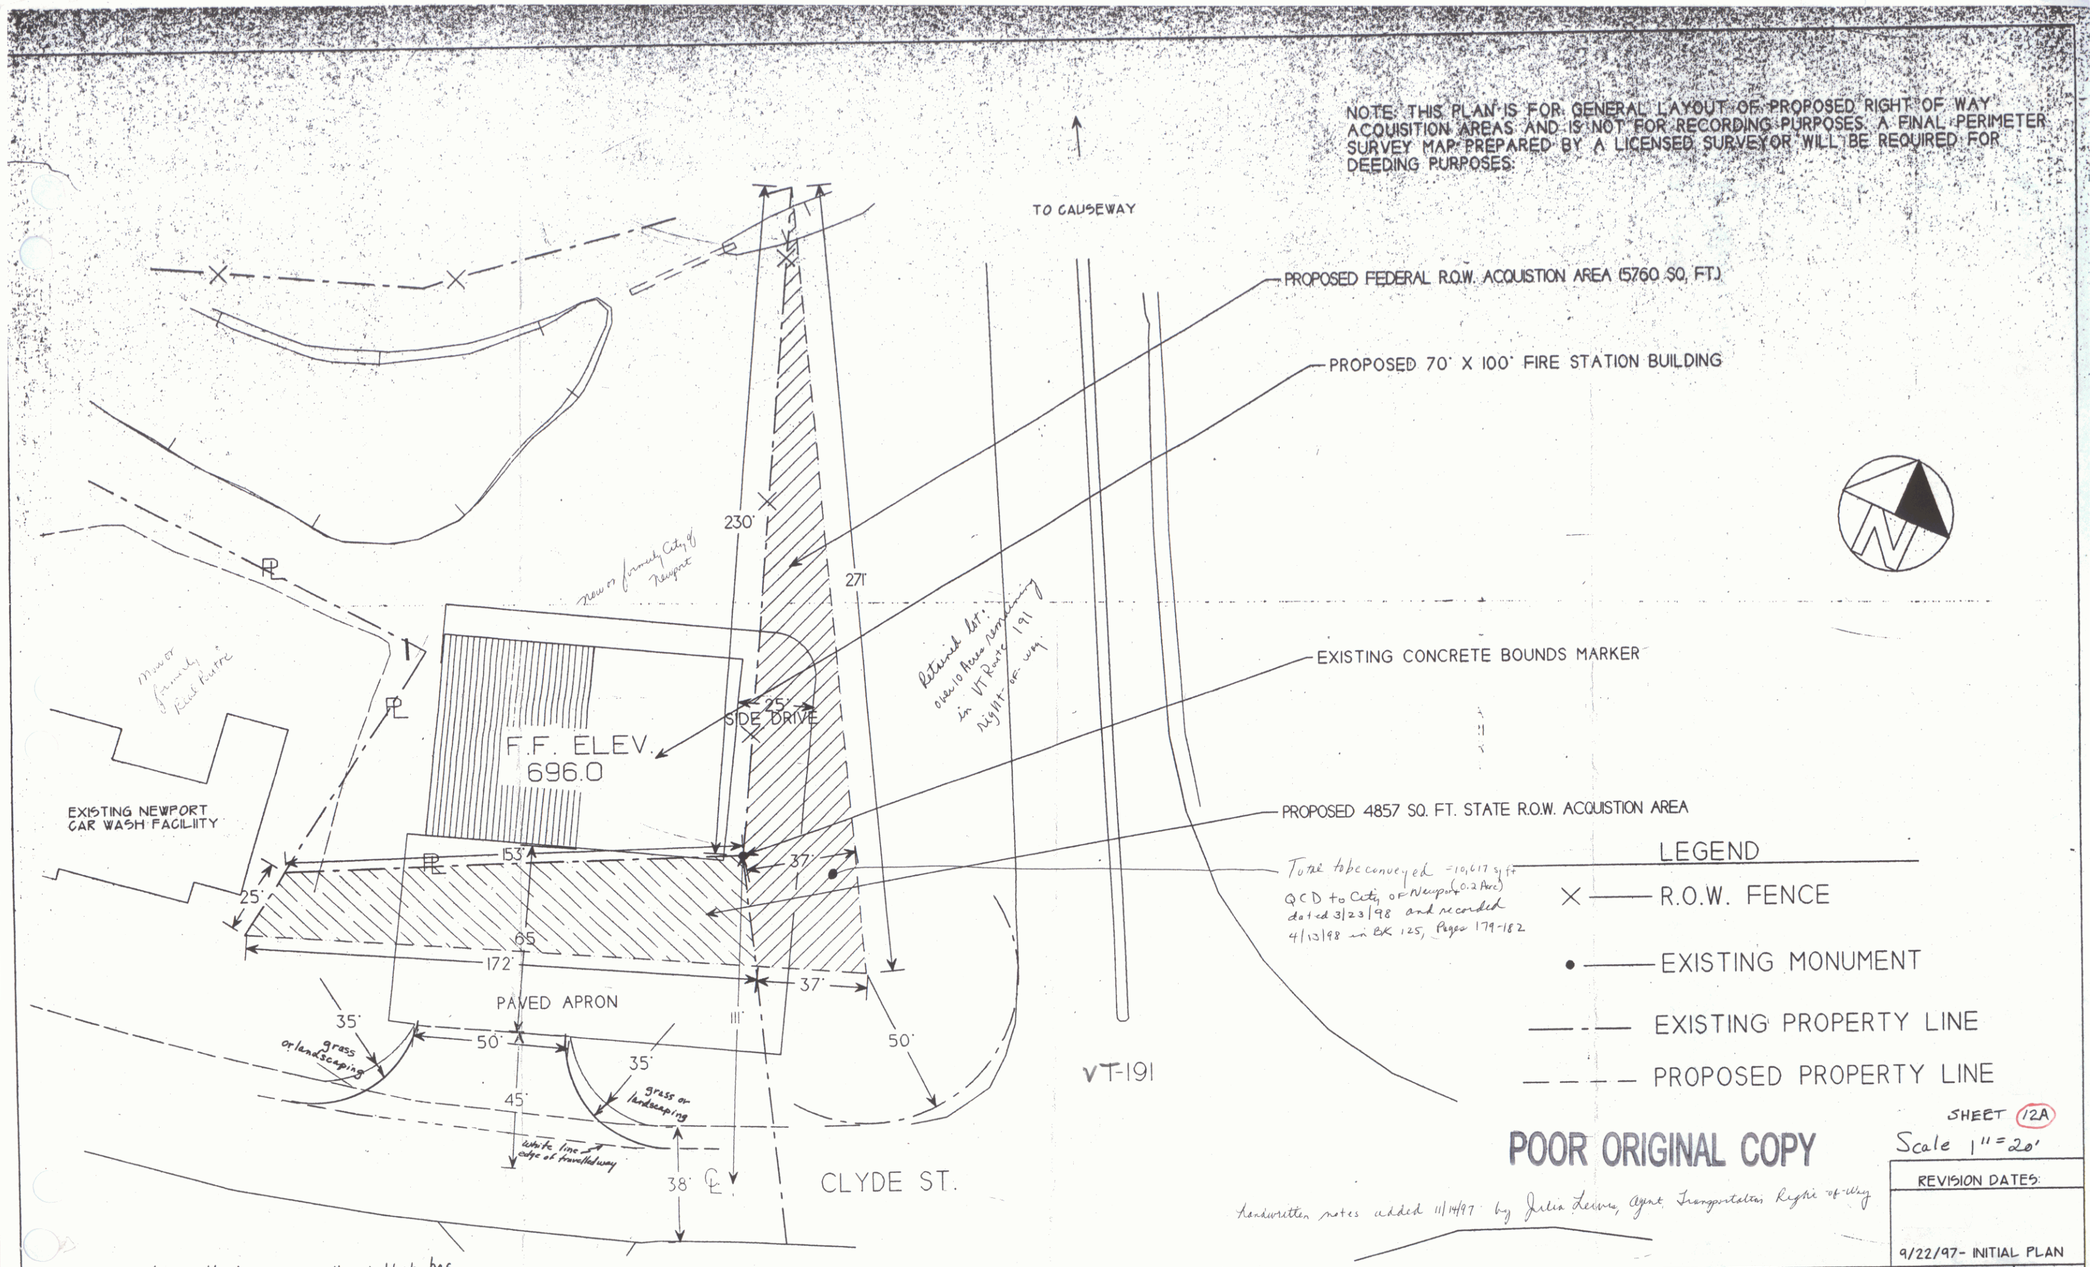

POOR ORIGINAL COPY

Handwritten notes added 11/14/97 by Julia Lewis, Agent Transportation Right-of-Way

SHEET 12A

Scale 1" = 20'

REVISION DATES:

9/22/97- INITIAL PLAN

REVISIONS			
NO.	DESCRIPTION	DATE	BY
1	AMEND TO 45 FT. CTR-LINE SETBACK	10-09-97	S.M.P.

David A. Lawes Engineering, Inc.
P.O. BOX 448 ---- Derby, Vermont

PREPARED FOR:

NEWPORT FIRE STATION
R.O.W. ACQUISITION PLAN
CLYDE ST. NEWPORT CITY, VERMONT

Date: SEPT. 19, 1997
Scale: AS SHOWN
Drawn By: D.A.L.
Checked By: D.A.L.
DRWG. NO. S1

8