PROPERTY LINE FENCE
W/ STEEL POSTS ITEM 233-B
3218+00 - 3233+00 Lt
3229+45 - 3233+00 Rt

DRILLING & BLASTING of SOLID ROCK SUBGRADE ITEM 112, MOD.
3217+25 - 3221+39
3221+80 - 3227+70
3231+85 - 3234+00

THREE CABLE GUARD RAIL with STEEL POSTS
3227+56 Lt. - 3231+88 Lt.
3227+54 Rt. - 3231+54 Rt.
3228+50 Rt. - 3230+27 Rt.
3228+70 Lt. - 3229+70 Lt.

DEMOLITION & REMOVAL OF BUILDING ITEM 518G
3226+70 Lt. (2)

BASE LINE		NORTHBOUND		SOUTHBOUND	
Δ	42° 41' Lt.	Δ	41° 23' 15" 41° 23' 54" Lt.	Δ	41° 03' 48" Lt.
D	1° 30'	D	2° 00'	D	2° 30'
R	3819.72	R	2864.79	R	2291.83
T	1492.45	T	1083.47 1088.09	T	858.32
L	2845.55	L	2069.92 2071.04	L	1642.53
E	281.21	E	197.69	E	155.45
		Bank	3/16" per ft.	Bank	3/16" per ft.

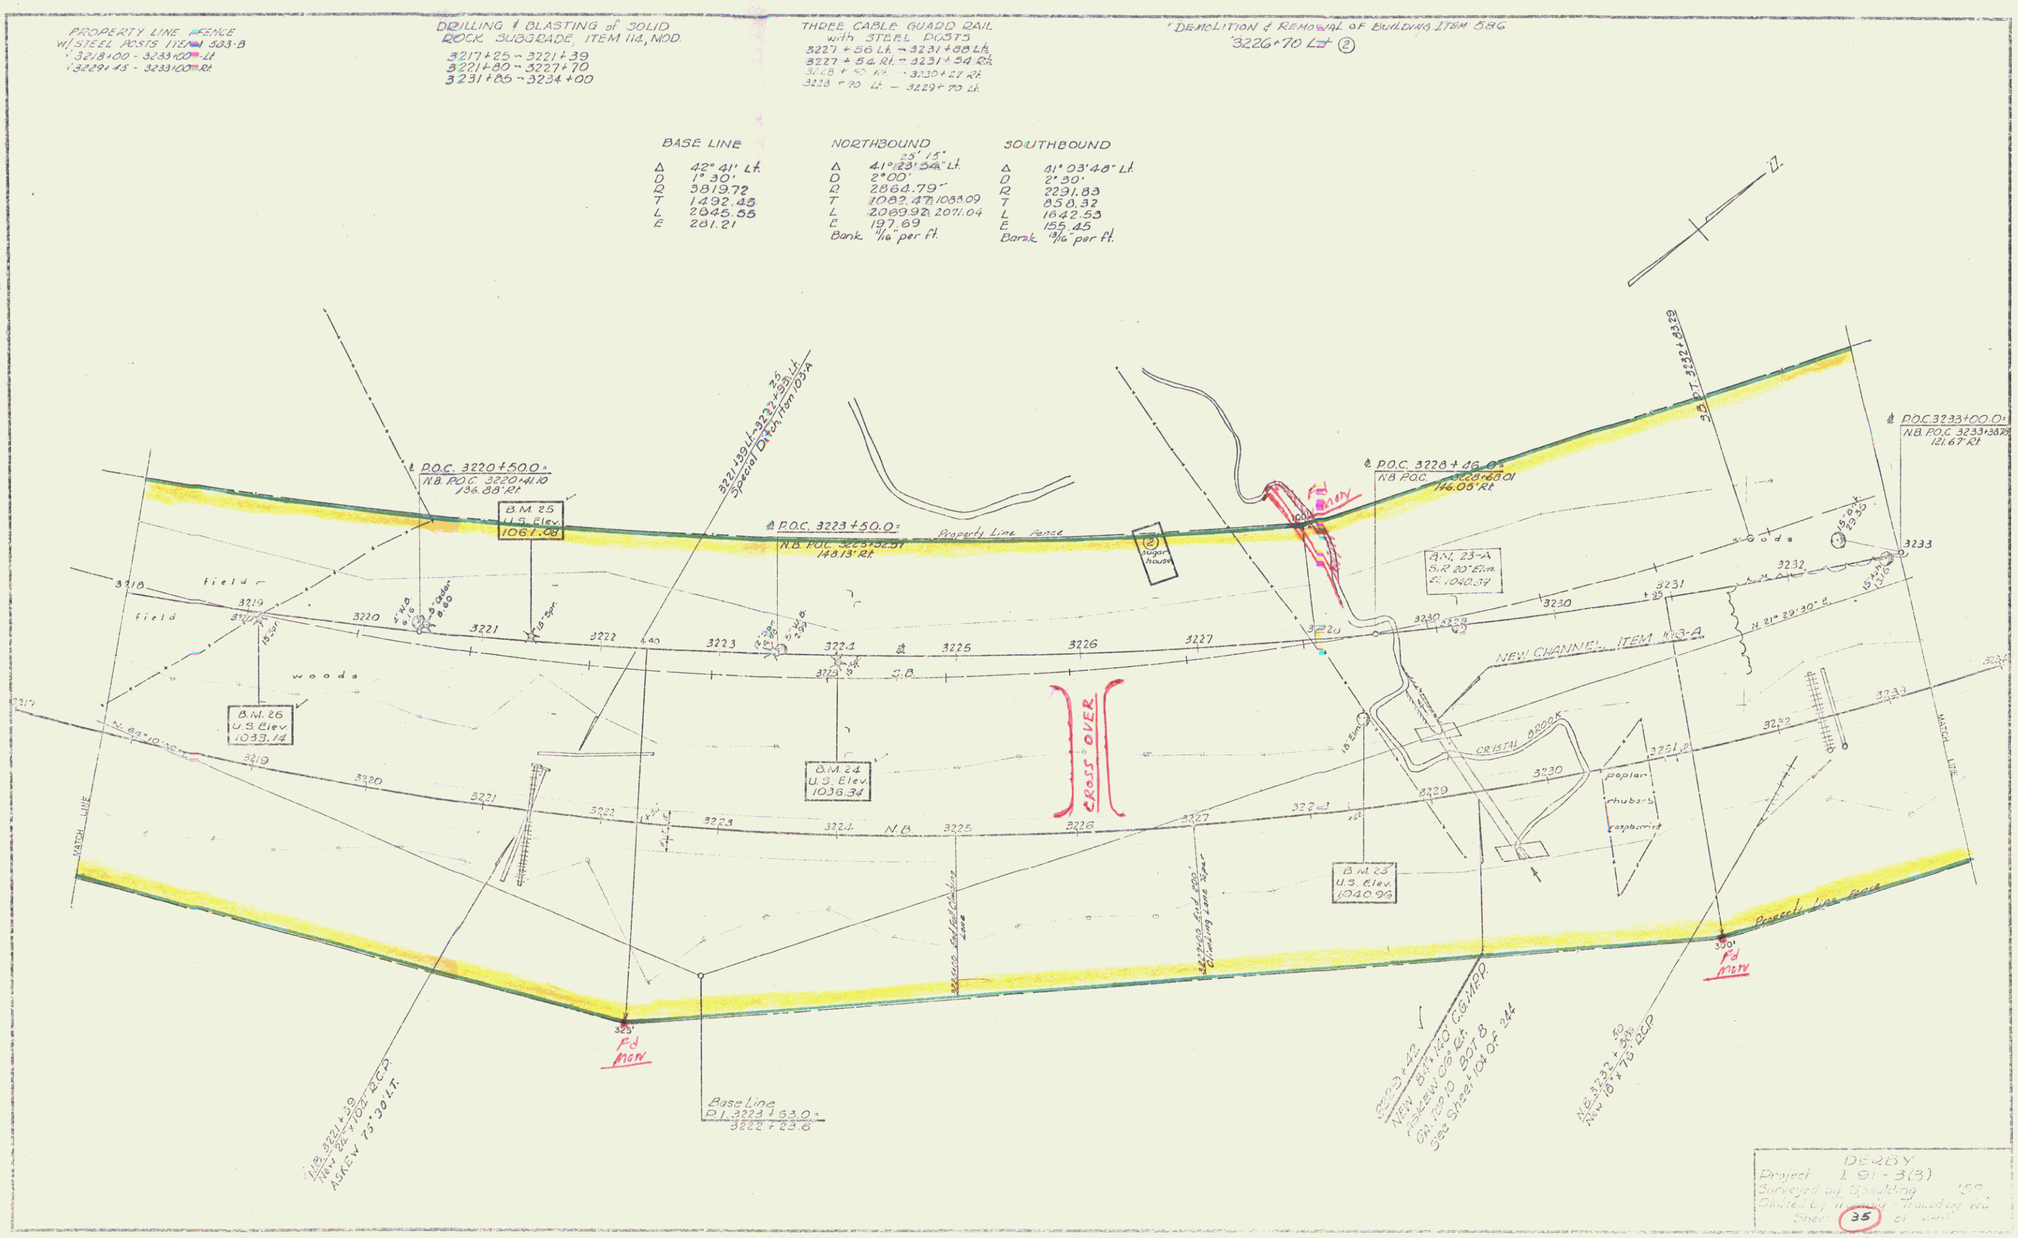

DERBY
Project I 91-3(3)
Surveyed by Spalding
Plotted by
Sheet 35 of

35

JUL 11 1974

19