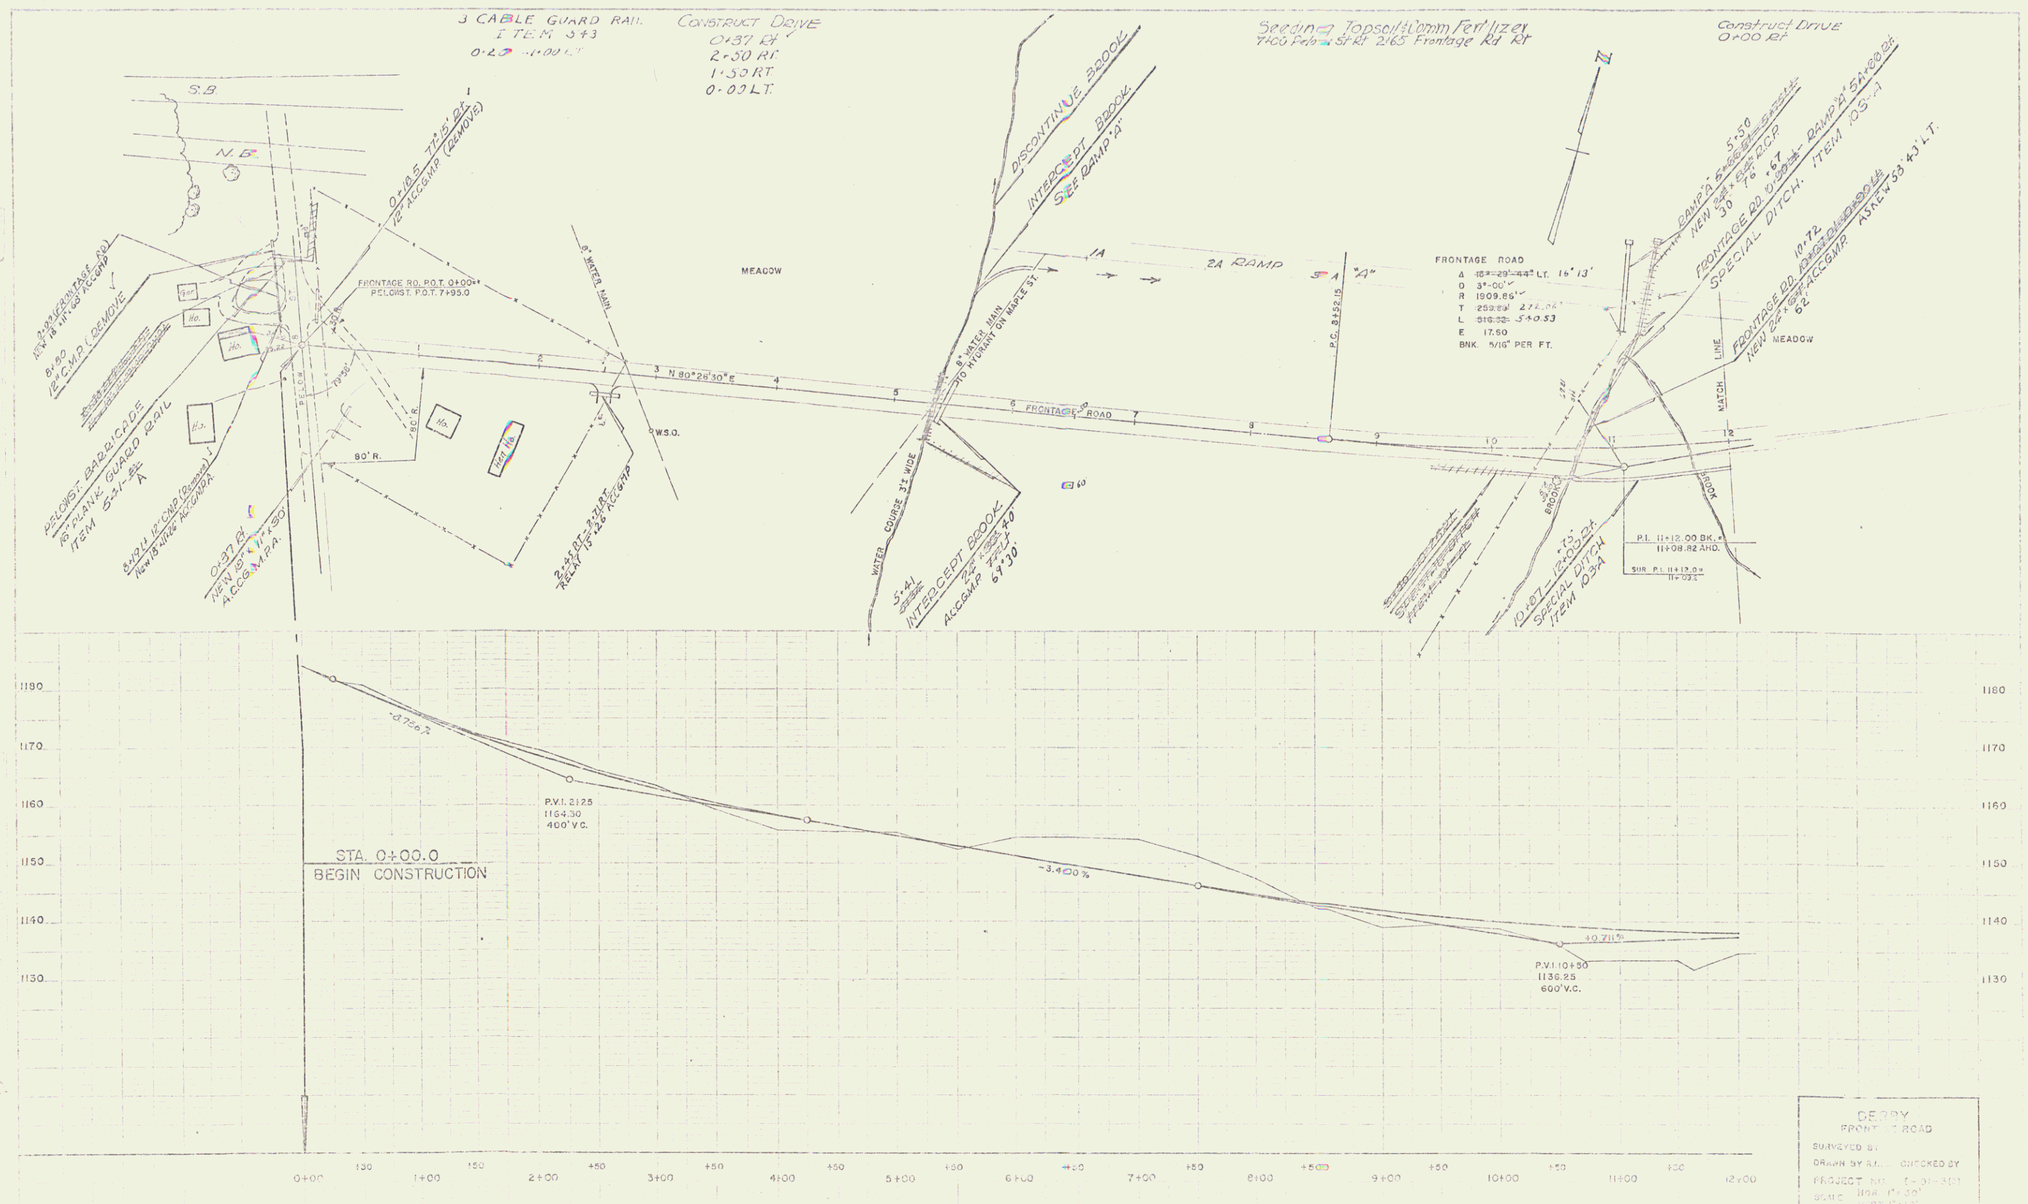

DERBY
FRONTAGE ROAD
SURVEYED BY
DRAWN BY R.M. CHECKED BY
PROJECT NO.
SCALE 1"=50'
SHEET 48

JUL 11 1974

26