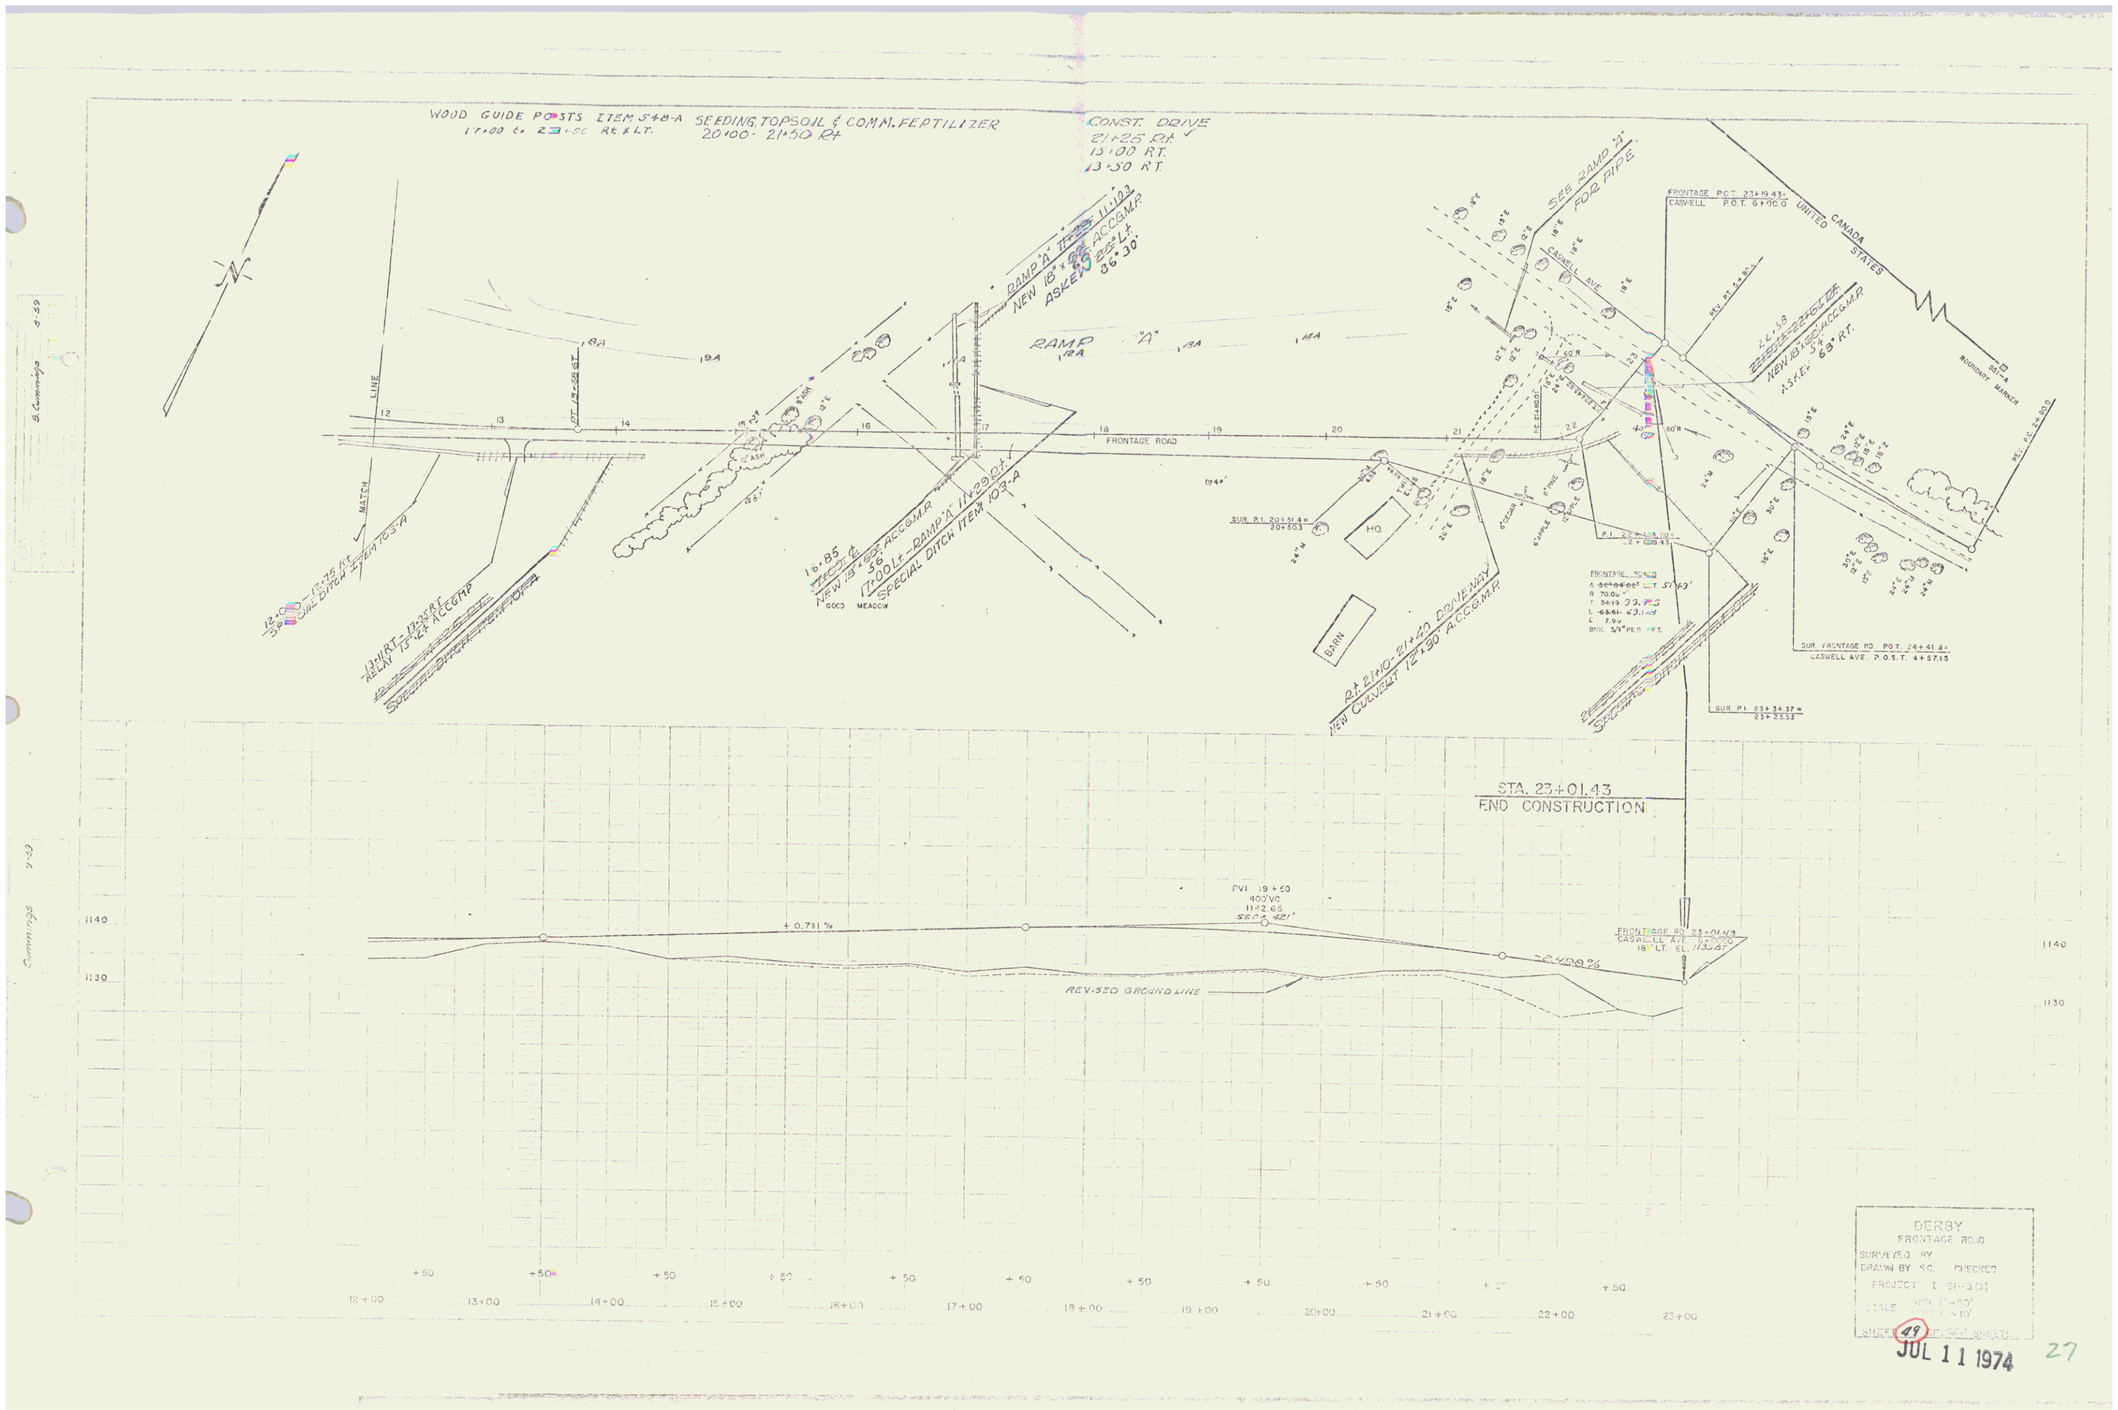
WOOD GUIDE POSTS ITEM 548-A
17+00 to 23+00 Rt & LT.
SEEDING, TOPSOIL & COMM. FERTILIZER
20+00 - 21+50 Rt
CONST. DRIVE
21+25 Rt
13+00 RT.
13+50 RT.
FRONTAGE ROAD
RAMP "A"
SEE RAMP "A" FOR PIPE
CASWELL AVE.
UNITED STATES
CANADA
BOUNDARY MARKER
HO
BARN
GOOD MEADOW
STA. 23+01.43
END CONSTRUCTION
+0.711 %
REVISED GROUND LINE
DERBY
FRONTAGE ROAD
JUL 11 1974