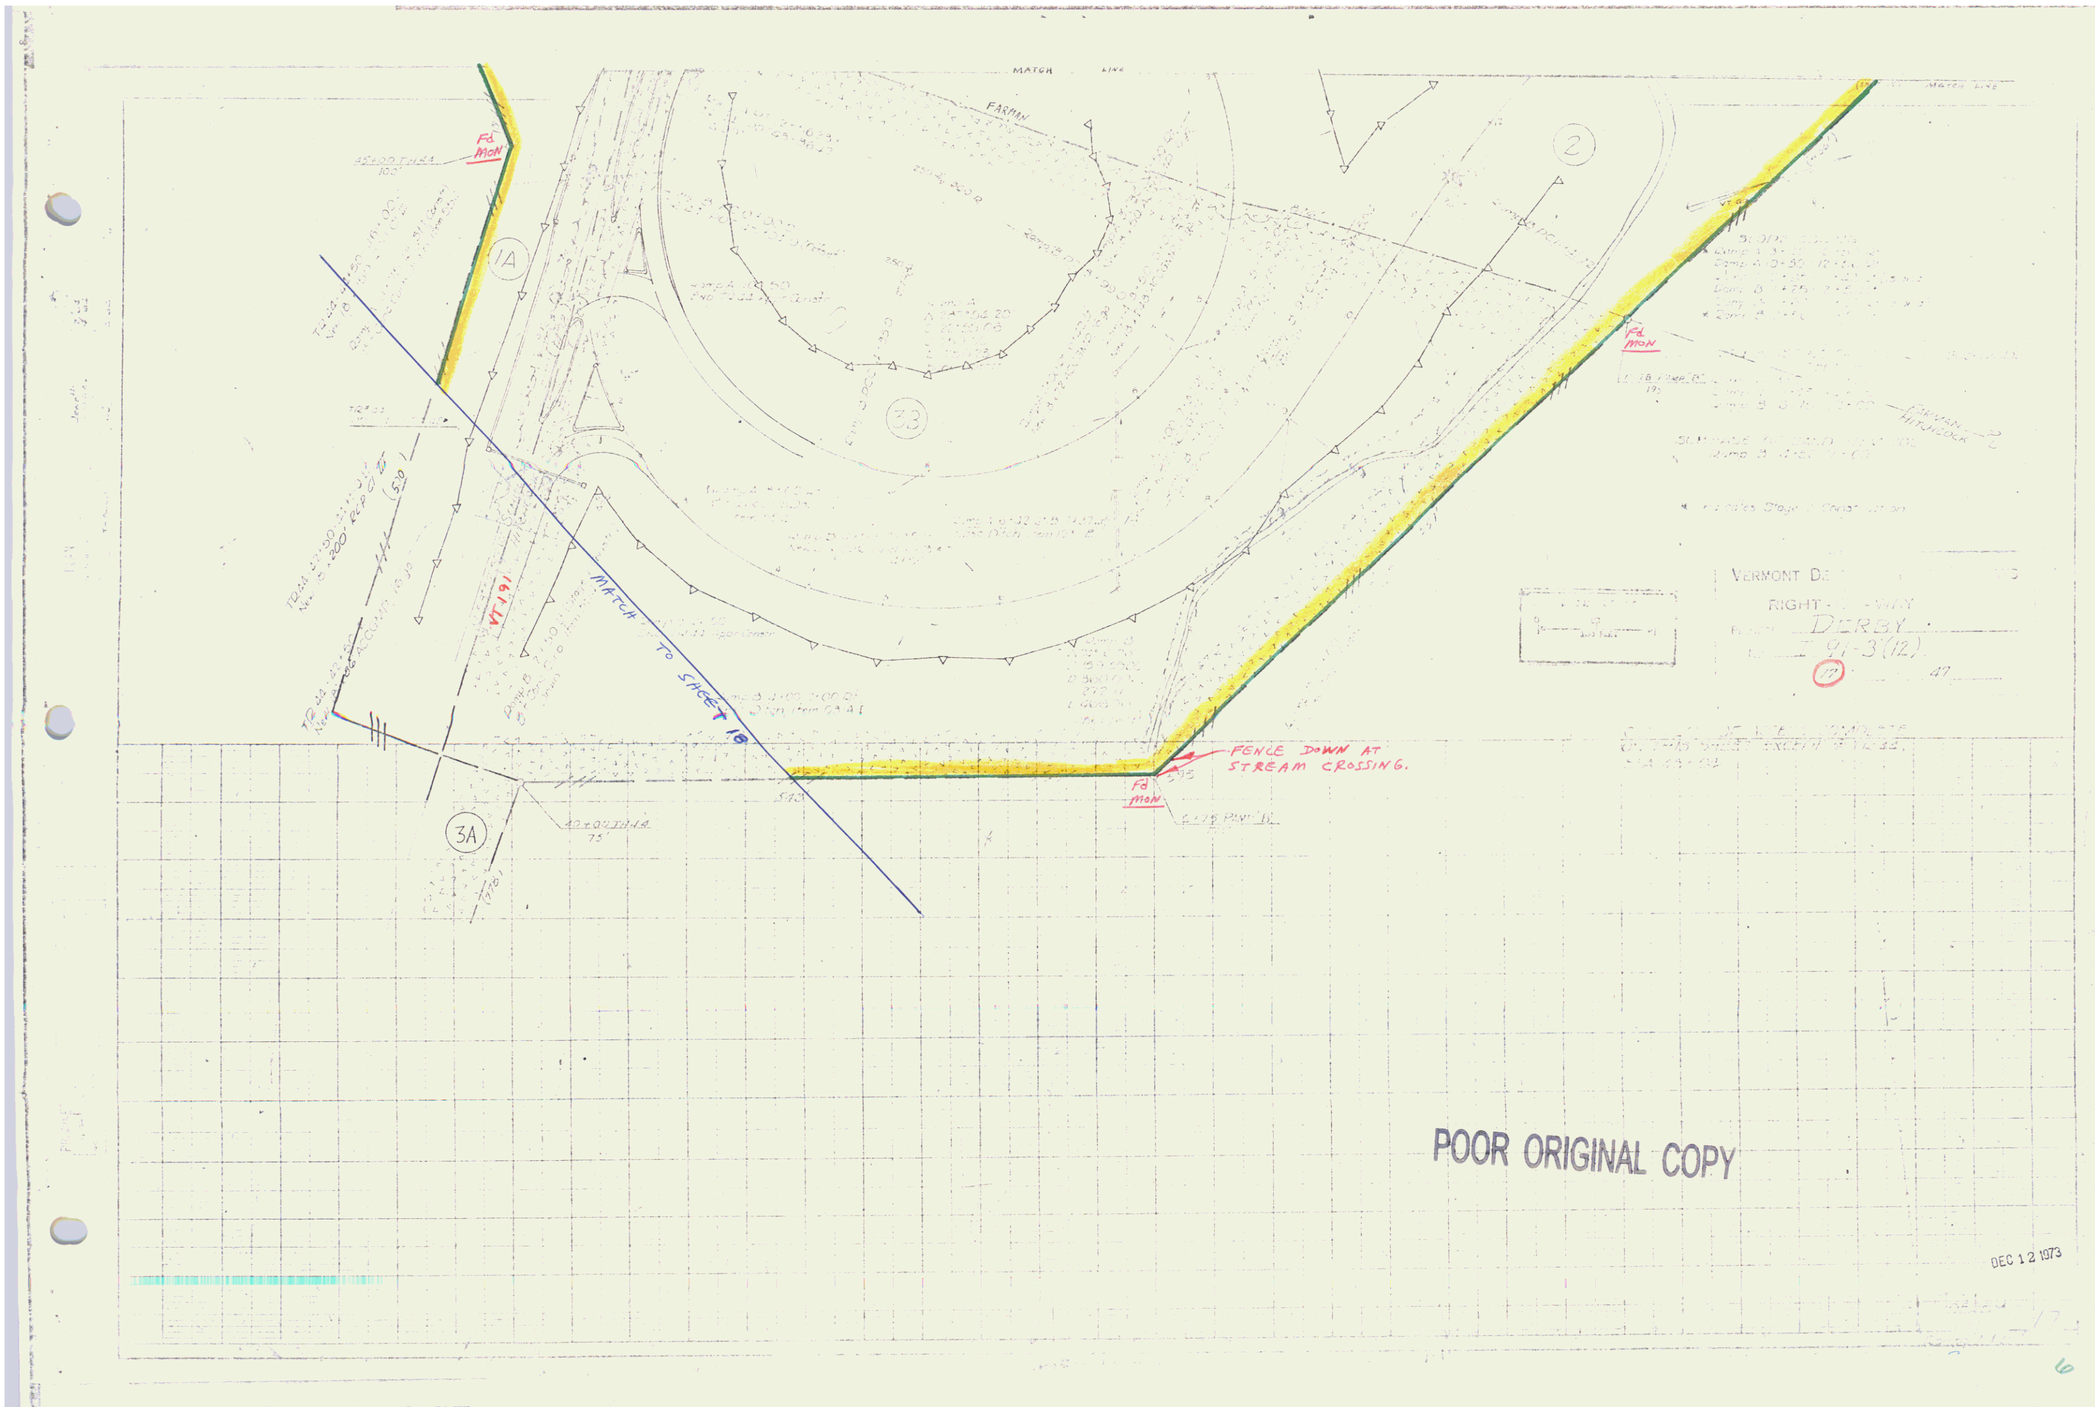
MATCH LINE
FARMAN
1A
2
3A
33
Fd MON
VT 191
FENCE DOWN AT STREAM CROSSING.
VERMONT DE
RIGHT-OF-WAY
DERBY
I 91-3(12)
12
47
POOR ORIGINAL COPY
DEC 12 1973