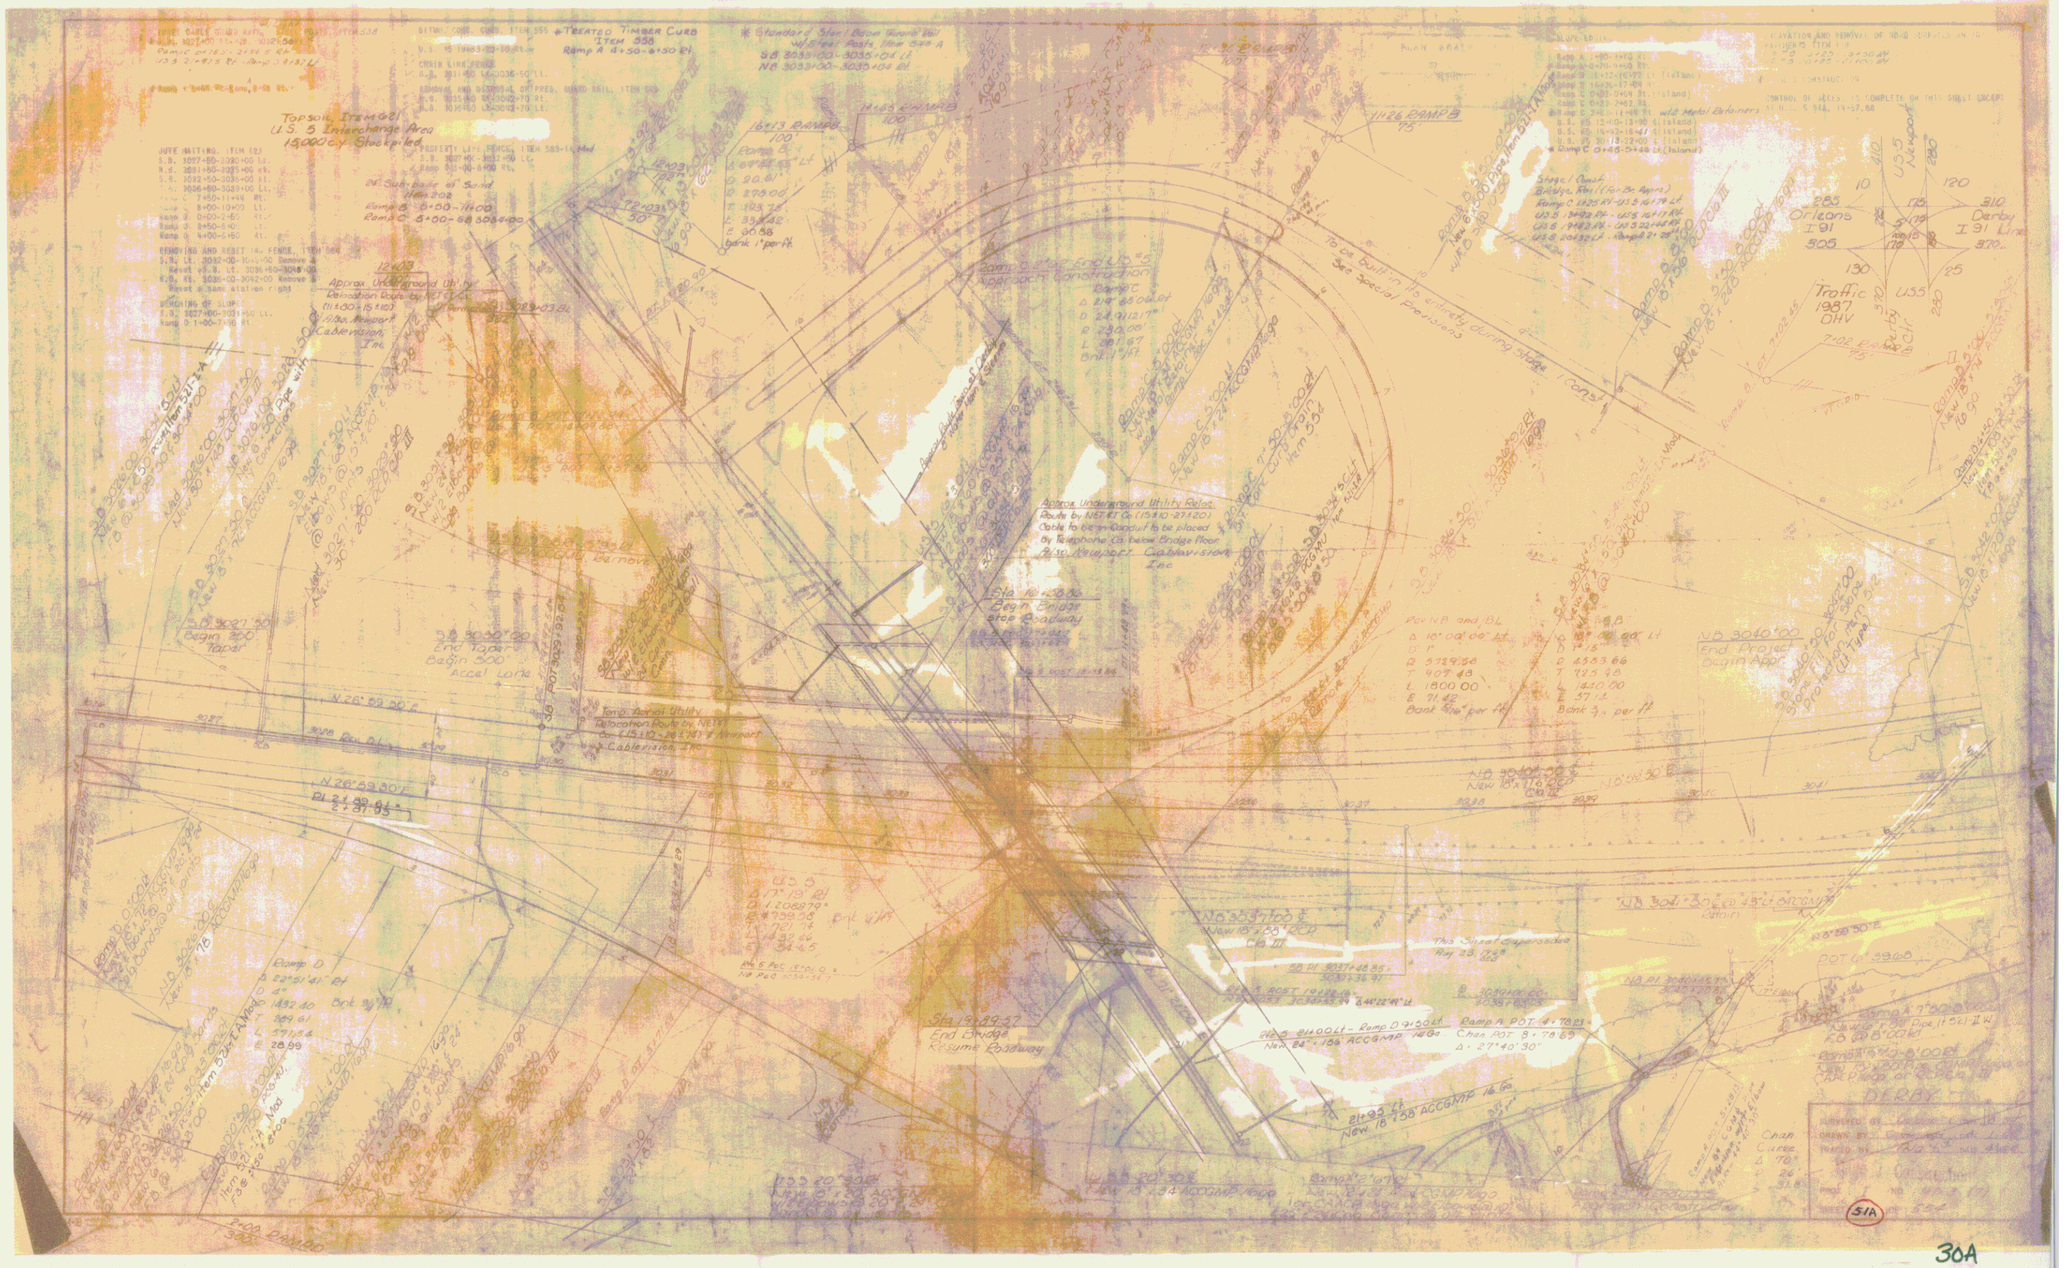
Topsoil, Item 621
U.S. 5 Interchange Area
15,000 c.y. Stockpiled
Approx. Underground Utility Relocation Route by NET Cat. Cablevision, Inc.
Begin Bridge
End Bridge
Resume Roadway
Traffic
1987
DHV
Orleans
Derby
Newport
DELAY

30A