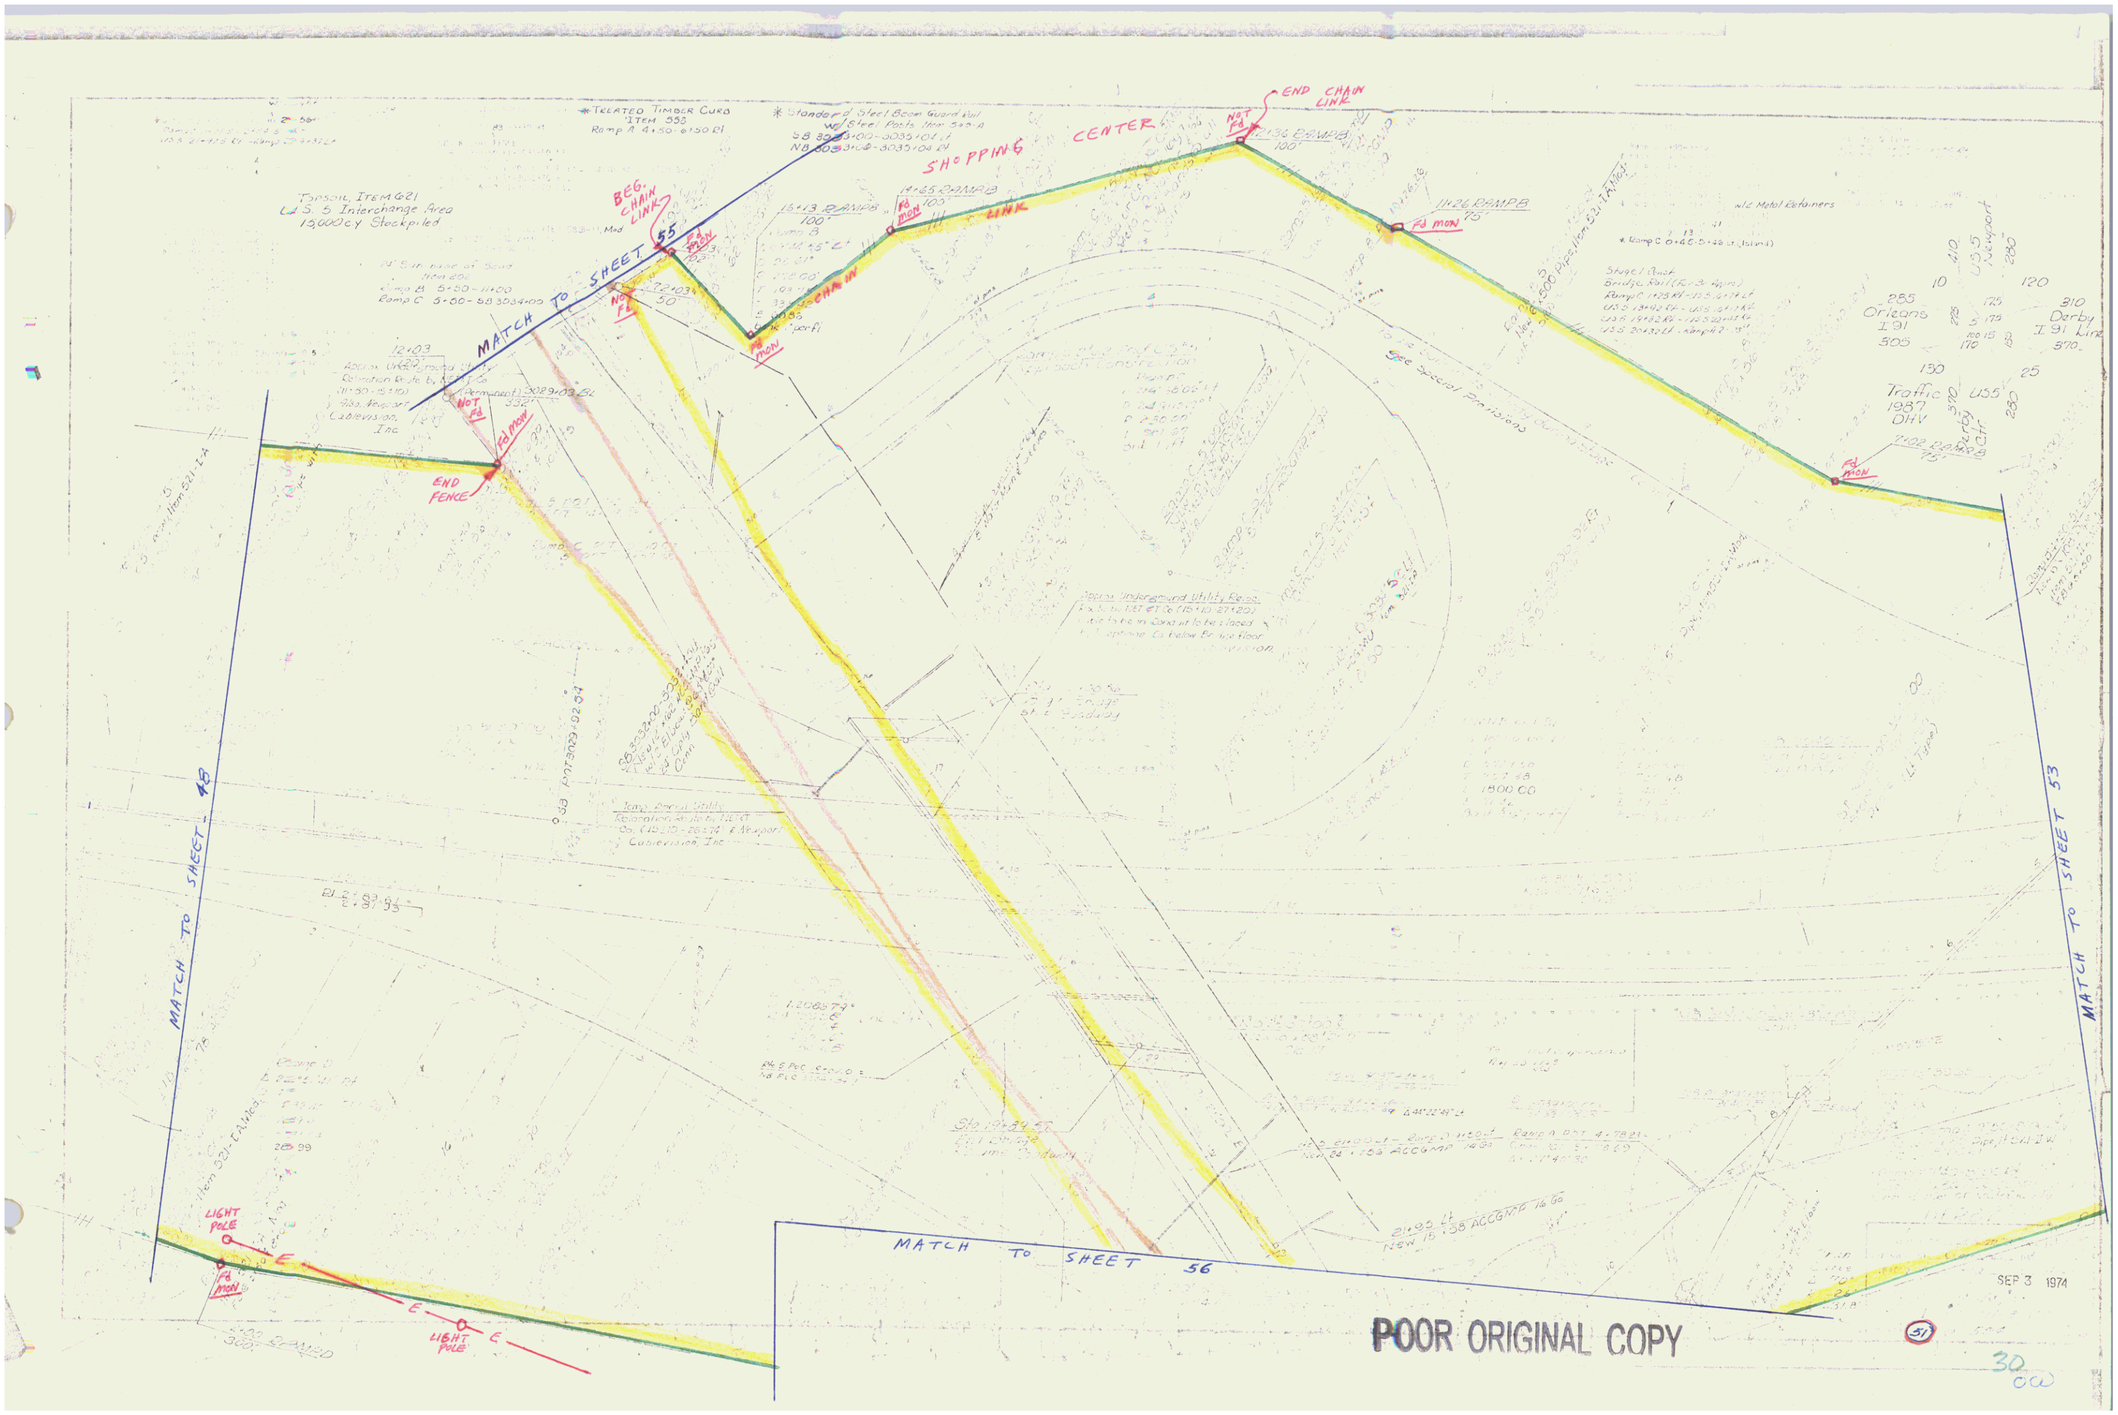
MATCH TO SHEET 48
MATCH TO SHEET 53
MATCH TO SHEET 56
SHOPPING CENTER
CHAIN LINK
BEG. CHAIN LINK
END CHAIN LINK
END FENCE
LIGHT POLE
Fd MON
Not Fd
Topsoil, Item 621
U.S. 5 Interchange Area
12,000 CY Stockpiled
Treated Timber Curb
Item 555
Ramp A 4+50-6+50 Rt
Standard Steel Beam Guard Rail
w/ Steel Posts, Item 540-A
Traffic
1987
DHV
Orleans
I 91
Derby
I 91 Link
U.S. 5
Newport
See Special Provisions
SEP 3 1974
POOR ORIGINAL COPY
30.00