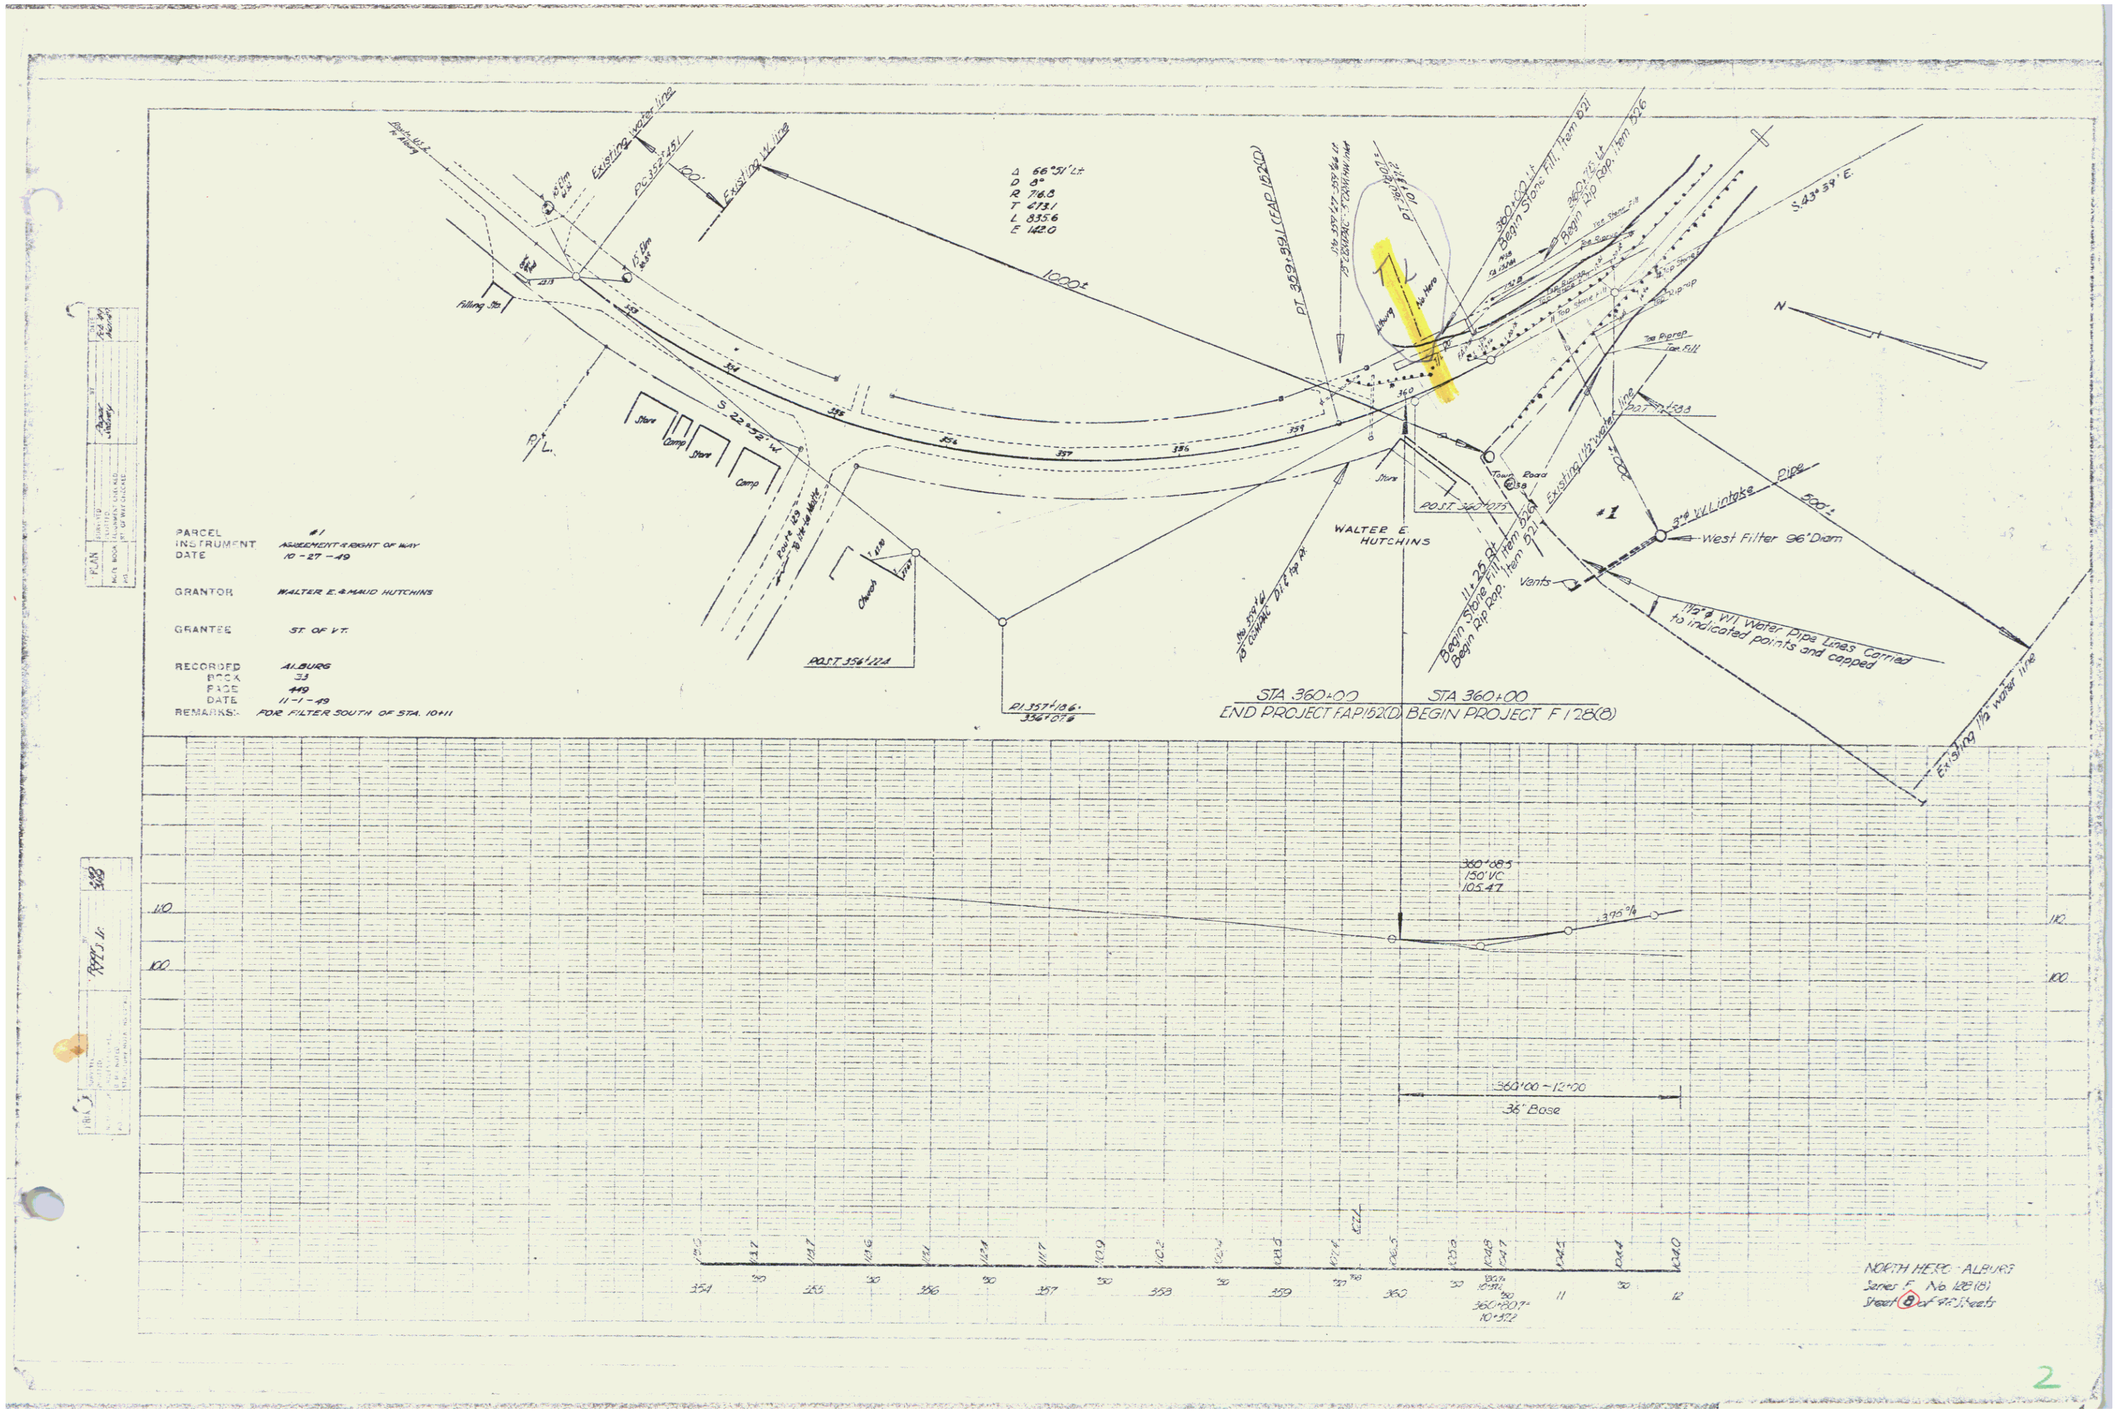
PARCEL #1
INSTRUMENT AGREEMENT & RIGHT OF WAY
DATE 10-27-49
GRANTOR WALTER E. & MAUD HUTCHINS
GRANTEE ST. OF VT.
RECORDED ALBURG
BOOK 33
PAGE 449
DATE 11-1-49
REMARKS: FOR FILTER SOUTH OF STA. 10+11
Δ 66°51' Lt.
D 8°
R 716.8
T 612.1
L 833.6
E 142.0
1000±
S 22°55' W
S 43°59' E
N
Filling Sta
Store
Comp
Church
POST 354+71.4
PI 357+16.6
336+07.8
PI 359+39.1 (EAP 152(D))
PI 361+27.7
PI 363+30.7
WALTER E. HUTCHINS
POST 360+05
Tower
Road
Vents
#1
3"ø W.I. Intake Pipe
500±
West Filter 96' Diam
1½"ø W.I. Water Pipe Lines Carried to indicated points and capped
Ex. 3/4" & 1½" water line
Existing 1½" water line
Begin Stone Fill, Item 821
Begin Rip Rap, Item 826
Begin Stone Fill, Item 824
Begin Rip Rap, Item 827
To Pierce Tow Fill
STA 360+00
END PROJECT F.A.P. 152(D)
STA 360+00
BEGIN PROJECT F 128(8)
360+08.5
150' VC
105.47
-3.75%
360+00 - 12+00
36' Base
NORTH HERO - ALBURG
Series F No. 128(8)
Sheet 8 of 96 Sheets

2