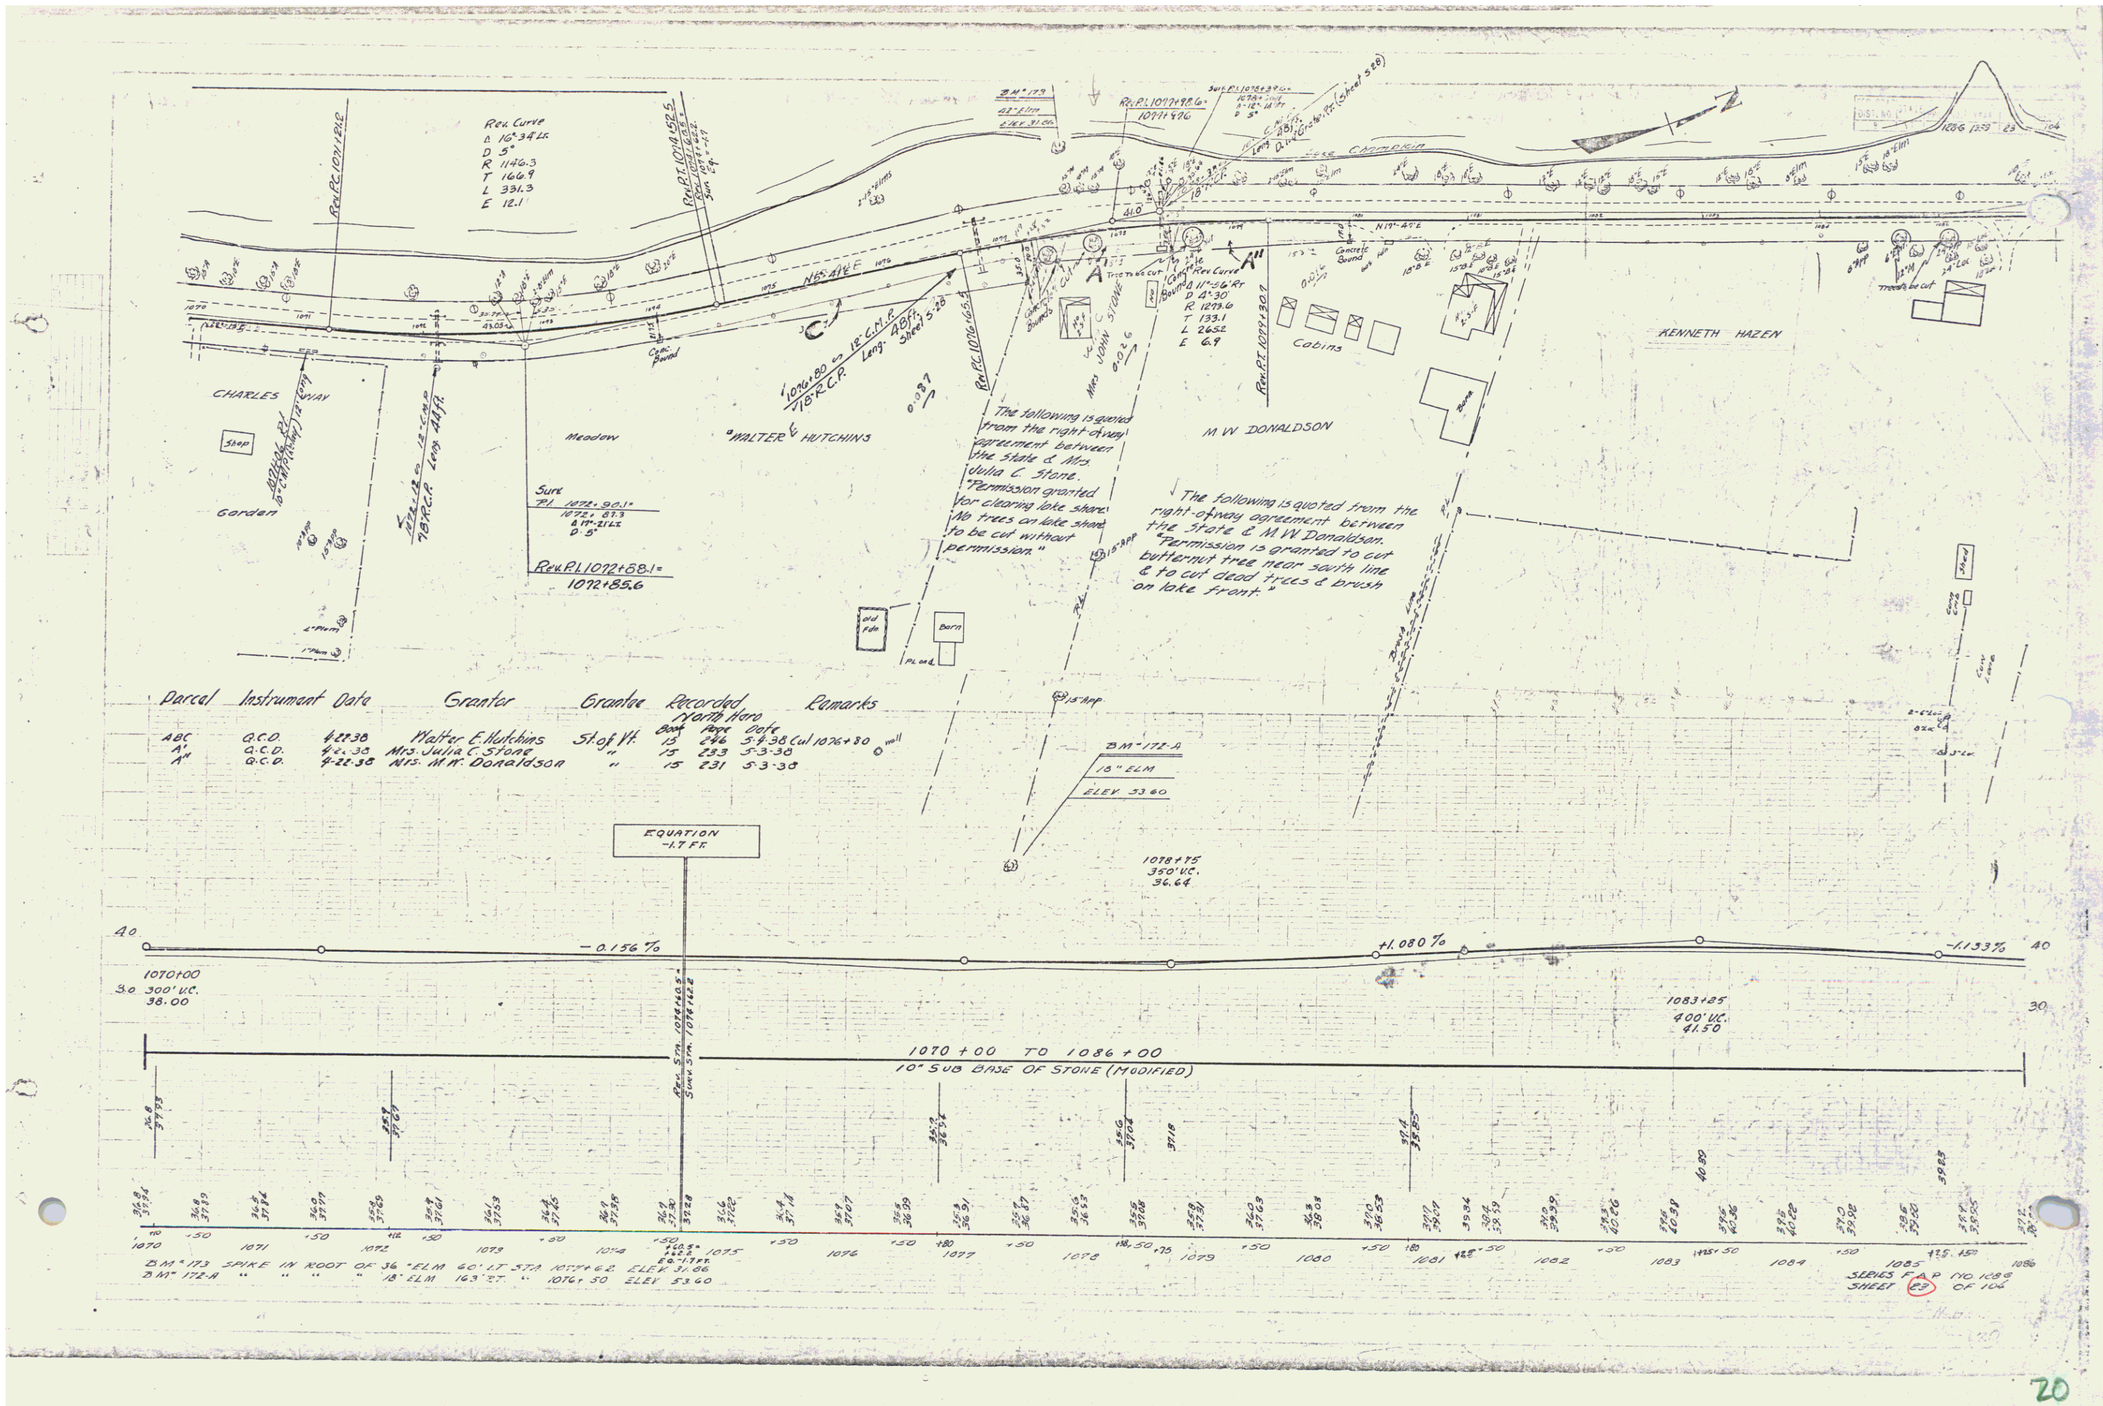

Parcel	Instrument	Date	Grantor	Grantee	Recorded Book	Recorded Page	Recorded Date	Remarks
ABC	Q.C.D.	4-27-38	Walter E. Hutchins	St. of Vt.	15	246	5-4-38	(w/ 1076+80 wall)
A'	Q.C.D.	4-21-38	Mrs. Julia C. Stone	"	15	233	5-3-38	
A''	Q.C.D.	4-22-38	Mrs. M.W. Donaldson	"	15	231	5-3-38	