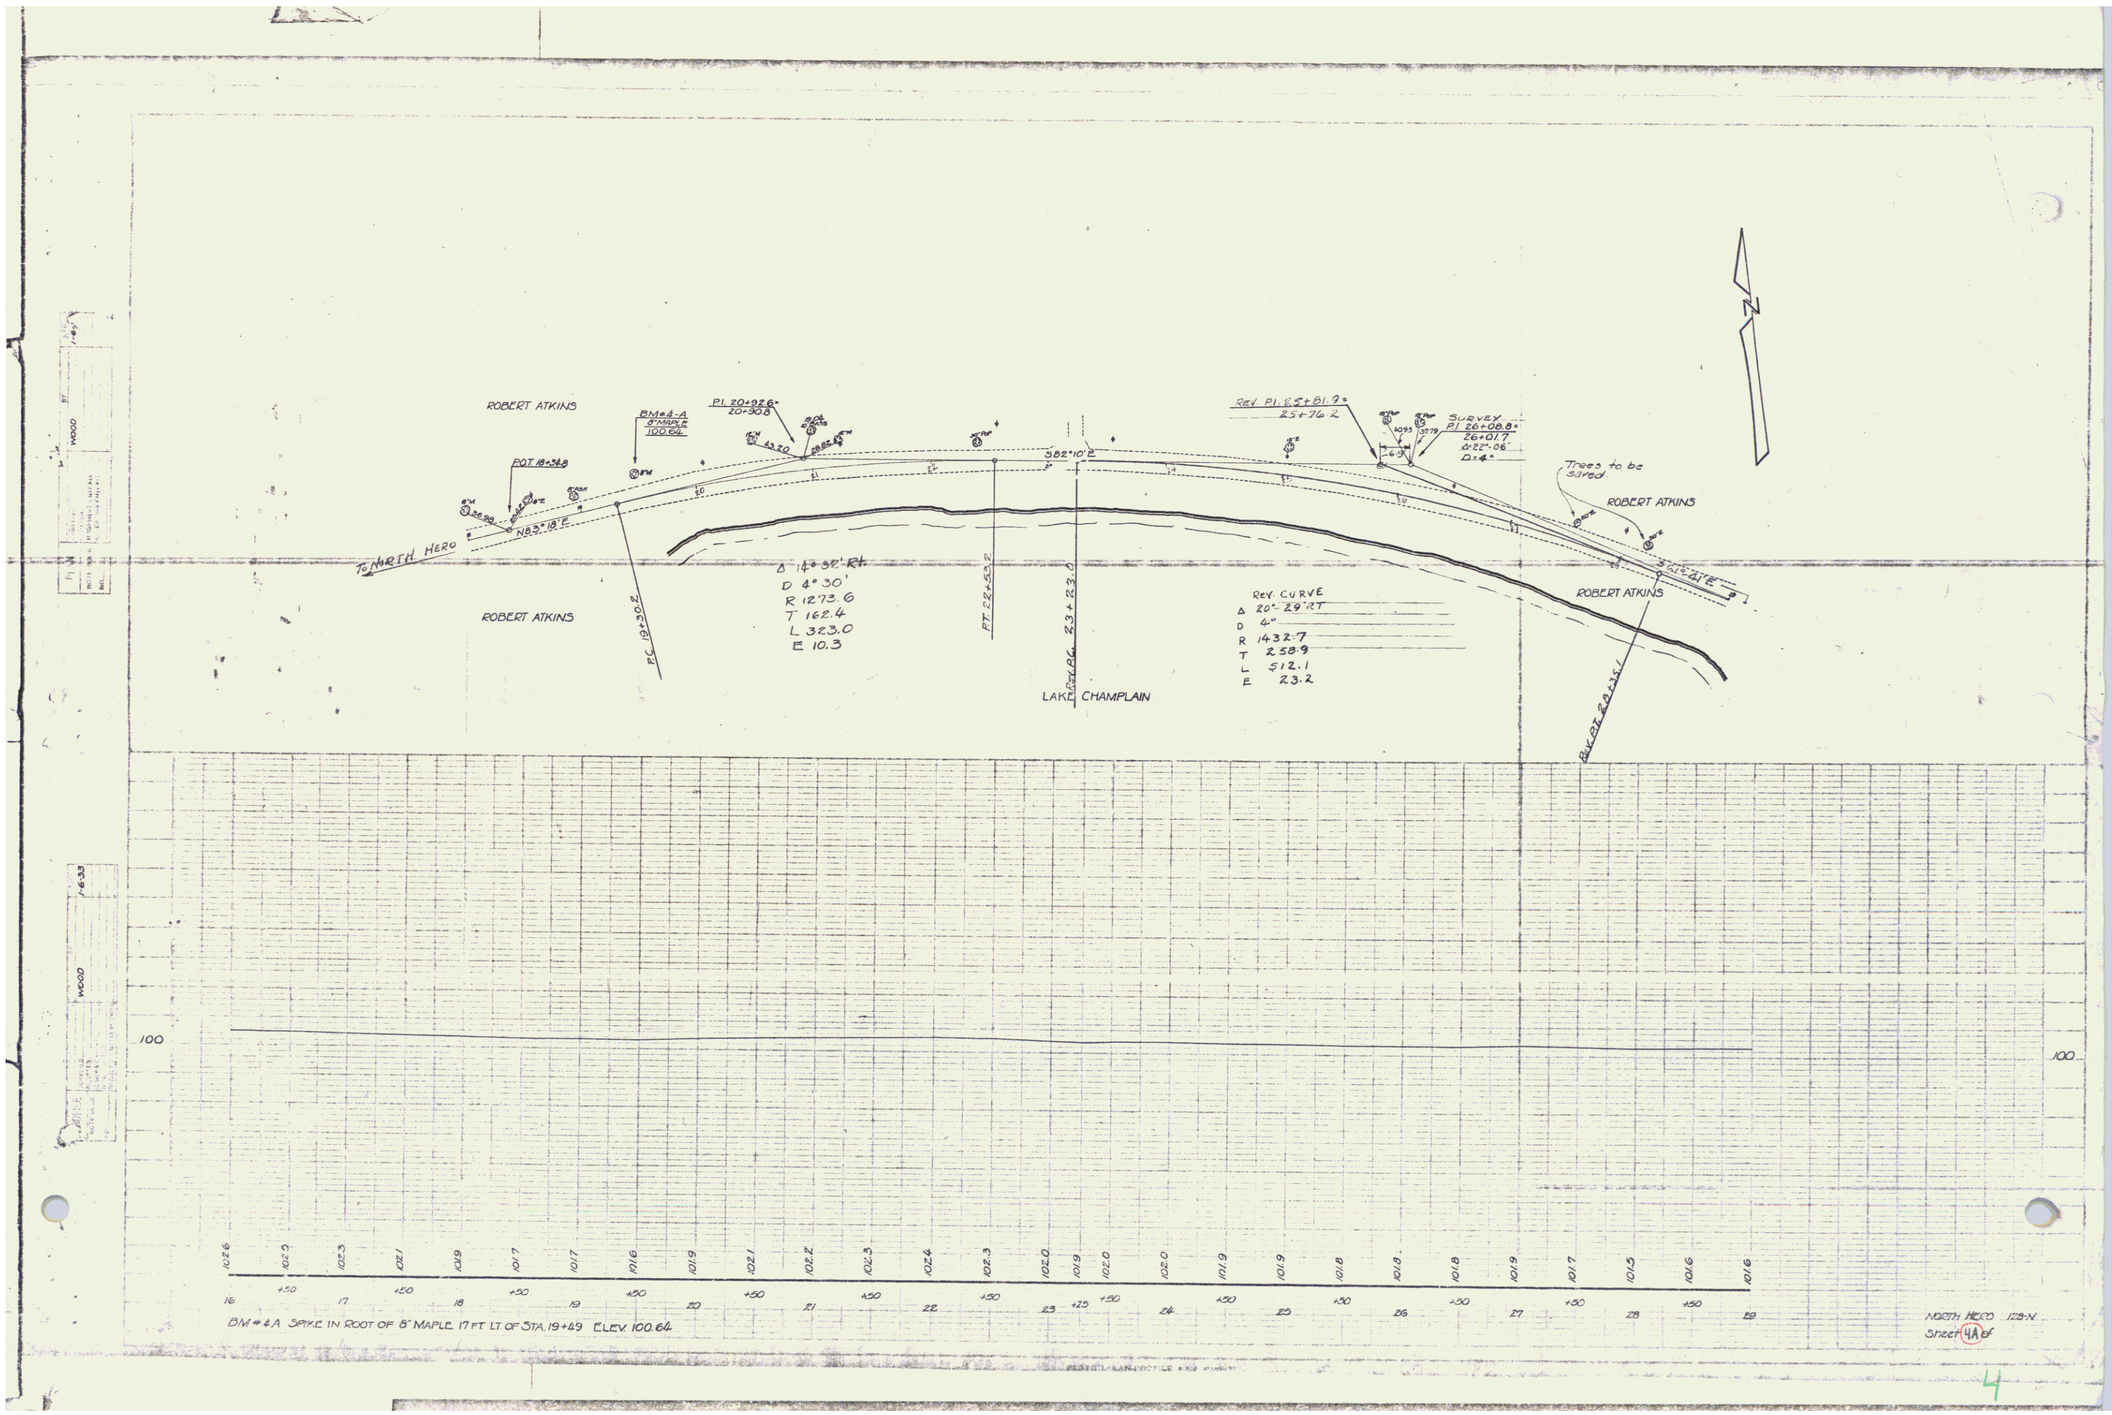
ROBERT ATKINS
BM#4-A
8" MAPLE
100.64
P.I. 20+92.6
20+90.8
P.O.T. 18+26.8
N85°18'E
TO NORTH HERO
S82°10'E
Rev. P.I. 25+81.9
25+76.2
SURVEY
P.I. 26+08.8
26+01.7
Δ=22°-06'
D=4°
Trees to be saved
ROBERT ATKINS
S76°24'E
ROBERT ATKINS
ROBERT ATKINS
P.C. 19+30.2
Δ 14° 38' Rt
D 4° 30'
R 1273.6
T 162.4
L 323.0
E 10.3
P.T. 22+53.2
23+23.0
Rev. BL.
LAKE CHAMPLAIN
Rev. CURVE
Δ 20°-29' RT
D 4°
R 1432.7
T 258.9
L 512.1
E 23.2
Rev. BL. 26+25.1
100
100
102.6
102.5
102.3
102.1
101.9
101.7
101.7
101.6
101.9
102.1
102.2
102.3
102.4
102.3
102.0
101.9
102.0
102.0
101.9
101.9
101.8
101.8
101.8
101.9
101.7
101.5
101.6
101.6
16
+50
17
+50
18
+50
19
+50
20
+50
21
+50
22
+50
23
+25
+50
24
+50
25
+50
26
+50
27
+50
28
+50
29
BM #4A SPIKE IN ROOT OF 8" MAPLE 17 FT LT OF STA. 19+49 ELEV. 100.64
NORTH HERO 128-N
Sheet 4A of

4