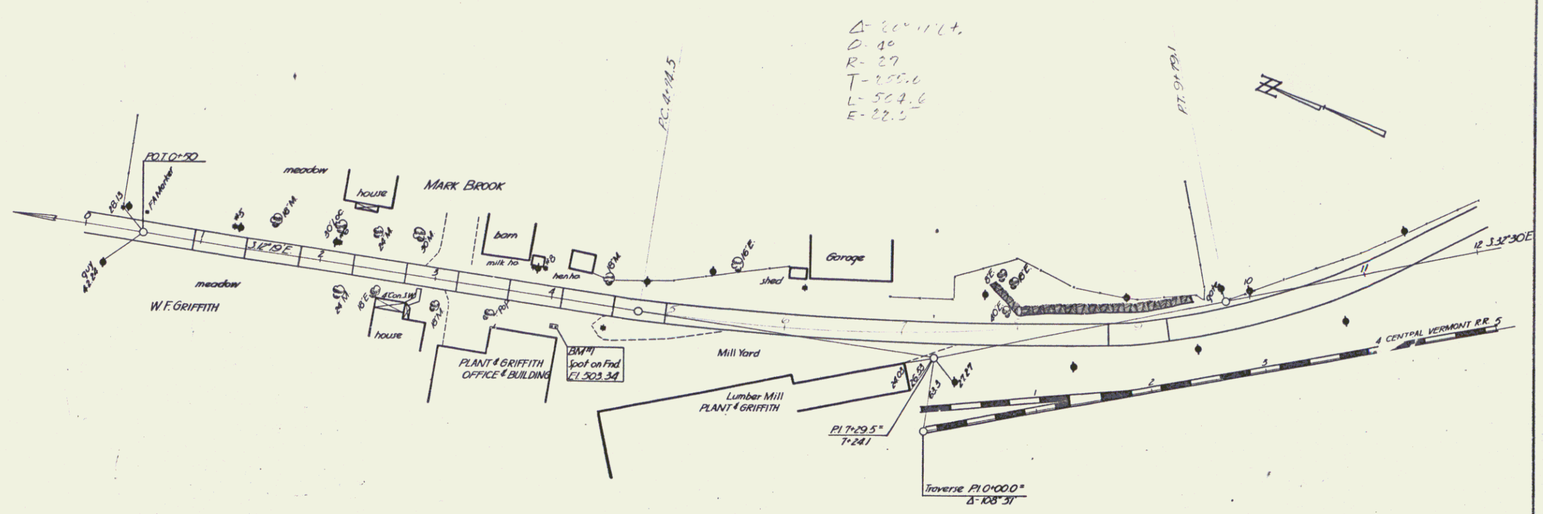

PLATE I - PLAN-PROFILE U.P.R.A.A.E. STANDARD
KEUFFEL & ESSER CO. NEW YORK
K & E Co. No. 346-1C

2