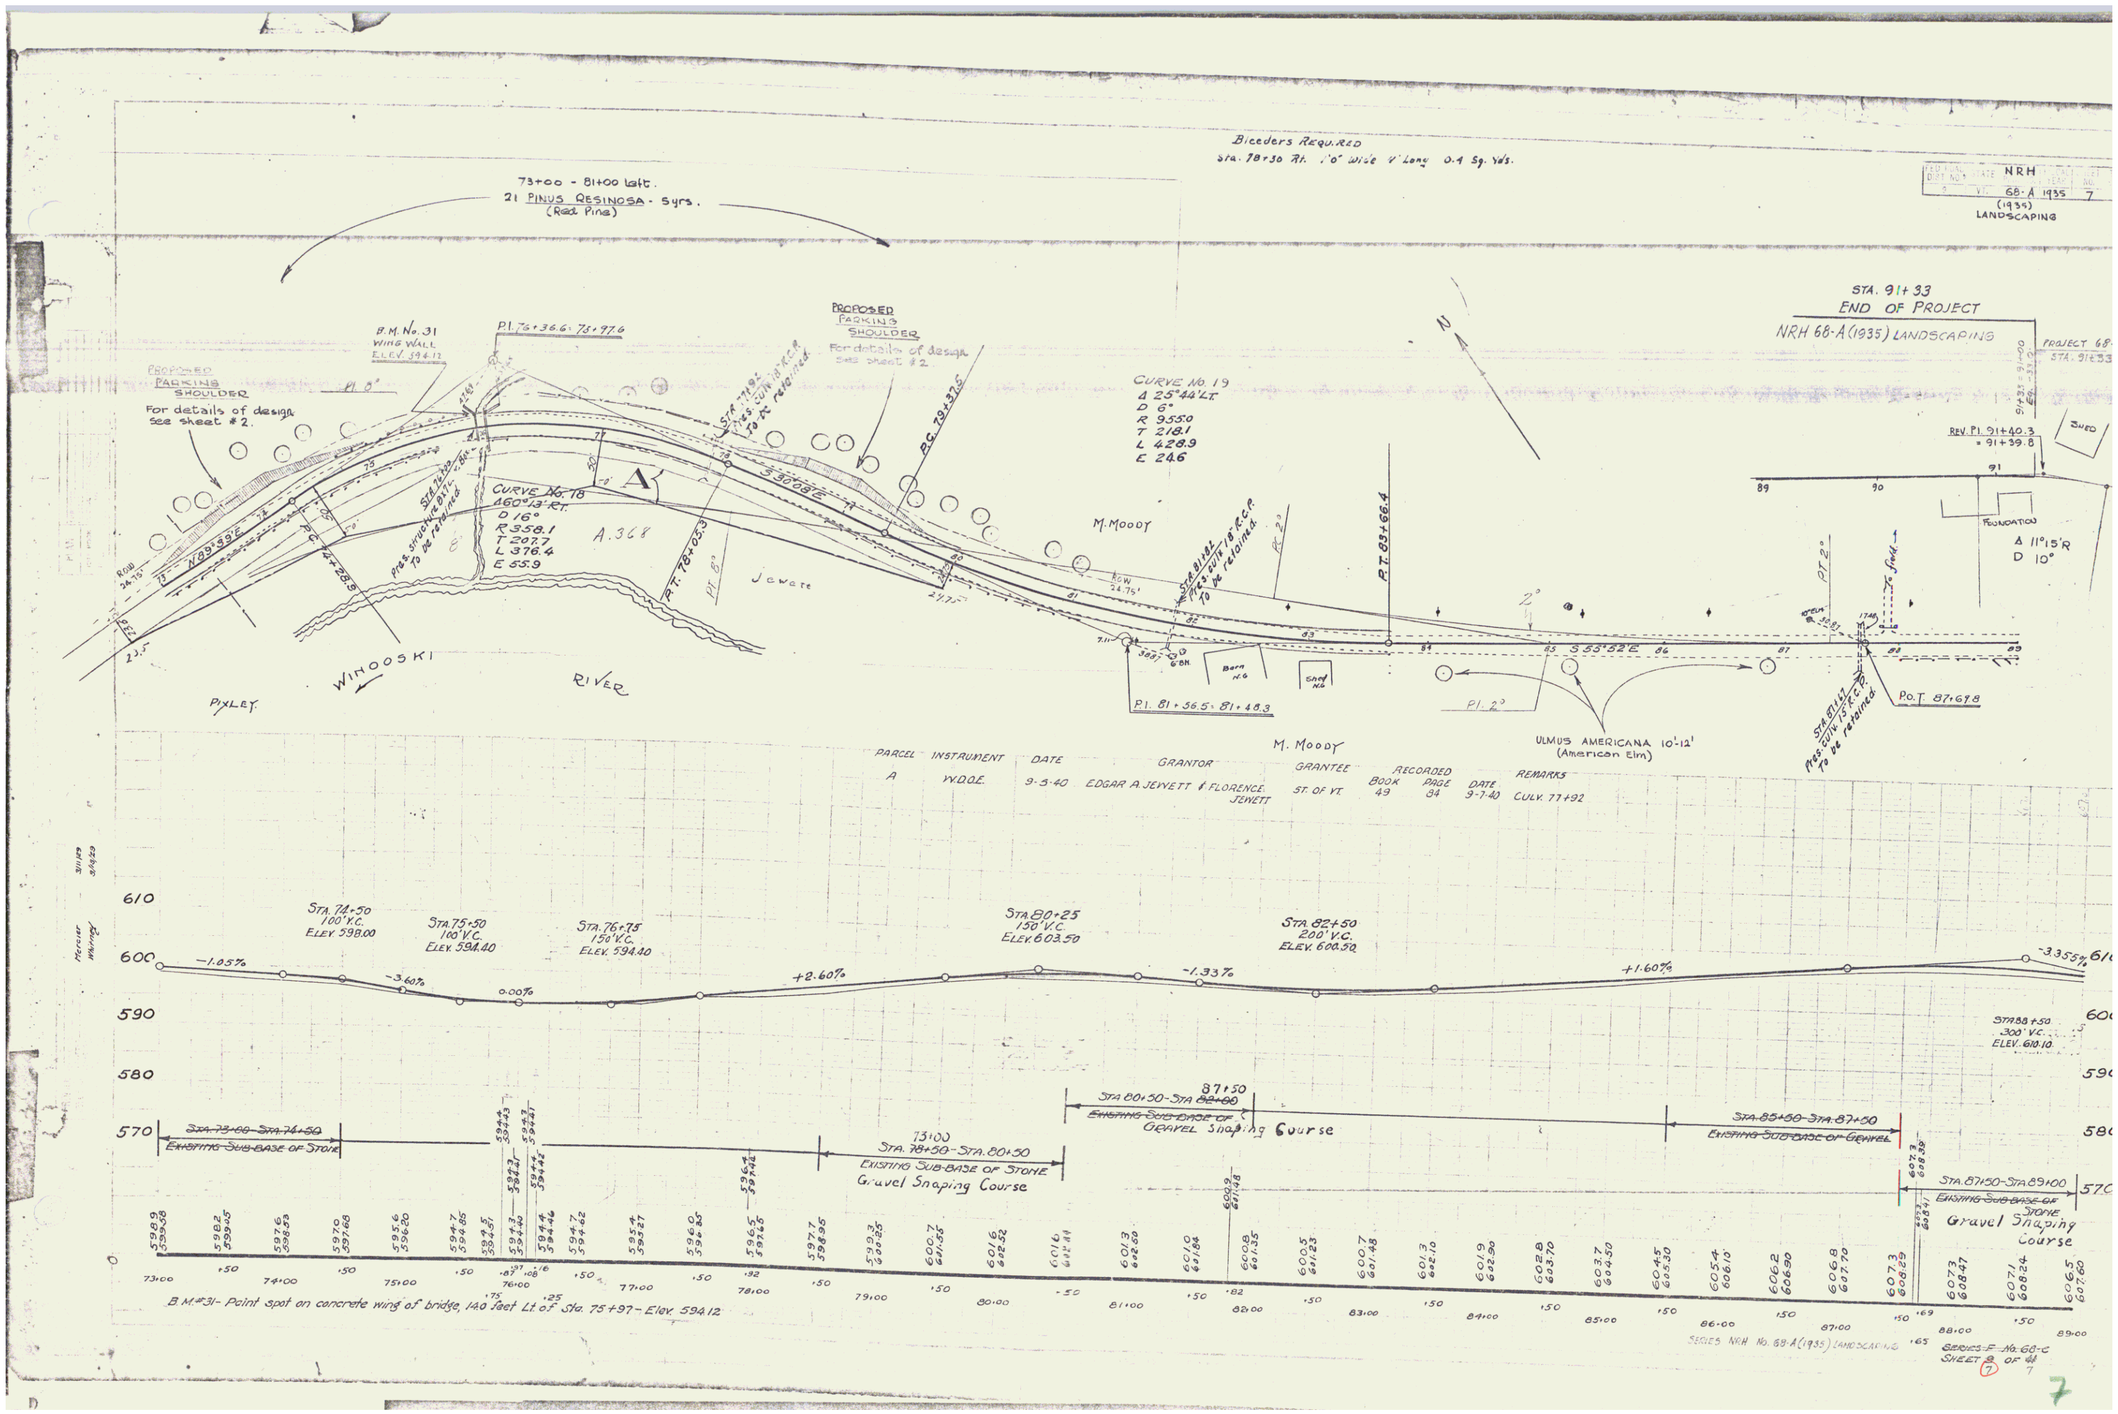
Bleeders Required
Sta. 78+50 Rt. 1'0" Wide 4' Long 0.4 Sq. Yds.
NRH
68-A 1935
(1935)
LANDSCAPING
73+00 - 81+00 Left.
21 PINUS RESINOSA - 5 yrs.
(Red Pine)
B.M. No. 31
WING WALL
ELEV. 594.12
P.I. 76+36.6 - 75+97.6
PROPOSED PARKING SHOULDER
For details of design see sheet #2.
CURVE No. 19
Δ 25°44' Lt.
D 6°
R 955.0
T 218.1
L 428.9
E 24.6
CURVE No. 18
Δ 60°13' Rt.
D 16°
R 358.1
T 207.7
L 376.4
E 55.9
A
A.368
S 30°08' E
N 89°52' E
P.T. 78+05.3
P.C. 79+32.6
M. MOODY
Jewett
WINOOSKI
RIVER
PIXLEY
P.I. 81+56.5 - 81+48.3
P.T. 83+66.4
S 53°52' E
P.I. 2°
ULMUS AMERICANA 10'-12'
(American Elm)
P.O.T. 87+67.8
STA. 91+33
END OF PROJECT
NRH 68-A (1935) LANDSCAPING
PROJECT 68-
STA. 91+33
REV. P.I. 91+40.3
= 91+39.8
FOUNDATION
Δ 11°15' R
D 10°
SHED
Barn No. 6
Shed No.
PARCEL INSTRUMENT DATE GRANTOR GRANTEE RECORDED BOOK PAGE DATE REMARKS
A W.D.Q.E. 9-5-40 EDGAR A. JEWETT & FLORENCE JEWETT M. MOODY ST. OF VT. 43 84 9-7-40 CULV. 77+92
STA. 74+50 100' V.C. ELEV. 598.00
STA. 75+50 100' V.C. ELEV. 594.40
STA. 76+75 150' V.C. ELEV. 594.40
STA. 80+25 150' V.C. ELEV. 603.50
STA. 82+50 200' V.C. ELEV. 600.50
STA. 88+50 300' V.C. ELEV. 610.10
-1.05%
-3.60%
0.00%
+2.60%
-1.33%
+1.60%
-3.355%
STA. 73+00 - STA. 74+50
EXISTING SUB-BASE OF STONE
73+00
STA. 74+50 - STA. 78+50
EXISTING SUB-BASE OF STONE
Gravel Shaping Course
STA. 80+50 - STA. 87+50
EXISTING SUB-BASE OF GRAVEL
Gravel Shaping Course
STA. 85+50 - STA. 87+50
EXISTING SUB-BASE OF GRAVEL
STA. 87+50 - STA. 89+00
EXISTING SUB-BASE OF STONE
Gravel Shaping Course
B.M. #31 - Point spot on concrete wing of bridge, 140 feet Lt. of Sta. 75+97 - Elev. 594.12
SERIES NRH No. 68-A (1935) LANDSCAPING
SERIES F No. 68-C
SHEET 8 OF 44
7