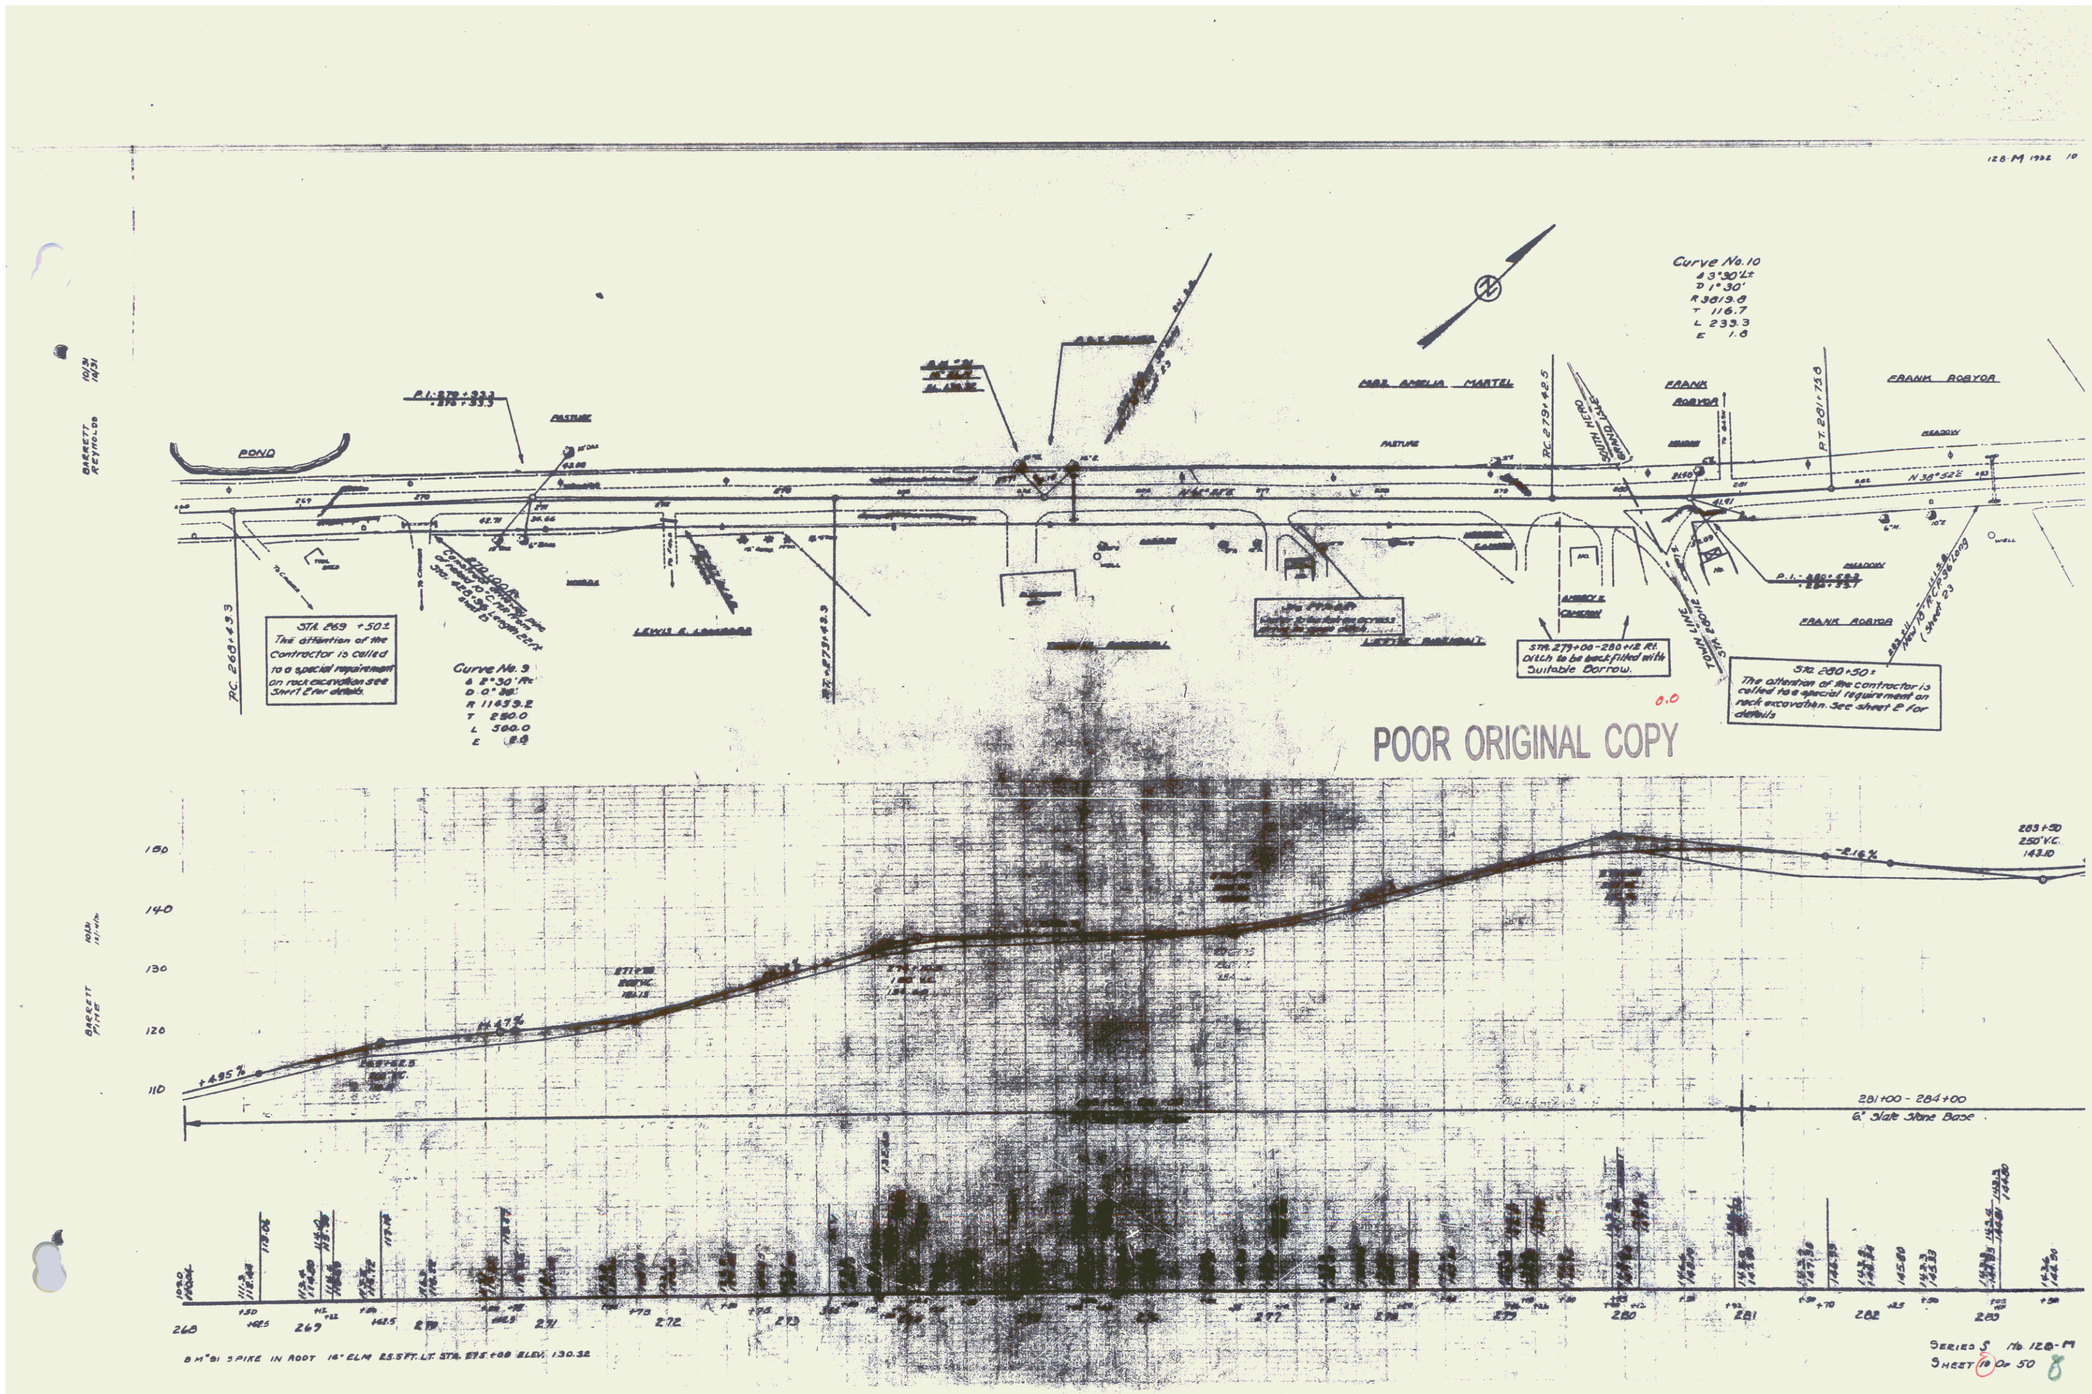
128-M 1932 10
Curve No. 10
Δ 3°30' Lt
D 1°30'
R 3819.8
T 116.7
L 233.3
E 1.8
MRS. AMELIA MARTEL
FRANK ROBYOR
FRANK ROBYOR
PASTURE
MEADOW
POND
P.C. 269+43.3
P.T. 281+73.8
N 38°32'E
P.I. 279+42.5
STA. 269 +50±
The attention of the Contractor is called to a special requirement on rock excavation. See Sheet 2 for details.
Curve No. 9
Δ 2°30' Rt
D 0°30'
R 11459.2
T 250.0
L 500.0
E 2.8
LEWIS E. LONGMIRE
STA. 279+00 - 280+12 Rt.
Ditch to be back-filled with Suitable Borrow.
TOWN LINE
STA. 280+50±
The attention of the contractor is called to a special requirement on rock excavation. See sheet 2 for details
FRANK ROBYOR
0.0
POOR ORIGINAL COPY
BARRETT REYNOLDS
BARRETT PINE
+4.95%
+1.47%
-2.16%
281+00 - 284+00
6" Slate Stone Base
283+50
250' V.C.
143.10
268
267
271
272
273
277
279
280
281
282
283
BM "B1" SPIKE IN ROOT 16" ELM 25.5 FT. LT. STA. 275+00 ELEV. 130.32
SERIES S No. 128-M
SHEET 10 OF 50
8