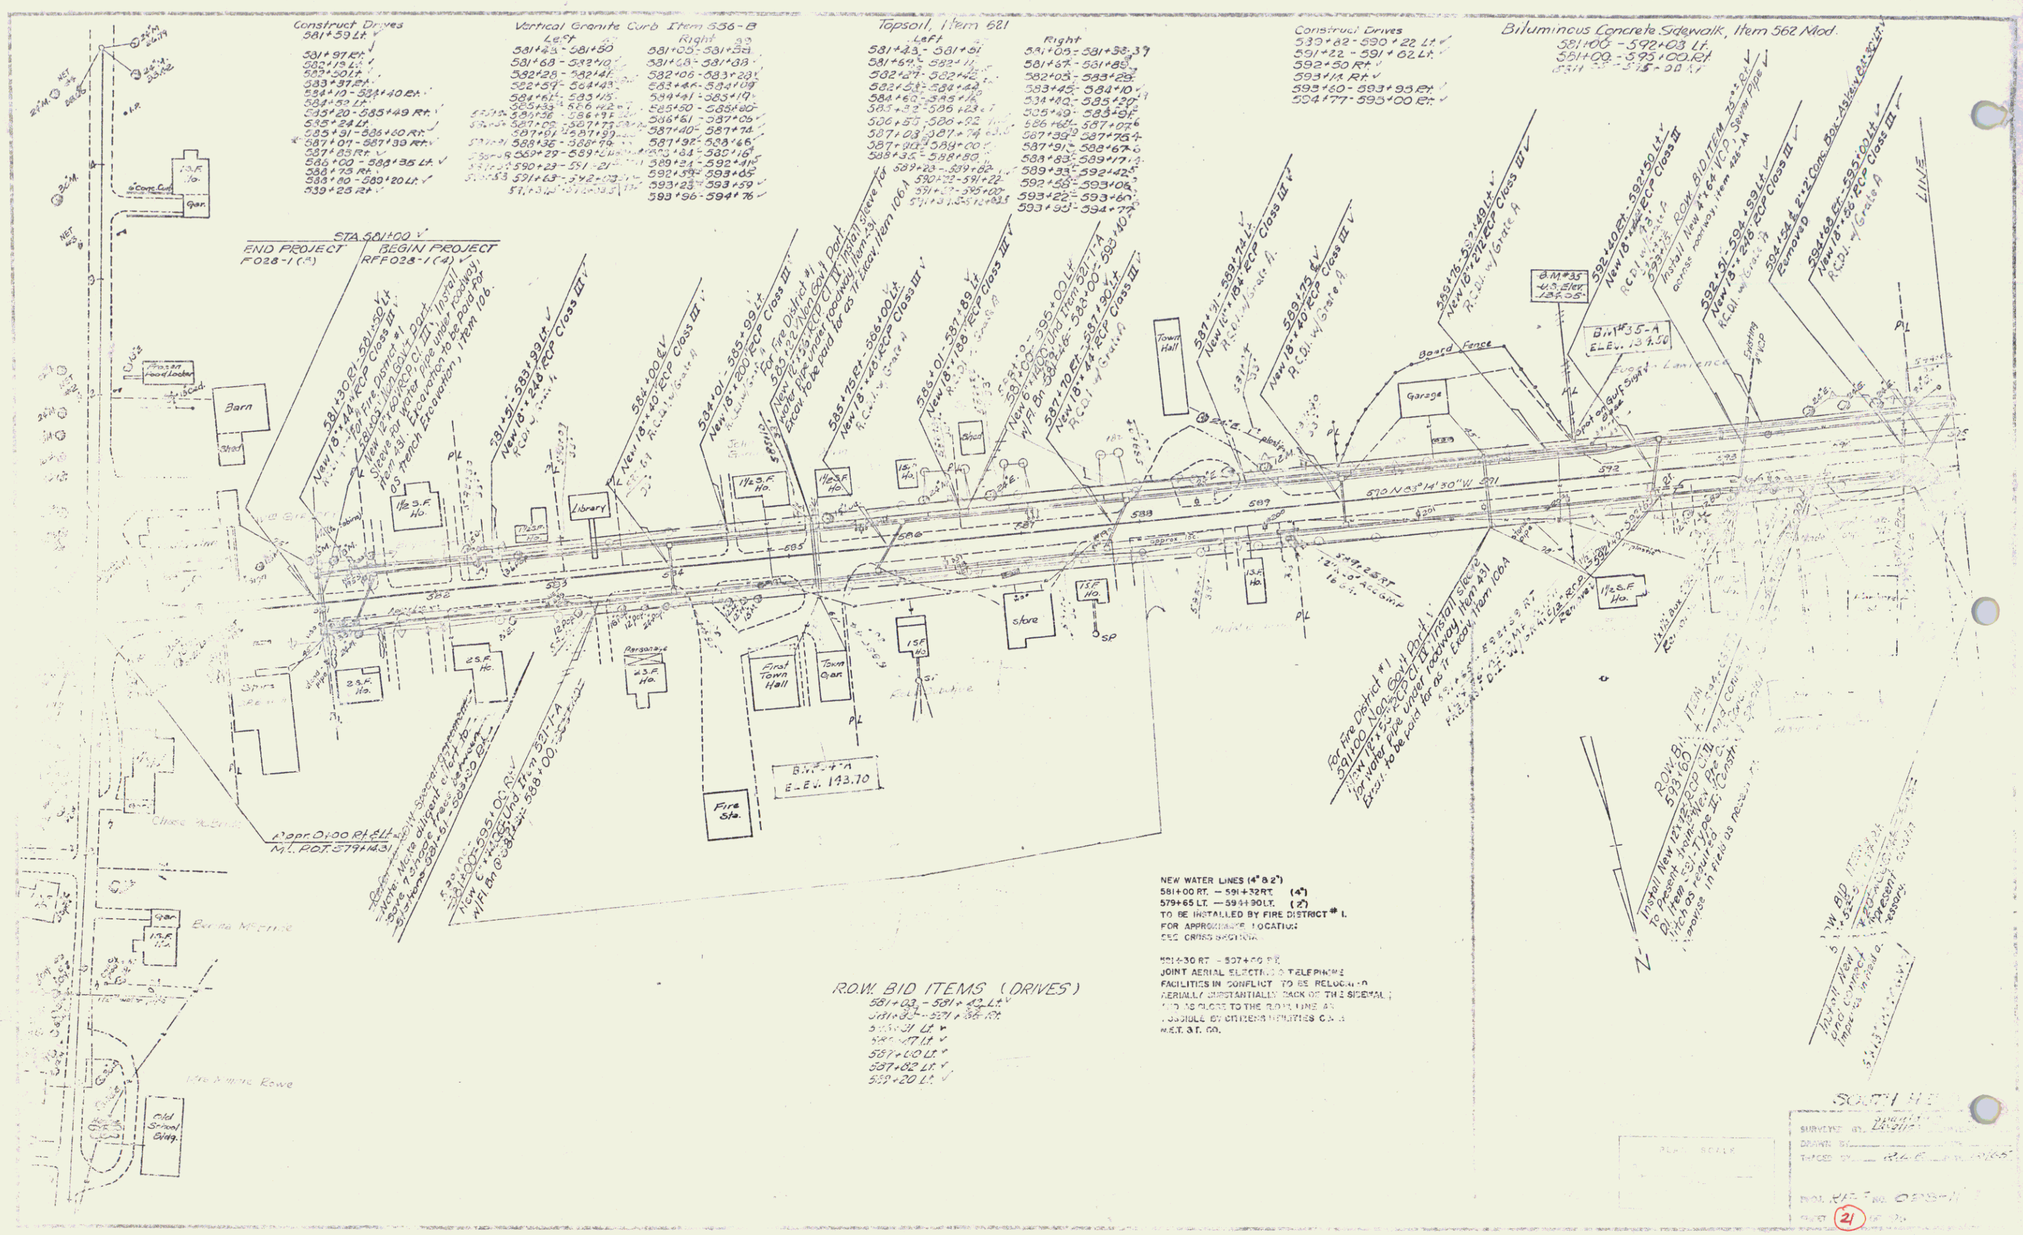
Construct Drives
Vertical Granite Curb Item 556-B
Left
Right
Topsoil, Item 681
Construct Drives
Bituminous Concrete Sidewalk, Item 562 Mod.
STA 581+00
END PROJECT F028-1(4)
BEGIN PROJECT RF F028-1(4)
Barn
Library
Store
First Town Hall
Town Garr.
Fire Sta.
Garage
Town Hall
Board Fence
Old School Bldg.
Depr. 0:00 Pt. Rt.
M.L. POT. 579+14.31
B.M. #35-A
ELEV. 137.50
B.M. #34-A
ELEV. 143.70
NEW WATER LINES (4" & 2")
581+00 RT. — 591+32 RT. (4")
579+65 LT. — 591+30 LT. (2")
TO BE INSTALLED BY FIRE DISTRICT # 1.
FOR APPROXIMATE LOCATION
SEE CROSS SECTION.
R.O.W. BID ITEMS (DRIVES)
SOUTH HE

9