Removal & Disposal of Present Guard Rail Item 550
306+60 - 306+82 Rt.
306+78 - 308+60 Lt.
308+60 - 312+85 Rt.
312+60 - 312+85 Rt.

Construct Approaches
316+50 Rt.
319+50 Rt.

Three Cable Guard Rail with Steel Posts Item 543
Loc. Anchors
309+00 - ~~[illegible]~~ Lt 313+63 #3
310+70 ~~[illegible]~~ - 314+20 Rt. 2
321+20 ~~[illegible]~~ - 325+00 Lt. 1
320+89 ~~[illegible]~~ - 325+00 Rt. #2

Construct Drive
~~320+50~~ Lt.
321+00
Parking Area
320+60 Rt.

Excavation & Removal of Existing Cement Conc. Pavement Item 120
310+00 - 316+15 Rt.
310+25 - 313+35 Rt.
321+50 - 323+00 Rt.

Δ 90°00' Rt
D 9°
R 1145.9'
T 1145.9'
L 1800.0'
E 474.6'
Bank 1' per ft.

Plank Guard Rail Item 541-A
316+00 Rt. 24'
316+00 Rt. 24'
~~[illegible]~~
319+35 Rt. 24'

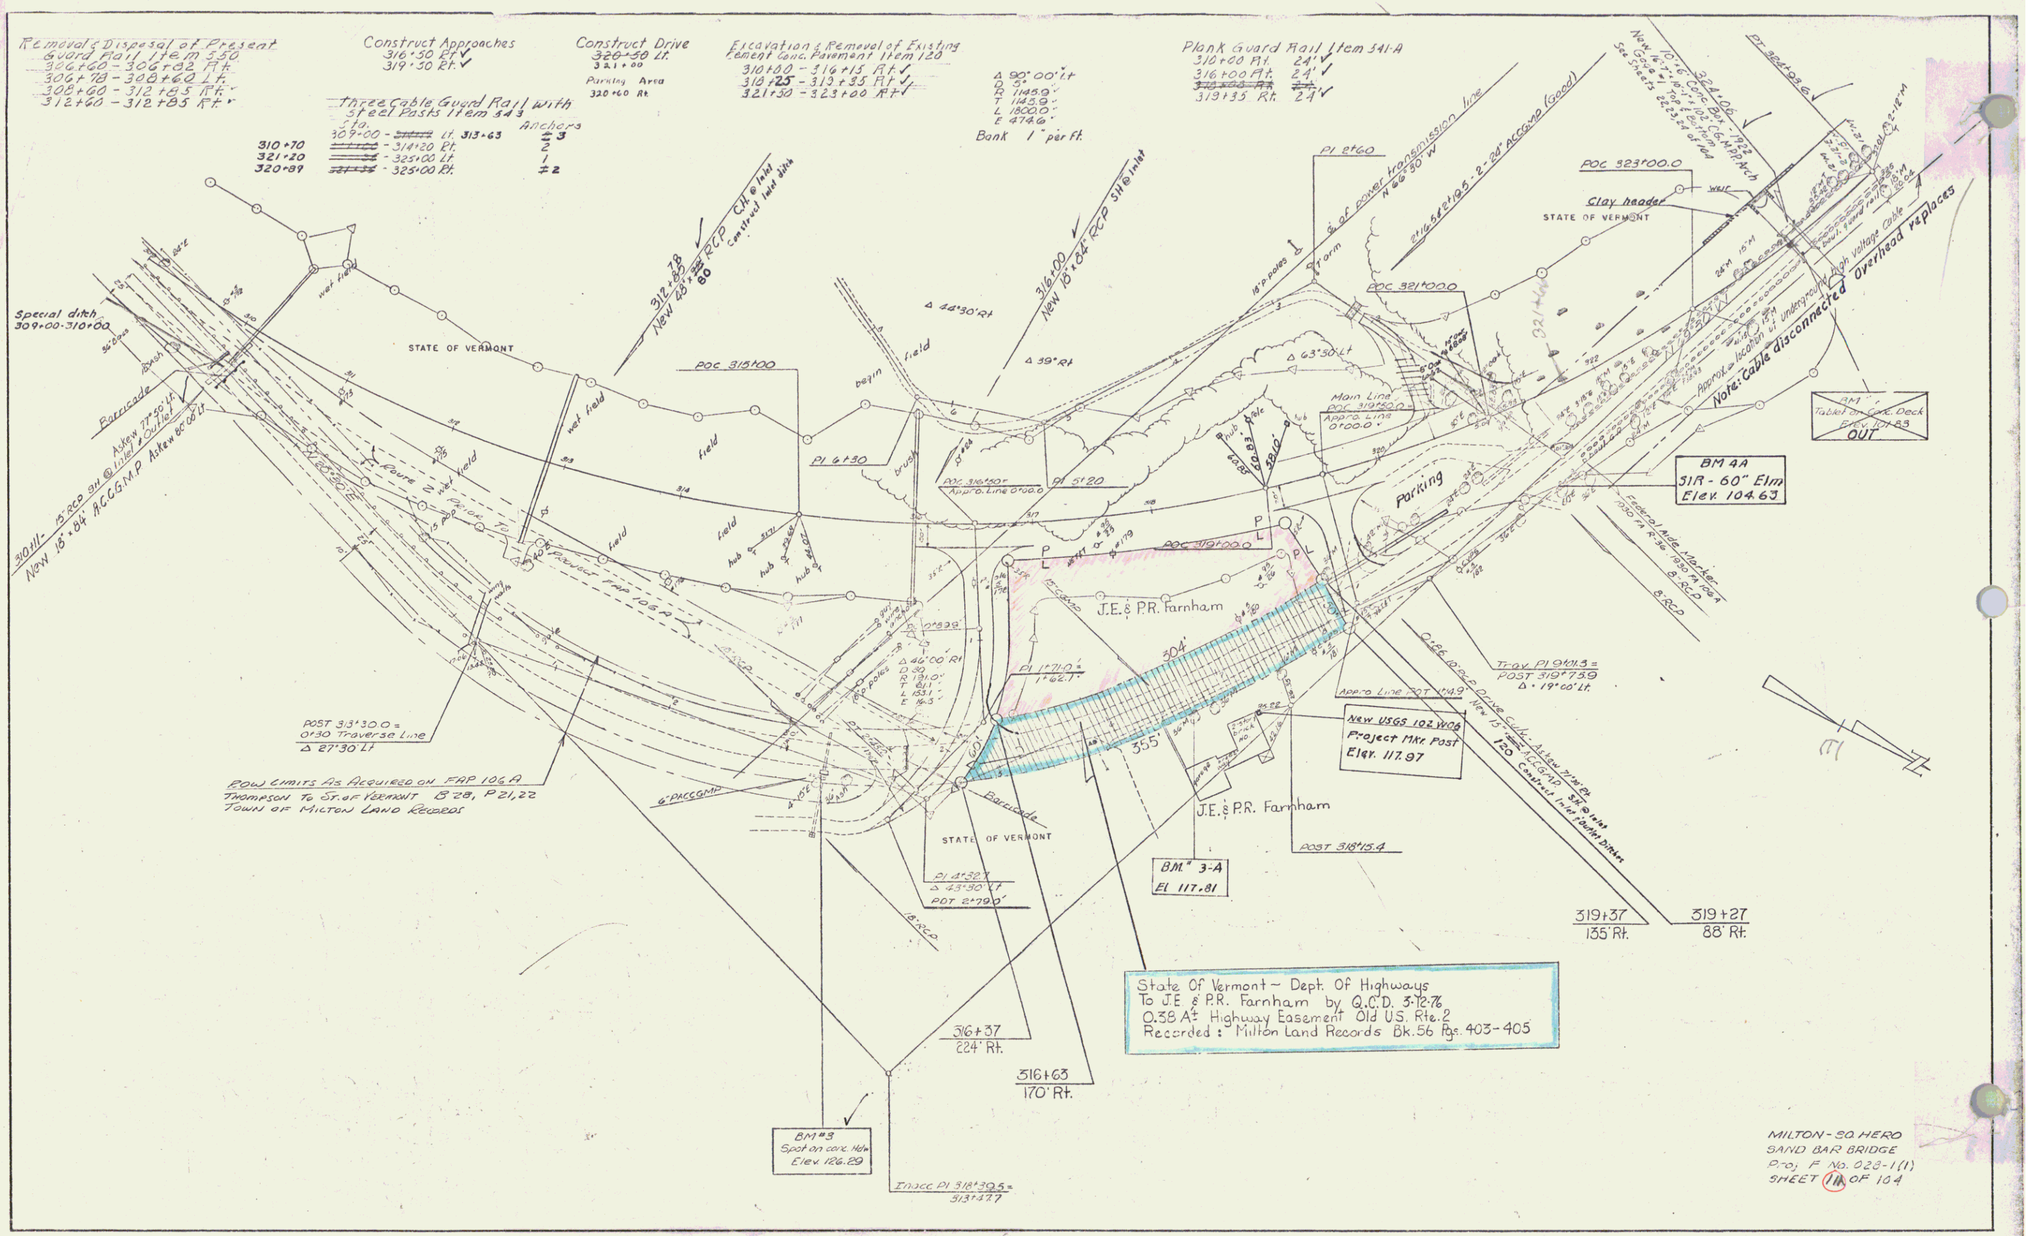

State Of Vermont ~ Dept. Of Highways
To J.E. & P.R. Farnham by Q.C.D. 3-12-76
0.38 Ac. Highway Easement Old U.S. Rte. 2
Recorded: Milton Land Records Bk. 56 Pgs. 403-405

MILTON - SO. HERO
SAND BAR BRIDGE
Proj. F No. 023-1(1)
SHEET 11 OF 104

4