Riprap for Bank Protection
Item 526
421+00 Lt - 435+85 Lt ✓
421+00 Rt - 435+50 Rt ✓
436+74 Lt - 437+00 Lt ✓

Three Cable Guard Rail with
Steel Posts Item 543

Sta.		Anchors
421+00 - 435+71	Lt	6 ✓
421+00 - 435+71	Rt	7 ✓
436+88 - 437+00	Lt	1 ✓
436+88 - 437+00	Rt	1 ✓

Removal & Resetting Present
Riprap Item 527
421+00 Lt - 435+85 Lt ✓
436+74 Lt - 437+00 Lt ✓

Removal & Disposal of Present
Guard Rail Item 538
434+15 - 438+65 ✓

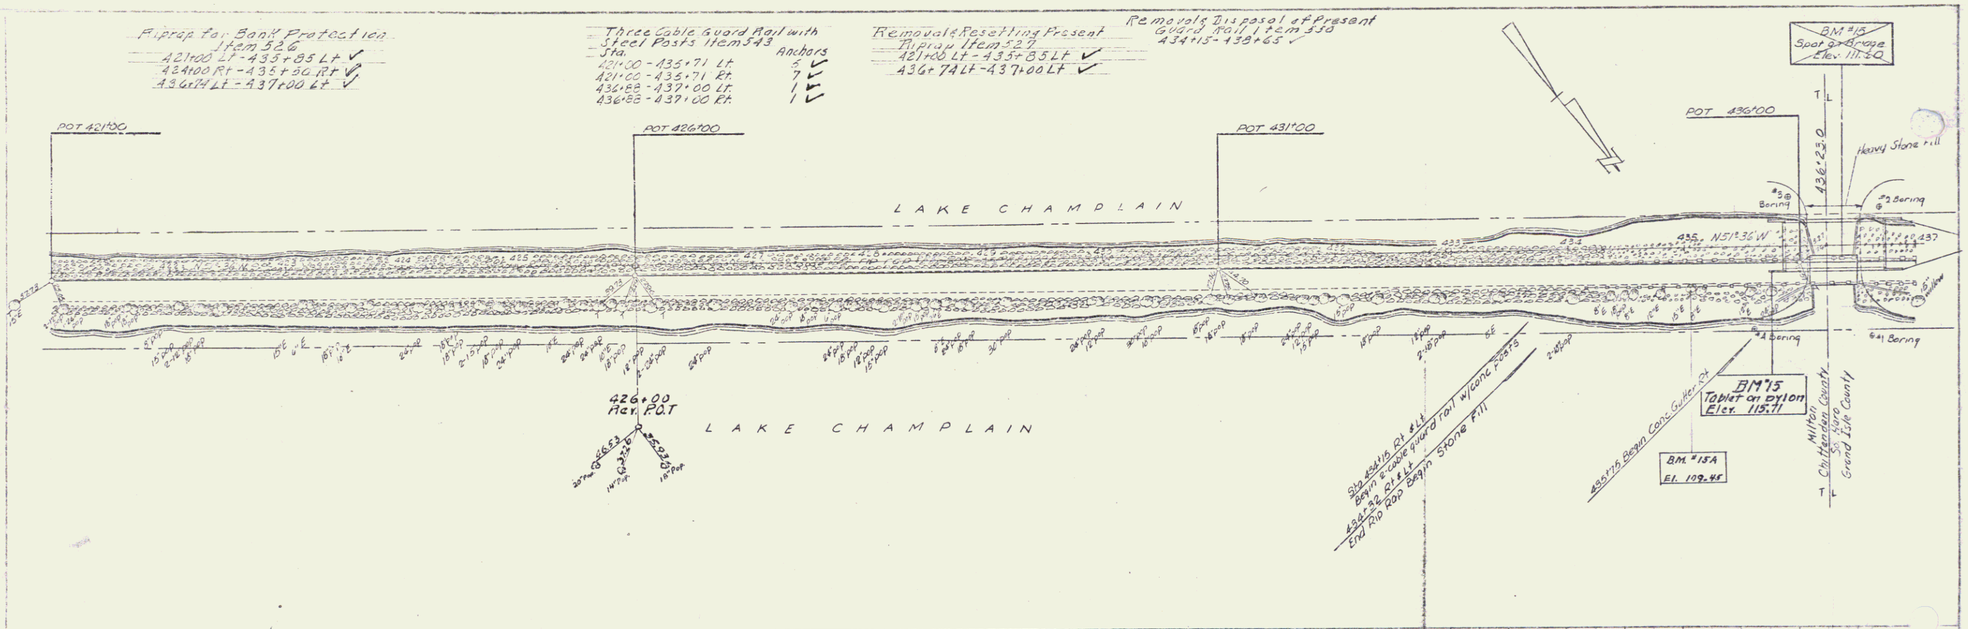

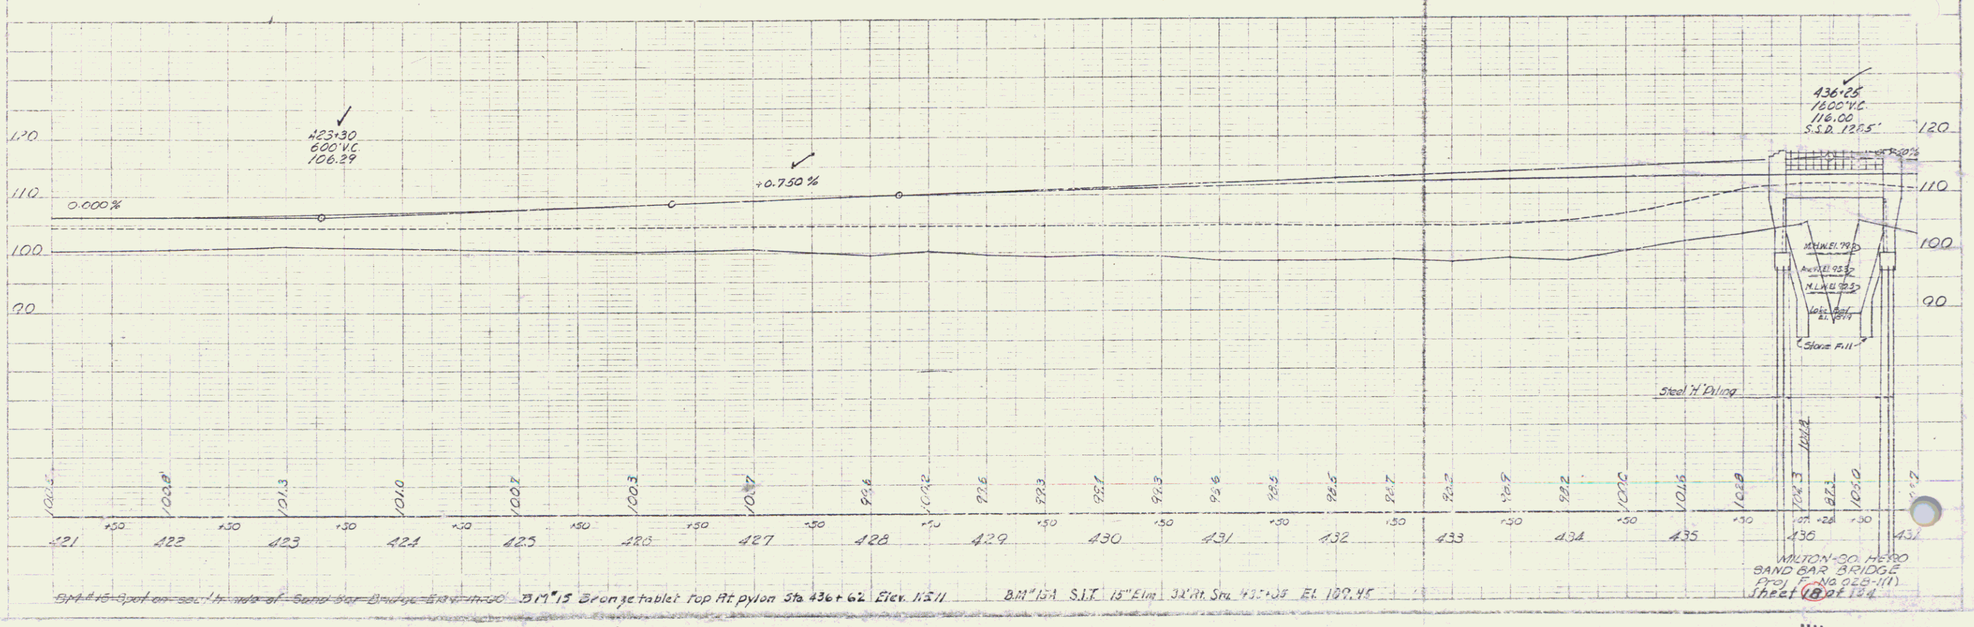

~~BM #15 Spot on sout'h side of Sand Bar Bridge Elev. 117.20~~ BM #15 Bronze tablet top Pt. pylon Sta. 436+62 Elev. 115.11 BM #15A S.I.T. 15" Elm 34' Rt. Sta. 437+05 El. 109.45

MILTON-SO. HERO
SAND BAR BRIDGE
Proj. F-NO 028-1(1)
Sheet 18 of 184

JUL - 8 1974

12