CABLE GUARD RAIL REQUIRED

-DN LEFT-

STA 0+00 - STA 0+96 LENGTH 96 LN FT

-DN RIGHT-

STA 0+00 - STA 3+00 LENGTH 300 LN FT

TOTAL FOR SHEET 396 LN FT

V.C.

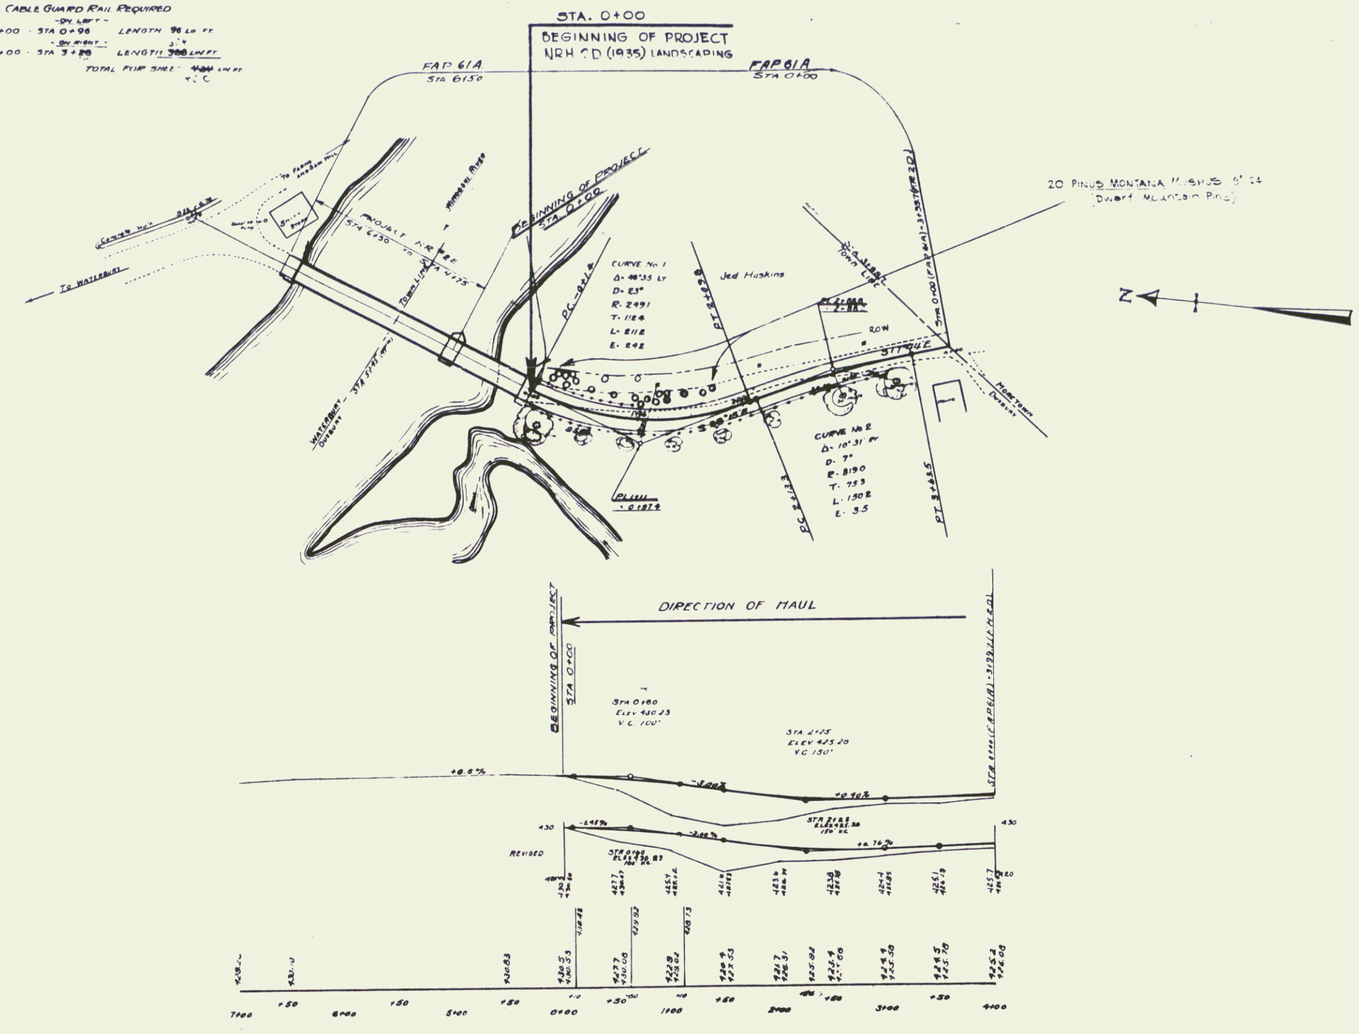

2