New Wood Guard Rail Required

~ On Left ~		
Sta 41+88 to Sta 42+12	Length	24 Lin Ft
Sta ~~49+08 to Sta 49+32~~		~~24~~
~ On Right ~		
Sta 42+10 to Sta 42+34	"	24 "
Sta 48+08 to Sta 48+32	"	24 "
Total for Sheet		96 Lin Ft

New Culverts Required
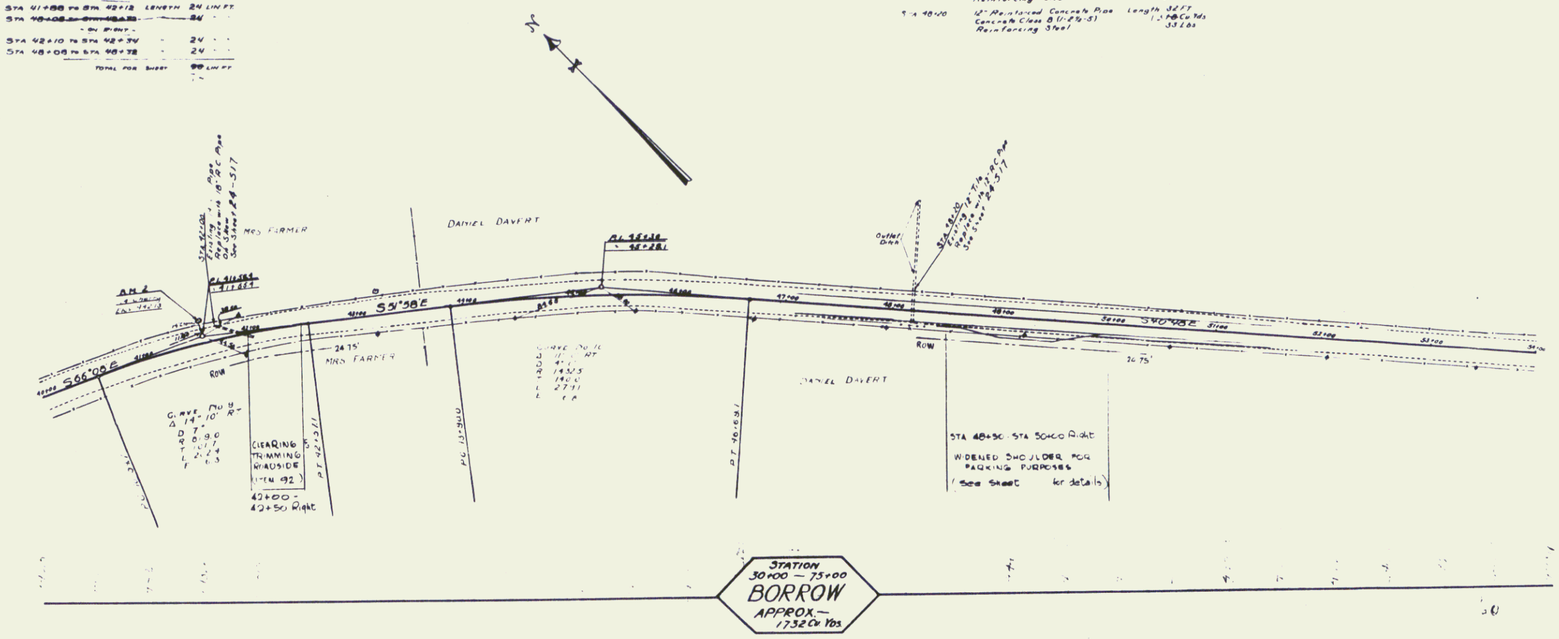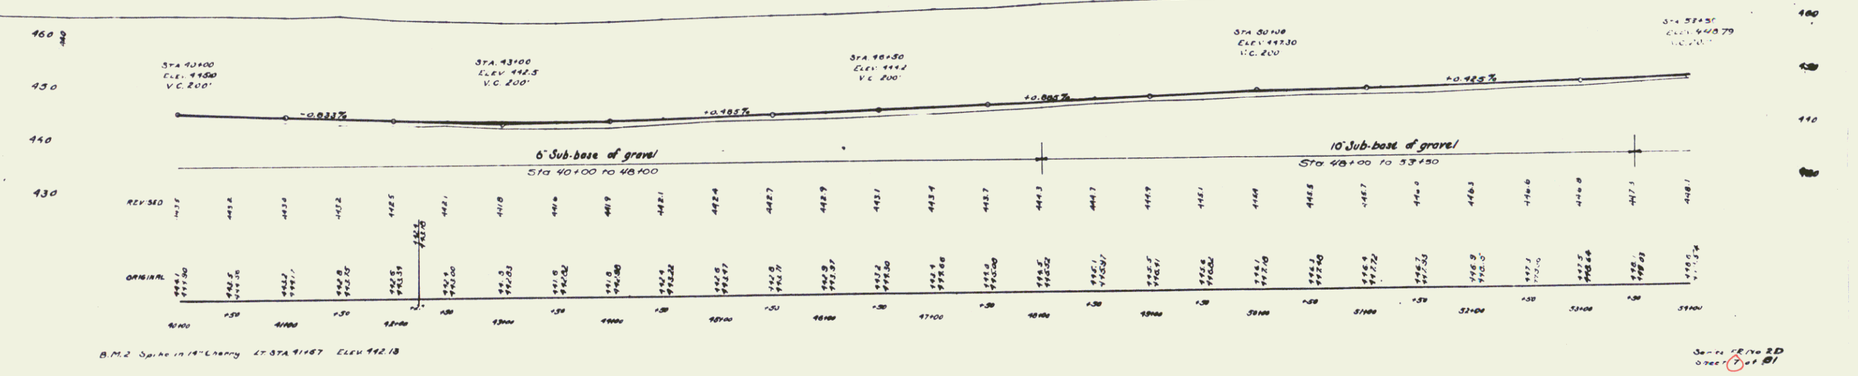
Sta 42+00	18" Reinforced Concrete Pipe	Length	40 Ft
	Concrete Class A (1:2:4)		1.9 Cu Yds
	Reinforcing Steel		59 Lbs
Sta 48+00	12" Reinforced Concrete Pipe	Length	32 Ft
	Concrete Class B (1:2½:3)		1.48 Cu Yds
	Reinforcing Steel		33 Lbs