NEW CABLE GUARD RAIL REQUIRED

111.15C			91
STA [illegible] to STA 101+00	LENGTH	[illegible]	
[illegible]		600	
TOTAL FOR SHEET		[illegible]	LIN FT

NEW WOOD GUARD RAIL REQUIRED

— ON LEFT —		
STA 98+35 to STA 98+89	"	36 "
STA 108+23 to STA 108+47	"	24 "
— ON RIGHT —		
STA 97+00 to STA 97+48	"	48 "
STA 98+35 to STA 98+89	"	36 "
STA 101+64 to STA 101+88	"	24 "
STA 102+75 to STA 102+99	"	24 "
STA 108+23 to STA 108+47	"	24 "
TOTAL FOR SHEET		[illegible] LIN FT

NEW CULVERTS REQUIRED - 1.

STA. 98+48 18" REINFORCED CONCRETE PIPE [illegible] LONG
REINFORCED CONCRETE CLASS B (1-2½-3) [illegible] CU YDS.
REINFORCING STEEL [illegible] LBS.
STA. 101+76 18" REINFORCED CONCRETE PIPE 36 LONG.
REINFORCED CONCRETE [illegible] CU YDS. CLASS A (1-2-4) 3.2
REINFORCING STEEL 39 LBS.
STA. 102+85 30" REINFORCED CONCRETE PIPE 40' LONG
REINFORCED CONCRETE CLASS A (1-2-4) [illegible] CU YDS.
REINFORCING STEEL [illegible] LBS.
STA. 108+35 24" REINFORCED CONCRETE PIPE 44 LONG
REINFORCED CONCRETE CLASS A (1-2-4) [illegible] CU YDS.
REINFORCING STEEL [illegible] LBS.

BANK PROTECTION
STA. 93+00-108+00 LEFT

Rock obtained from ledge at STA 98+78 & 1[illegible]+00± and 162+00± shall be used as material for bank protection. STA 93+00-108+00 LEFT and considered as rock embankment a non-pay item. The balance of material necessary for bank protection shall be paid for as stone fill, item 60.

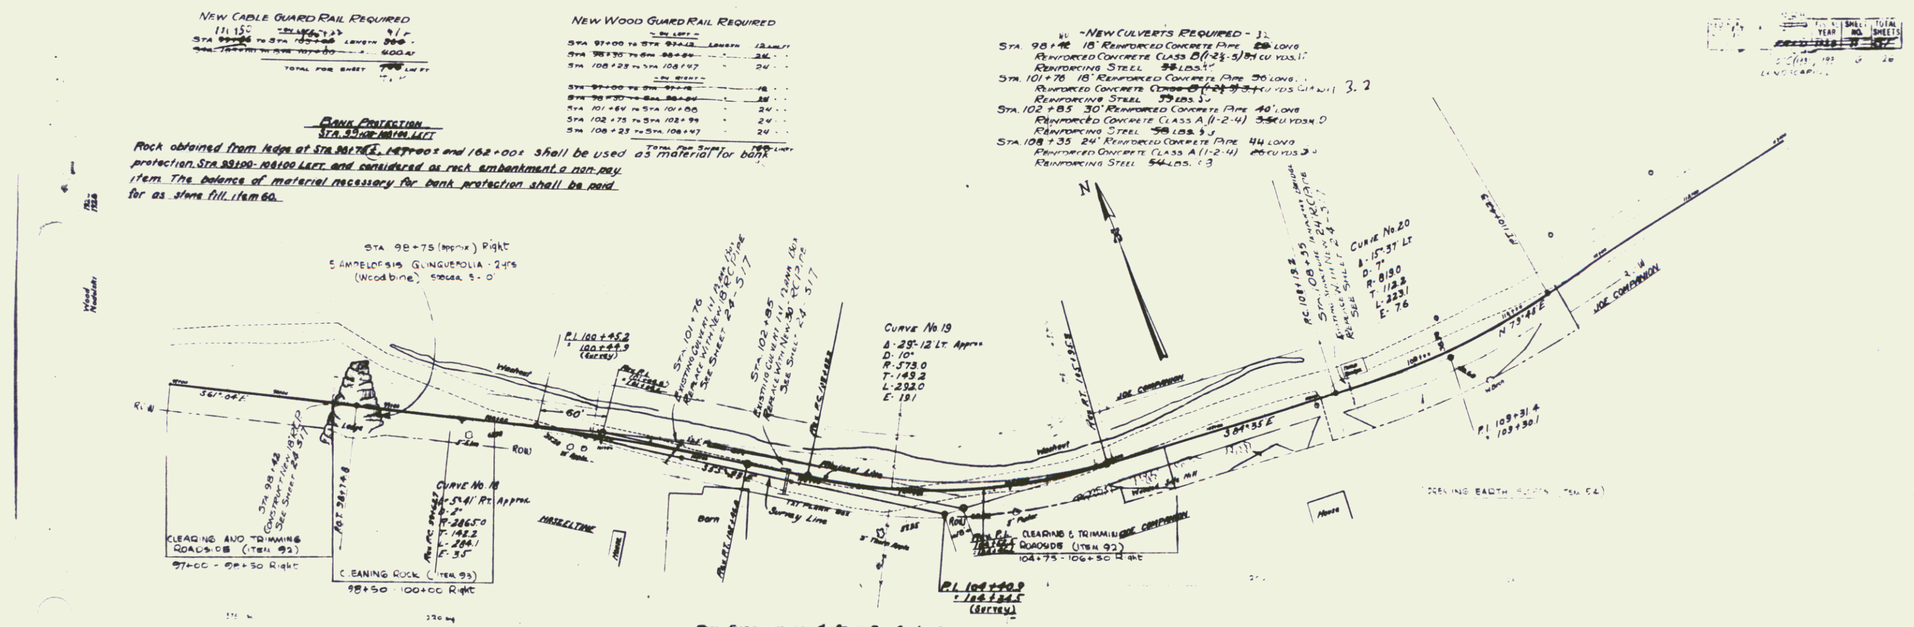
STA 98+75 (approx) Right
(Woodbine) Stocks 5-0"
CURVE No 19
Δ-29°-12 Lt Approx
D-10°
R-573.0
T-149.2
L-292.0
E-19.1
CURVE No 20
Δ-15°-37 Lt
D-7°
R-819.0
T-112.3
L-223.1
E-7.6
CURVE No 18
Δ-5°-41 Rt Approx
D-2°
R-2865.0
T-142.2
L-284.1
E-3.5
CLEARING AND TRIMMING ROADSIDE (ITEM 92)
97+00 - 98+50 Right
CLEANING ROCK (ITEM 93)
98+50 - 100+00 Right
CLEARING & TRIMMING ROADSIDE (ITEM 92)
104+75 - 106+50 Right
P.I. 100+45.2
100+44.9
(Survey)
P.I. 104+40.9
104+34.5
(Survey)
P.I. 109+31.4
109+30.1
N 73°-44 E
S 84°-35 E
S 61°-04 E
Survey Line
Barn
House
