NEW CABLE GUARD RAIL REQUIRED

STA 114+80 TO STA 118+50 LENGTH 372 LIN FT

STA 115+55 TO STA 116+50 95

TOTAL FOR SHEET 467 LIN FT

-NEW CULVERTS REQUIRED-

STA 115+75 3'x3' REINFORCED CONCRETE BOX CULVERT

REINFORCED CONCRETE 140 CU YDS

REINFORCING STEEL 1050 LBS

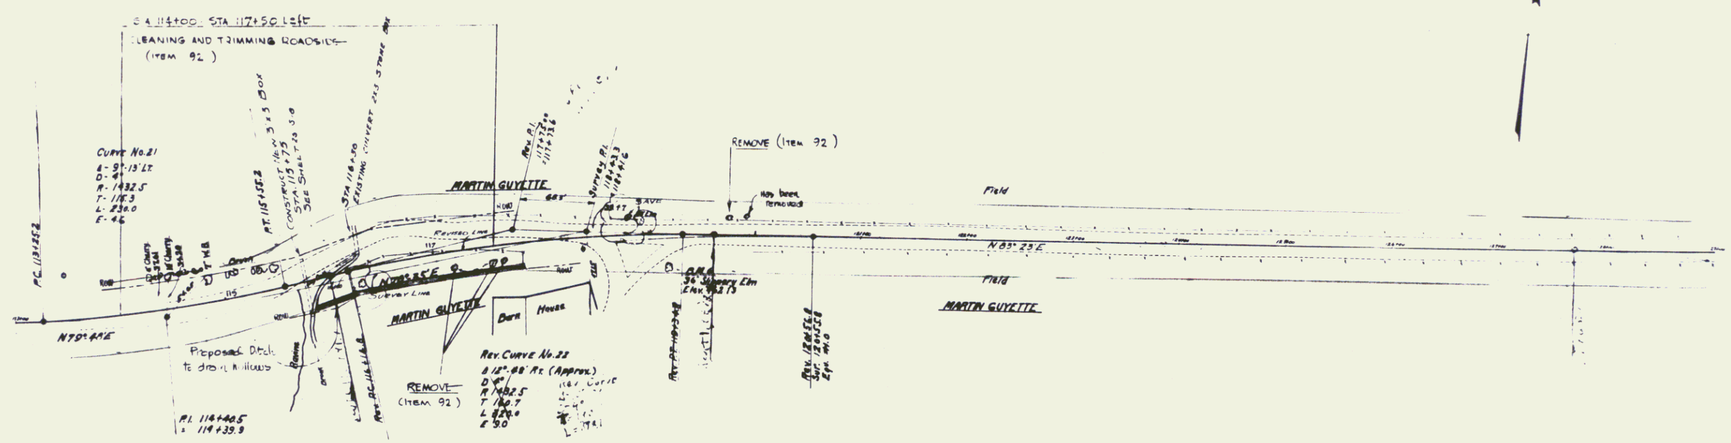

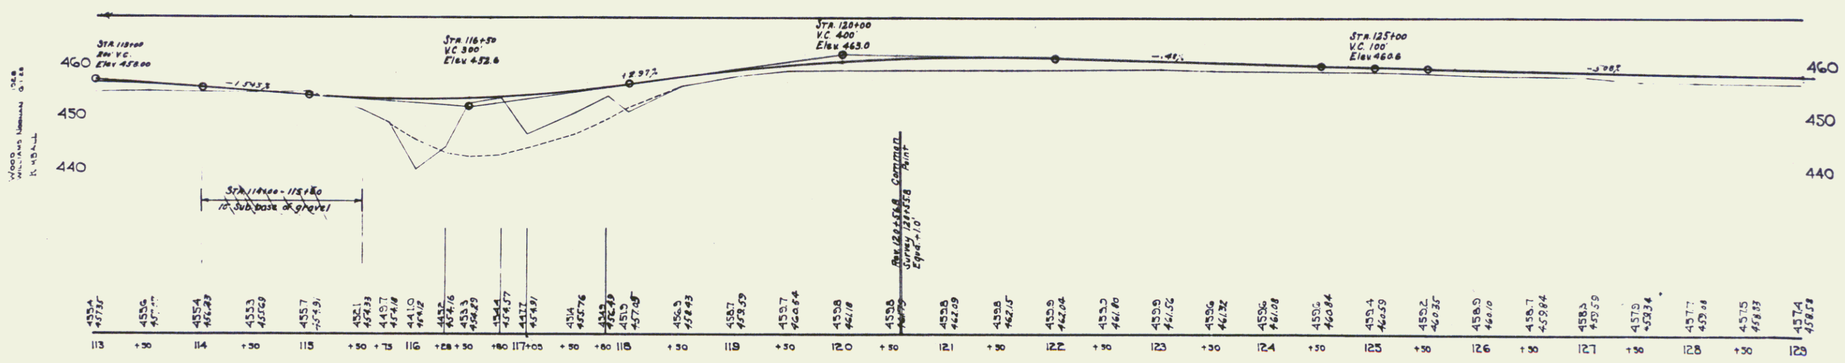

B.M. No. 6 Spike in root of 36" Slippery Elm, 24' Rt. Sta. 119+11. Elev. 462.13

SEP. 59 VRH 107-C (1955) LAY: SCALE NG

SHEET 7 OF 26

4