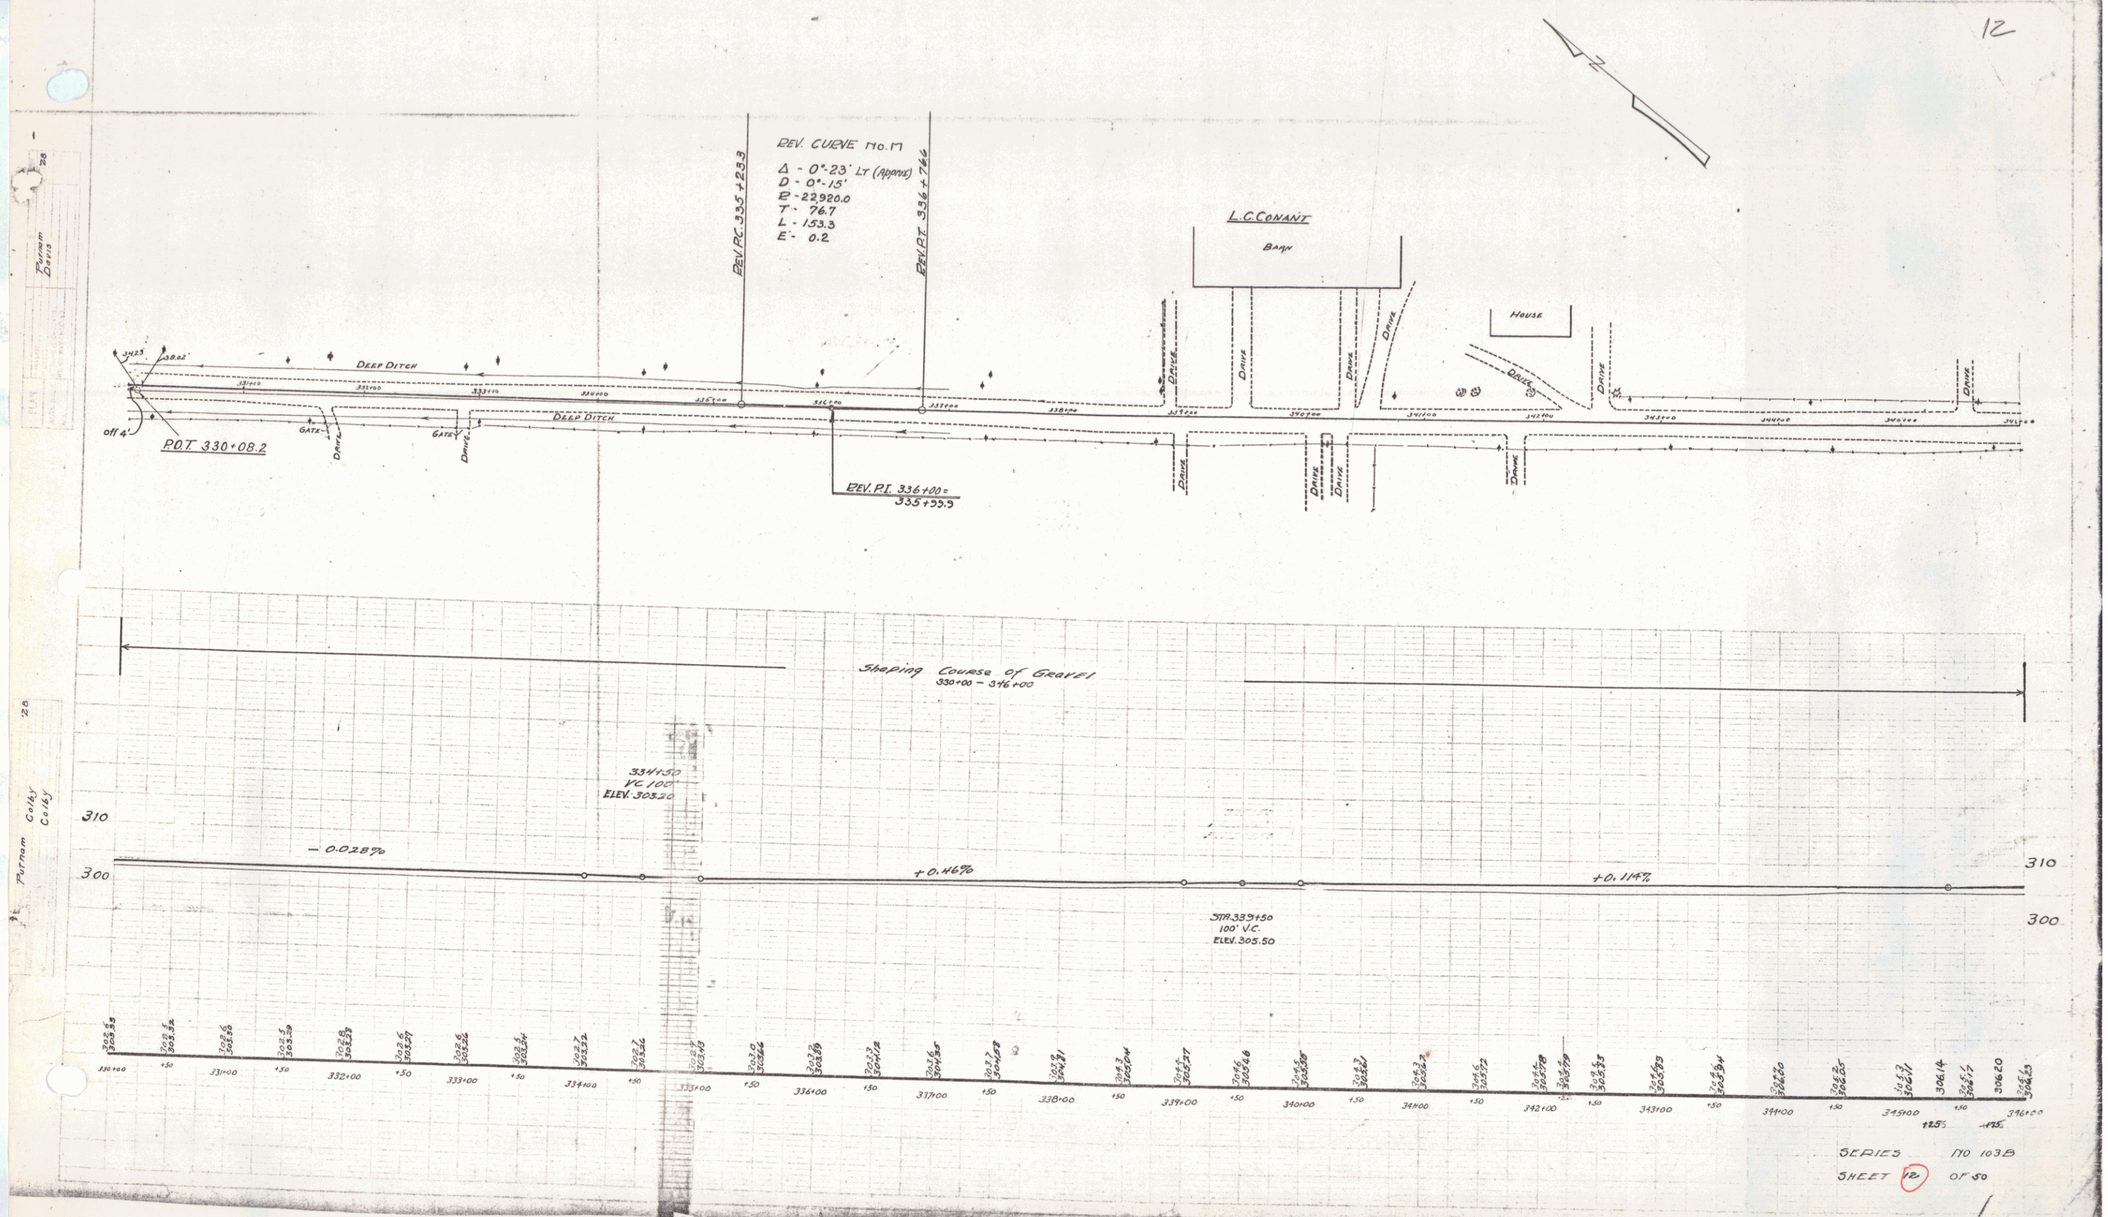
REV. CURVE No. 17
Δ - 0°-23' Lt (Approx)
D - 0°-15'
R - 22,920.0
T - 76.7
L - 153.3
E - 0.2
REV. P.C. 335+23.3
REV. P.T. 336+76.6
L. C. CONANT
BARN
HOUSE
DEEP DITCH
DEEP DITCH
P.O.T. 330+08.2
off 4'
GATE
DRIVE
REV. P.I. 336+00 = 335+55.9
Shaping Course of Gravel
330+00 - 346+00
334+50
VC 100
ELEV. 303.20
- 0.028%
+0.46%
+0.14%
STA. 339+50
100' V.C.
ELEV. 305.50
310
300
SERIES M0 103B
SHEET 12 OF 50