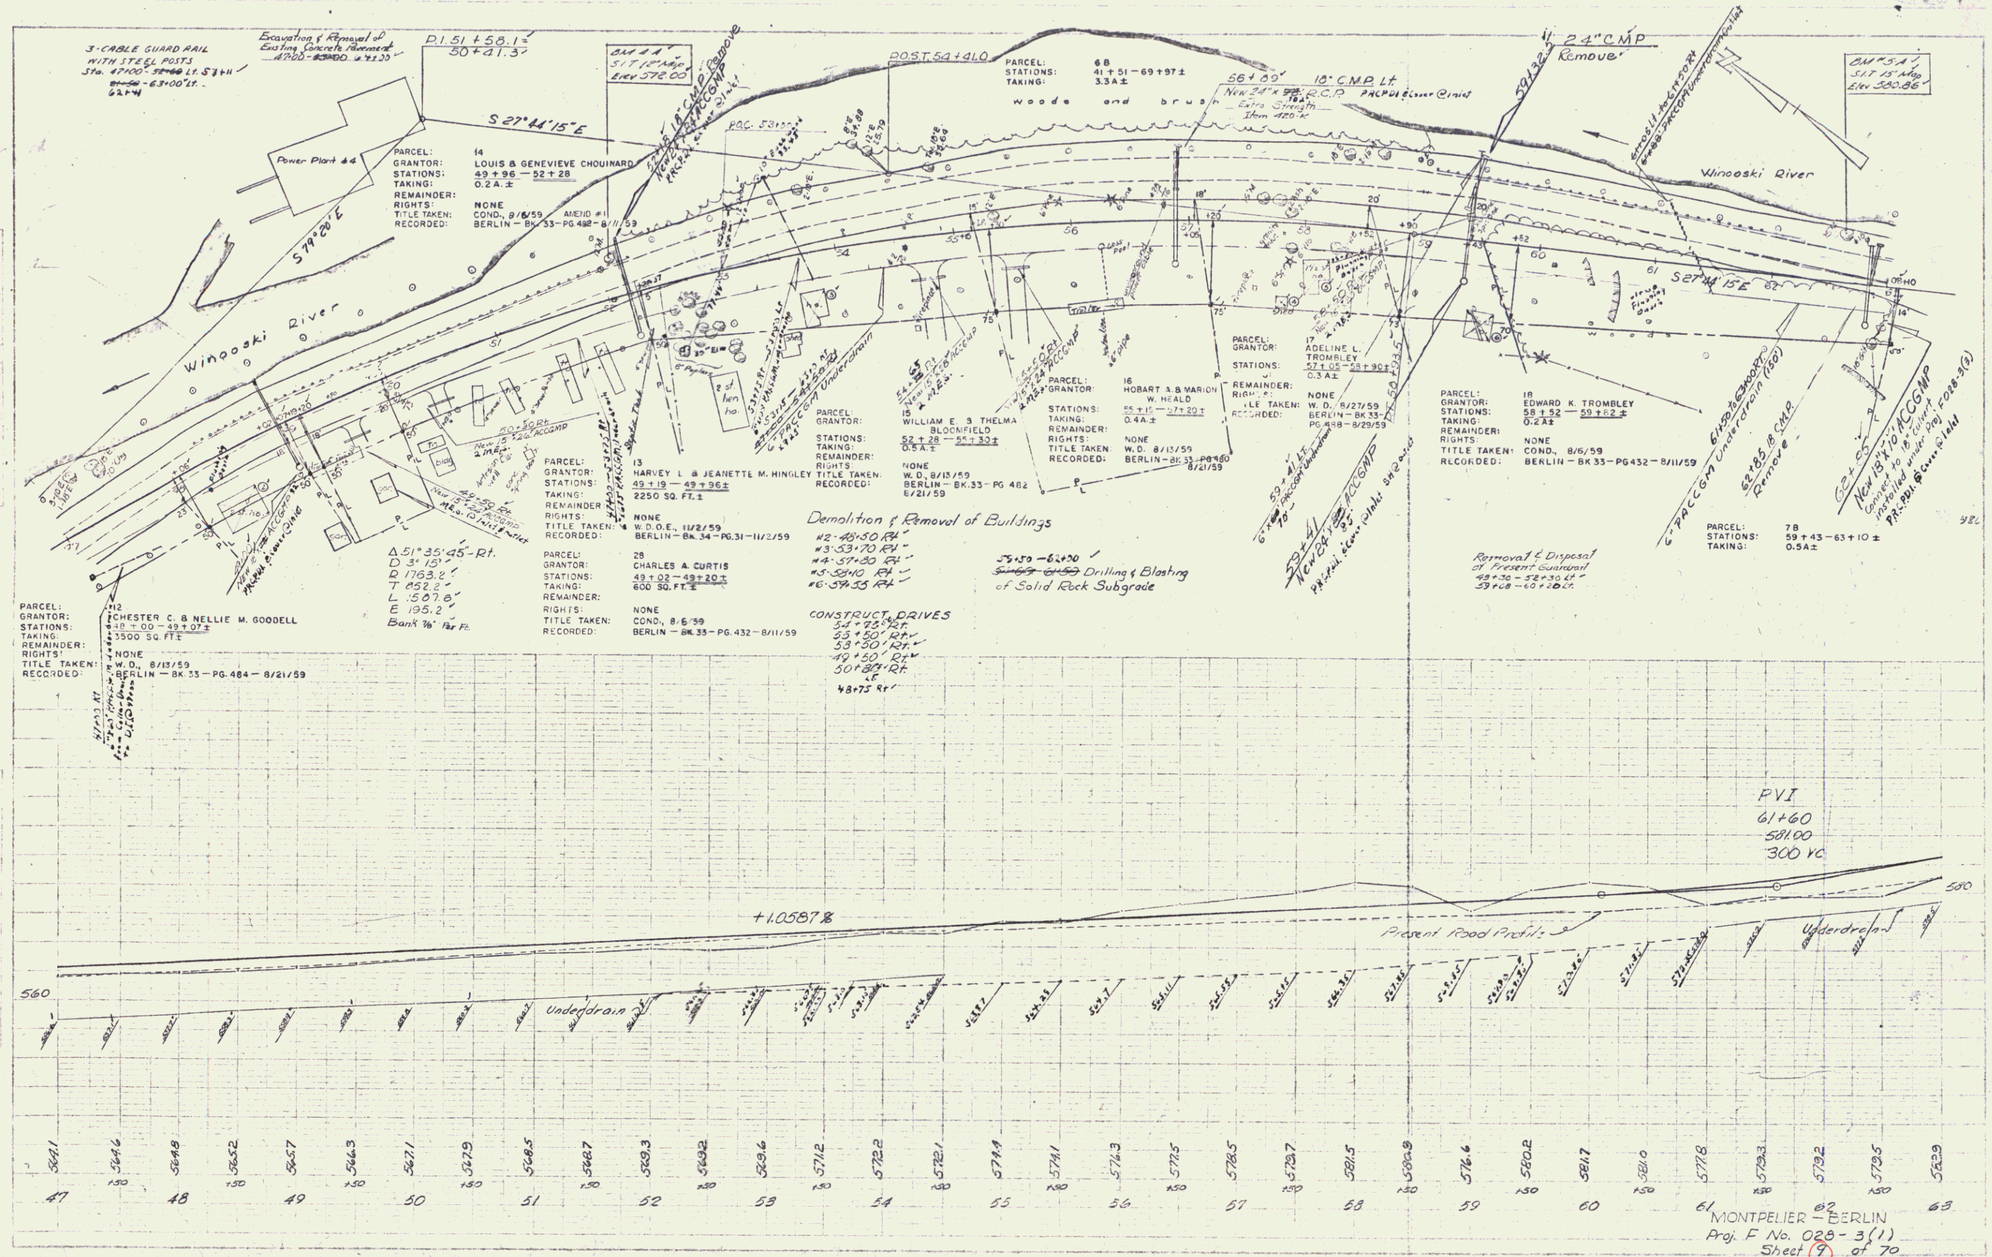
3-CABLE GUARD RAIL WITH ITEM POSTS
Excavation & Removal of Existing Concrete Pavement
PI 51 + 58.1
50 + 41.3
BM 4.4' SIT 12" Maple Elev 572.00
POST 54 + 41.0
S 27°44'15" E
S 19°20' E
Power Plant
Winooski River
PARCEL: 14
GRANTOR: LOUIS & GENEVIEVE CHOUINARD
STATIONS: 49 + 96 — 52 + 28
TAKING: 0.2 A ±
REMAINDER:
RIGHTS:
TITLE TAKEN: NONE
RECORDED: COND., 8/6/59 AMEND #1
BERLIN — BK. 33 — PG. 482 — 8/11/59
PARCEL: 68
STATIONS: 41 + 51 — 69 + 97 ±
TAKING: 3.3 A ±
woods and brush
56 + 80' 18" C.M.P. Lt.
New 24" x 18" R.C.P.
Extra Strength
Item 420
24" CMP Remove
BM 5.4' SIT 15" Maple Elev 580.86
Winooski River
S 27°44'15" E
PARCEL: 13
GRANTOR: HARVEY L. & JEANETTE M. HINGLEY
STATIONS: 49 + 19 — 49 + 96 ±
TAKING: 2250 SQ. FT. ±
REMAINDER:
RIGHTS: NONE
TITLE TAKEN: W. D. O.E., 11/2/59
RECORDED: BERLIN — BK. 34 — PG. 31 — 11/2/59
PARCEL: 28
GRANTOR: CHARLES A. CURTIS
STATIONS: 49 + 02 — 49 + 20 ±
TAKING: 600 SQ. FT. ±
REMAINDER:
RIGHTS:
TITLE TAKEN: NONE
RECORDED: COND., 8/6/59
BERLIN — BK. 33 — PG. 432 — 8/11/59
Δ 51°35'45" Rt.
D 3°15'
R 1763.2'
T 852.2'
L 1507.8'
E 195.2'
PARCEL: 12
GRANTOR: CHESTER C. & NELLIE M. GOODELL
STATIONS: 48 + 00 — 49 + 07 ±
TAKING: 3500 SQ. FT. ±
REMAINDER:
RIGHTS: NONE
TITLE TAKEN: W. D., 8/13/59
RECORDED: BERLIN — BK. 33 — PG. 484 — 8/21/59
PARCEL: 15
GRANTOR: WILLIAM E. & THELMA BLOOMFIELD
STATIONS: 52 + 28 — 55 + 30 ±
TAKING: 0.5 A ±
REMAINDER:
RIGHTS:
TITLE TAKEN: NONE
RECORDED: W. D., 8/13/59
BERLIN — BK. 33 — PG. 482 — 8/21/59
PARCEL: 16
GRANTOR: HOBART J. & MARION W. HEALD
STATIONS: 55 + 15 — 57 + 50 ±
TAKING: 0.4 A. ±
REMAINDER:
RIGHTS:
TITLE TAKEN: NONE
RECORDED: W. D. 8/13/59
BERLIN — BK. 33 — PG. 480 — 8/21/59
PARCEL: 17
GRANTOR: ADELINE L. TROMBLEY
STATIONS: 57 + 05 — 58 + 90 ±
TAKING: 0.3 A ±
REMAINDER:
RIGHTS: NONE
TITLE TAKEN: W. D., 8/27/59
RECORDED: BERLIN — BK. 33 — PG. 488 — 8/29/59
PARCEL: 18
GRANTOR: EDWARD K. TROMBLEY
STATIONS: 58 + 52 — 59 + 62 ±
TAKING: 0.2 A ±
REMAINDER:
RIGHTS: NONE
TITLE TAKEN: COND., 8/6/59
RECORDED: BERLIN — BK. 33 — PG. 432 — 8/11/59
PARCEL: 78
STATIONS: 59 + 43 — 63 + 10 ±
TAKING: 0.5 A ±
Demolition & Removal of Buildings
#2 - 48+50 Rt
#3 - 53+70 Rt
#4 - 57+30 Rt
#5 - 58+10 Rt
#6 - 59+35 Rt
CONSTRUCT DRIVES
54 + 75' Rt.
55 + 50' Rt.
53 + 50' Rt.
49 + 50' Rt.
50 + 80' Rt.
48+75 Rt
59+50 — 62+00
Drilling & Blasting of Solid Rock Subgrade
Removal & Disposal of Present Guardrail
49+70 — 52+30 Lt.
59+68 — 60+28 Lt.
PVI
61+60
581.00
300 VC
+1.0587%
Present Road Profile
Underdrain
560
580
MONTPELIER — BERLIN
Proj. F No. 028-3(1)
Sheet 9 of 70