FED. DIV.	STATE	FED. PROJ. NO.	FISCAL YEAR	SHEET NO.	TOTAL SHEETS
1	VT.		FY78	9	77

CABLE GUARD RAIL REQUIRED
LEFT
STA. 101+26 – 102+78 Length 152 Ft.

WOOD GUARD RAIL REQUIRED

	LEFT	RIGHT
STA. 90+38 - 90+62	24 ft.	24 ft.
- 97+62 - 97+87	24 ft	24 ft.
- 102+55 - 102+79	—	24 ft.
91+15 - 91+39	24 ft.	24 ft.
95+45 - 95+69	—	24 ft.
94+32 - 94+57	—	24 ft.

NEW CULVERTS REQUIRED

STA. 90+50 LAY NEW 24" CAST IRON PIPE, Length 32 ft.
CONC. CLASS "A" (1-2-4) 2.6 cu. yds.
REINF. STEEL 54 lbs.

STA. 94+45 NEW 18" Cast Iron Pipe Length 36 ft.
Conc. Class "A" (1-2-4) 1.9 cu. yds.
Reinf. Steel 54 lbs.

STA. 97+75 NEW 18" Cast Iron Pipe, Length 36 ft.
Conc. Class "A" (1-2-4) 1.6 cu. yds.
Reinf. Steel "B" (1-2½-5) 44 lbs.
} Drop inlet with grate

STA. 102+66 NEW 18" Cast Iron Pipe Length 40 ft.
Conc. Class "B" (1-2½-5) 3.1 cu. yds.
Reinf. Steel 33 lbs.

STA. 96+00± 24" Cast Iron Pipe, Length 80 ft.
Conc. Class "B" (1-2½-5) 2.2 cu. yds.
Reinf. Steel 165 lbs.

Drop inlet with grate at low point at each 3.50 of roadway at underpass.

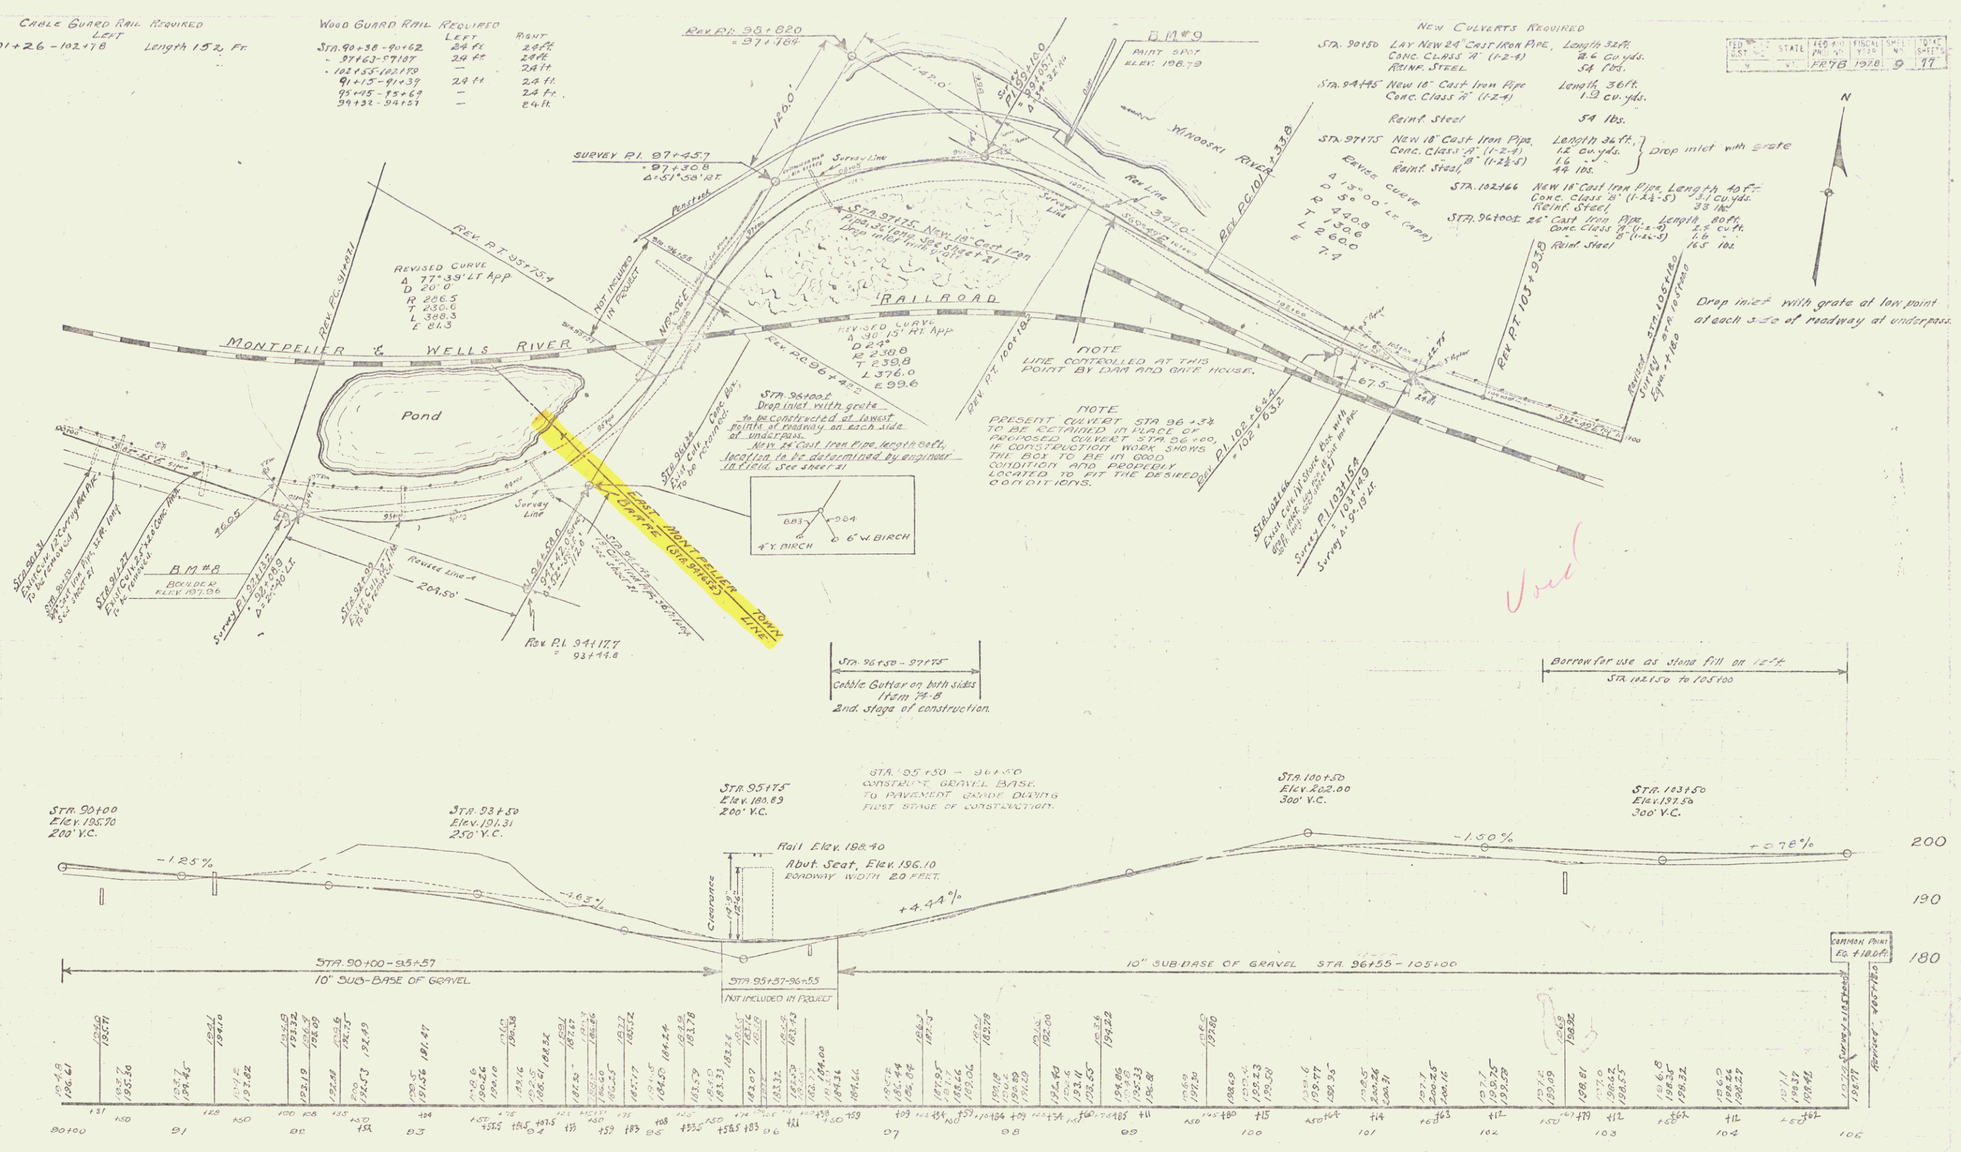

STA. 96+50 – 97+75
Cobble Gutter on both sides
Item 74-8
2nd. stage of construction.

Borrow for use as stone fill on 12" ft.
STA. 102+50 to 105+00

B.M. "9" PAINT SPOT ON CONCRETE FOUNDATION S.E. CORNER OF S-19 LEFT STA. 95+60± ELEV. 198.79

SERIES FP no. 78
SHEET 9 OF 77

7