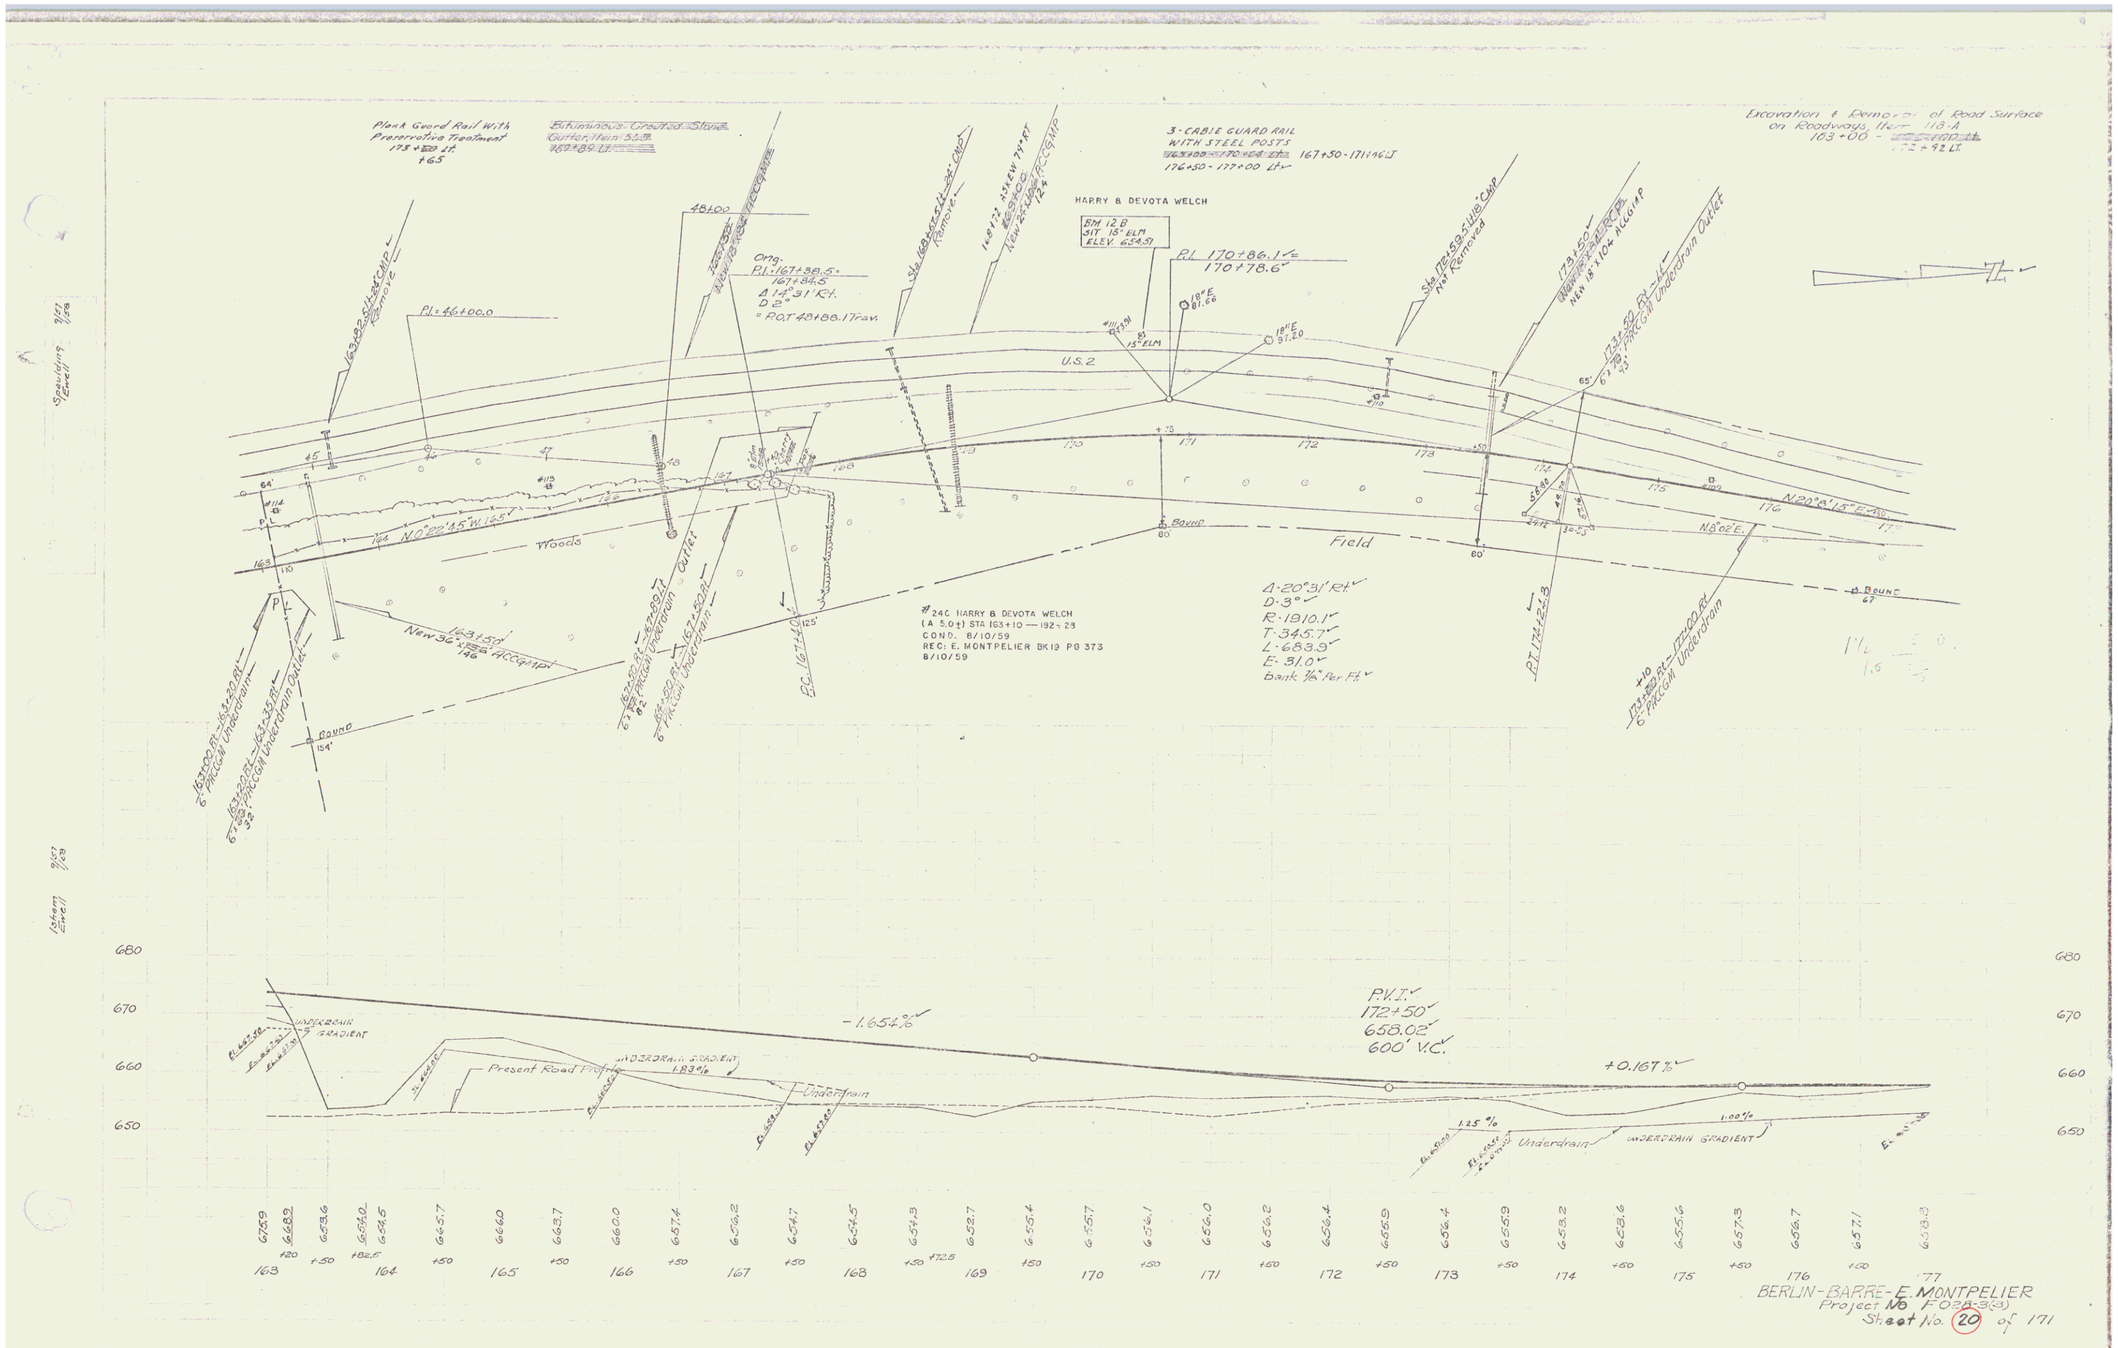

BERLIN-BARRE-E. MONTPELIER
Project No. F028-3(3)
Sheet No. 20 of 171

12