


POOR ORIGINAL COPY

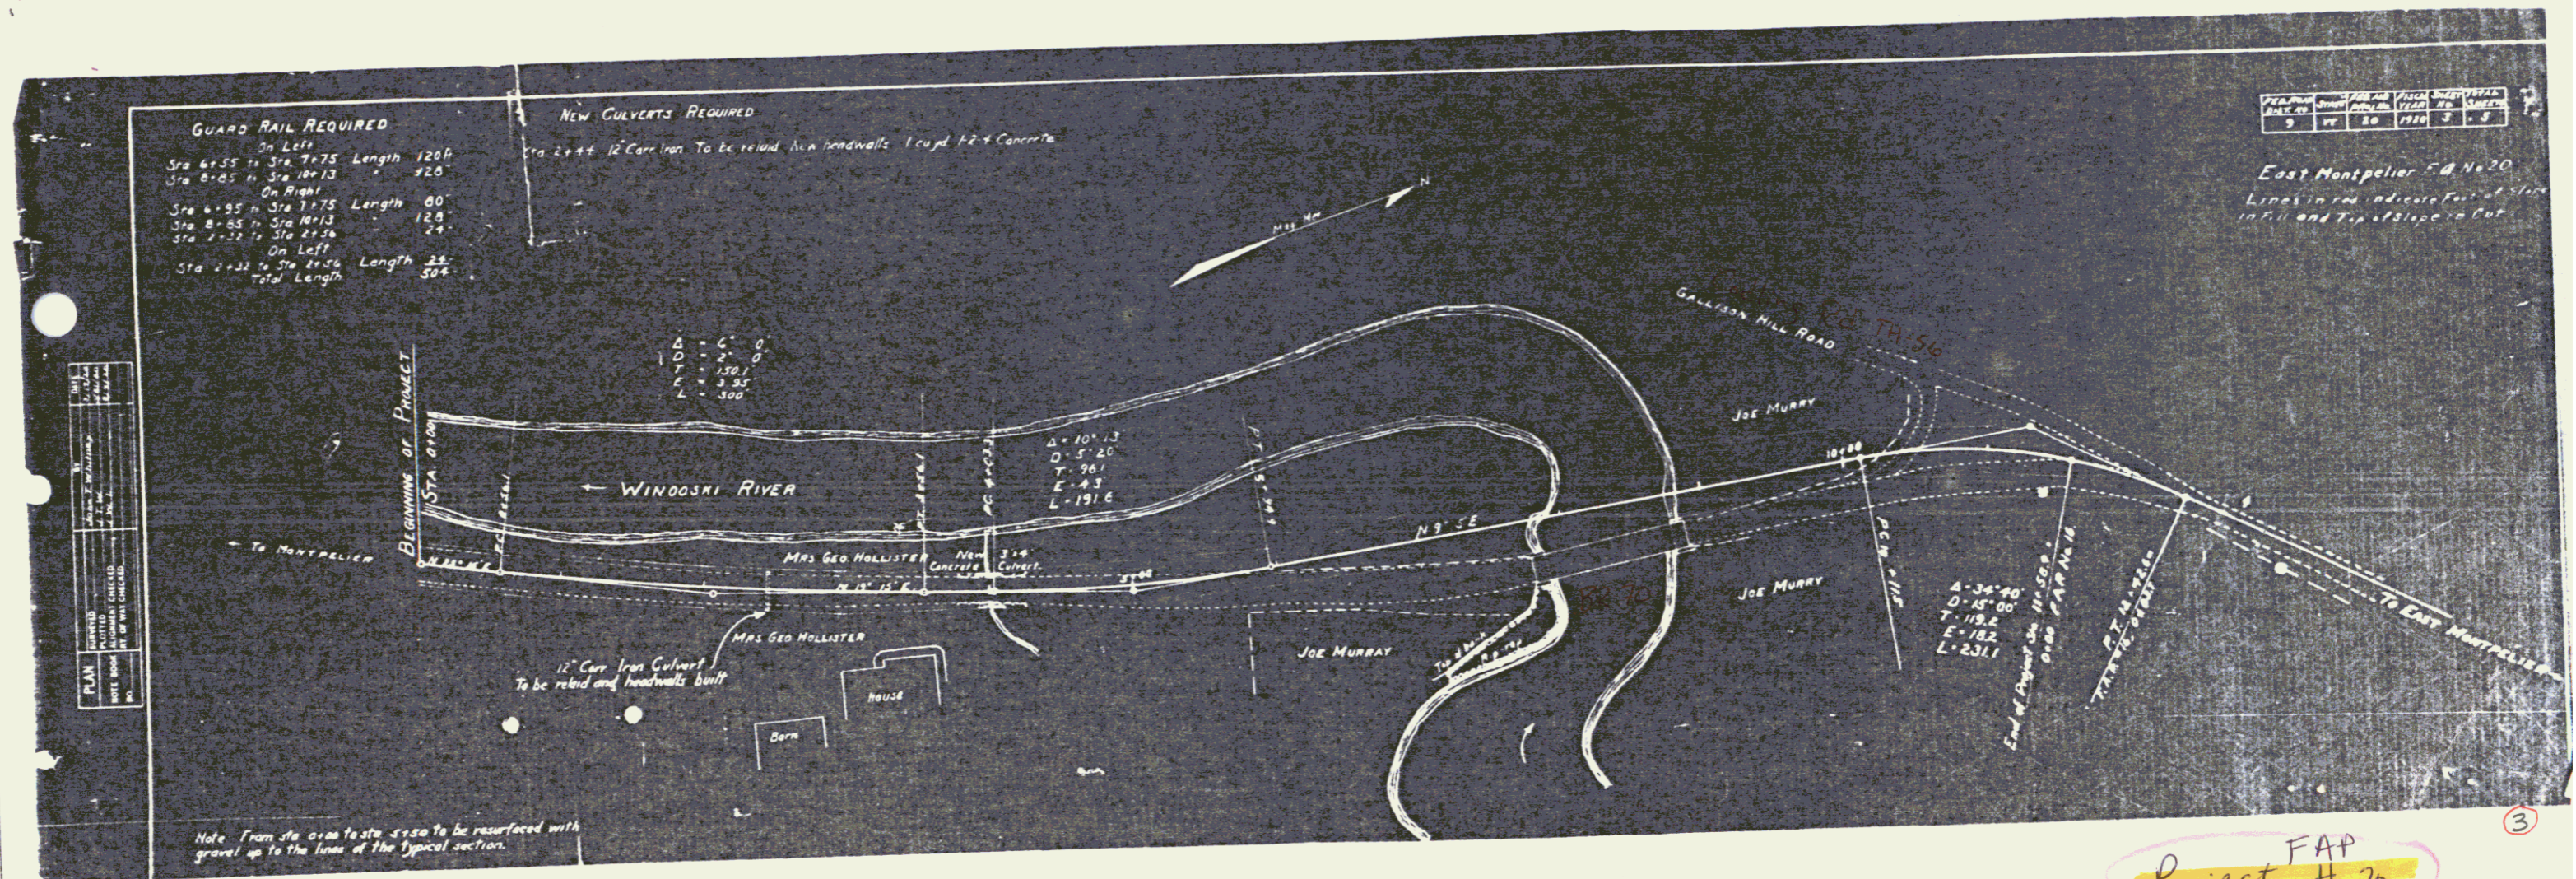

Project #20
 Town of East Montpelier
 US Route #2
 Pin # 99E118
 STEARNS R. JENKINS US2
 8/27/22