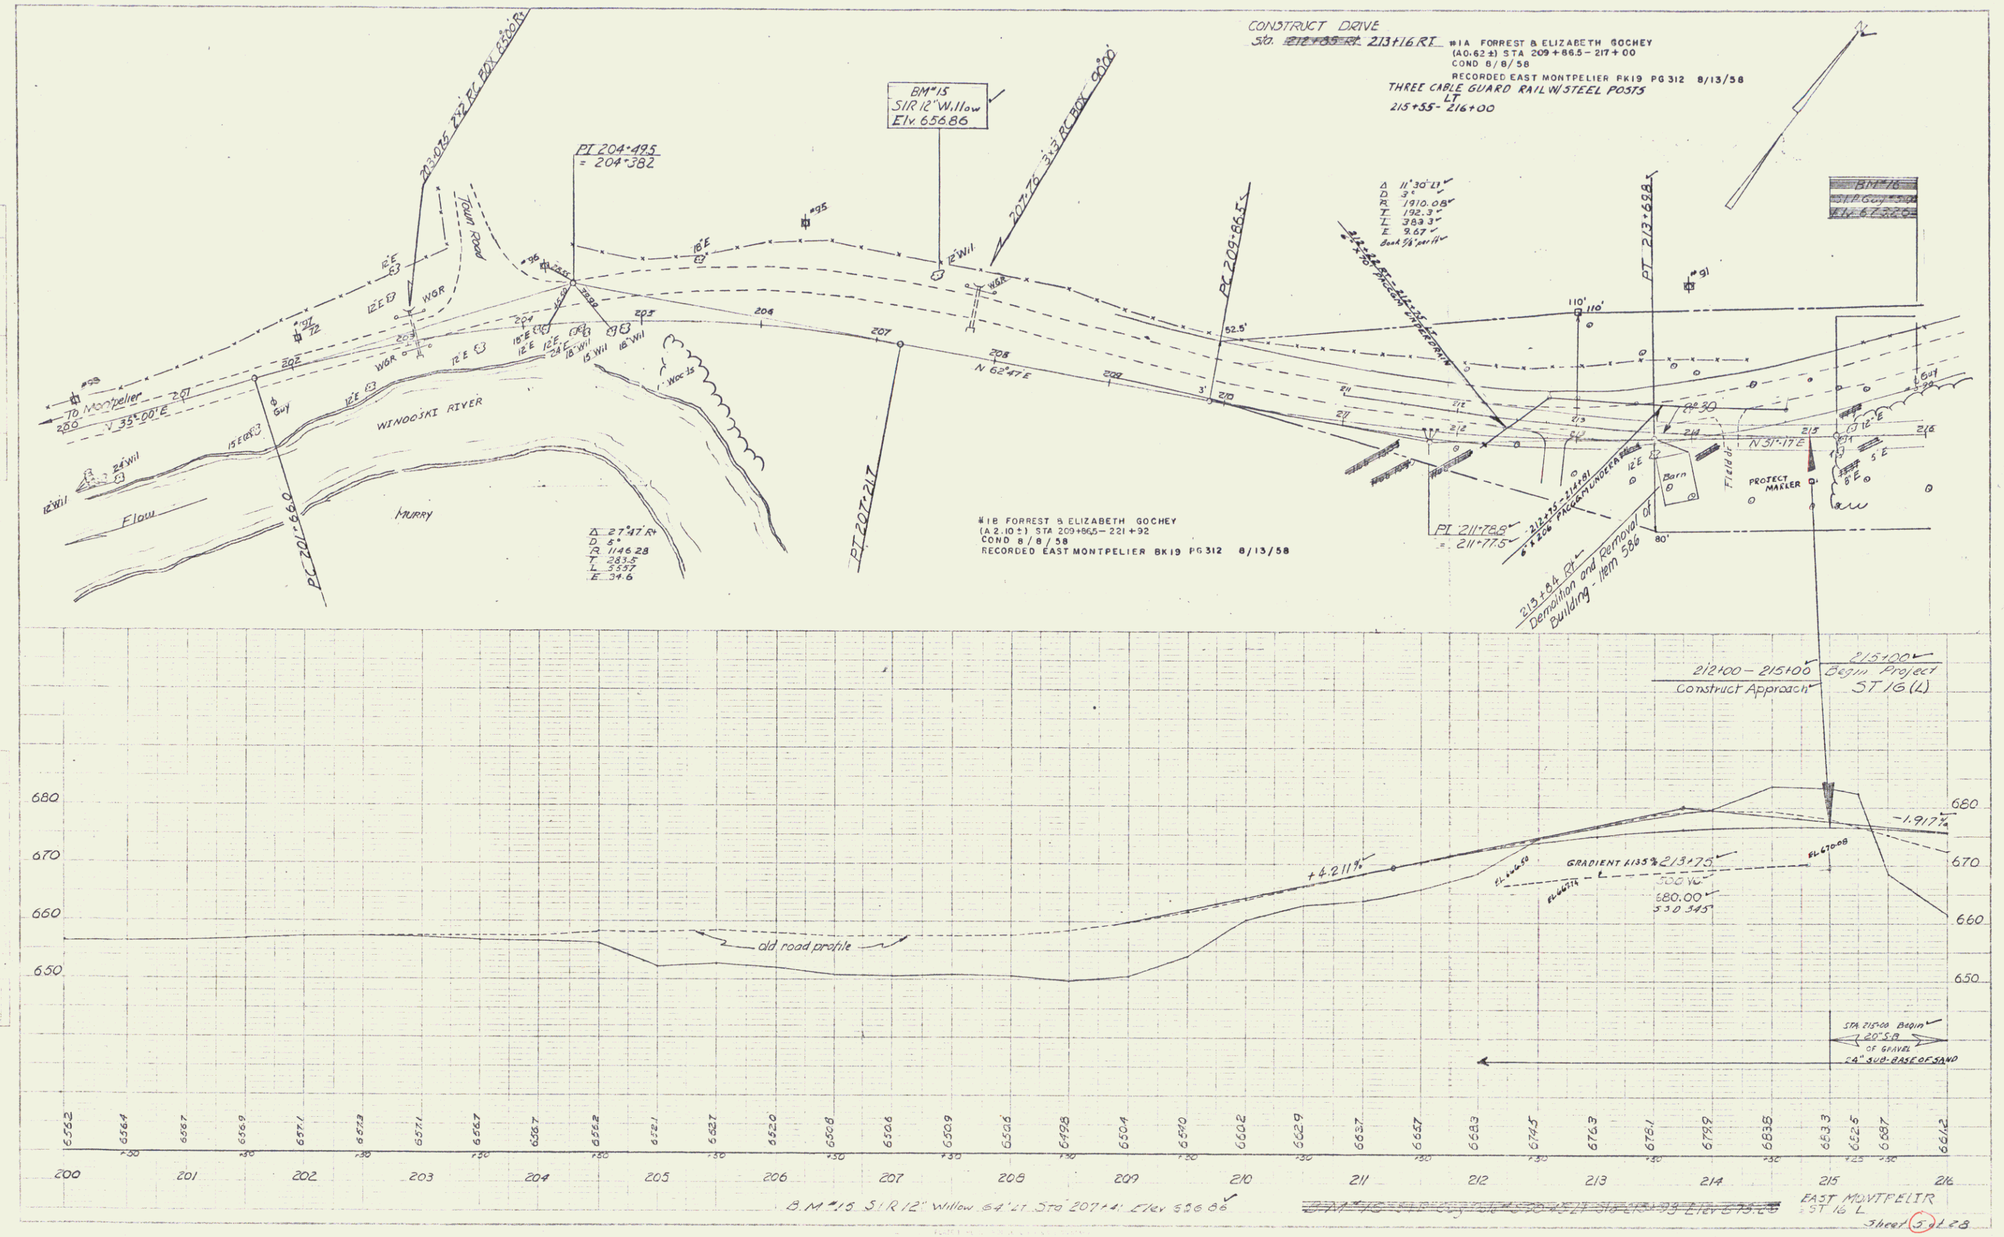
CONSTRUCT DRIVE
Sta. 213+16 RT
#1A FORREST & ELIZABETH GOCHEY
(A 0.62 ±) STA 209+86.5 – 217+00
COND 8/8/58
RECORDED EAST MONTPELIER BK19 PG 312 8/13/58
THREE CABLE GUARD RAIL W/STEEL POSTS
LT
215+55 – 216+00
BM #15
S1R 12" Willow
Elv. 656.86
PI 204+95
= 204+382
To Montpelier
N 33°00' E
WINOOSKI RIVER
Flow
Murry
Town Road
PC 201+66.0
PT 207+21.7
PC 209+86.5
PT 213+68.8
N 62°47' E
N 31°17' E
Barn
Field
#1B FORREST & ELIZABETH GOCHEY
(A 2.10 ±) STA 209+86.5 – 221+92
COND 8/8/58
RECORDED EAST MONTPELIER BK19 PG 312 8/13/58
PI 211+68.8
= 211+77.5
Demolition and Removal of Building - Item 586
212+00 – 215+00
Construct Approach
215+00
Begin Project
ST 16 (L)
+4.211%
-1.917%
GRADIENT 4.135%
215+75
680.00
530.345
old road profile
STA 215+00 Begin
20' S.R.
of GRAVEL
24" SUB-BASE OF SAND
B.M. #15 S1R 12" Willow 64' LT. Sta 207+4: Elev 656.86
EAST MONTPELIER
ST 16 L

2