Wood Guard Rail Required		
Culv. Sta	Left	Right
53+40	24'	24'
61+69	24'	24'

Rein. Conc. Pipe Culv. Required					
Sta.	Dia.	Long.	Conc. A	Conc. C	Steel
53+40	24"	32'	2.4 cy.		54 #
61+69	18"	32'	1.8 cy.		54 #

Cable Guard Rail Required					
Sta. - Sta.	L or R	Length	Constant	Pay Length	
48+74 - 50+50	R	176	40	216	

Fed. Aid Proj. No.	State	Fed. Aid Year	Fiscal Year	Sheet No.	Total Sheets
		97 D	1930	7	99

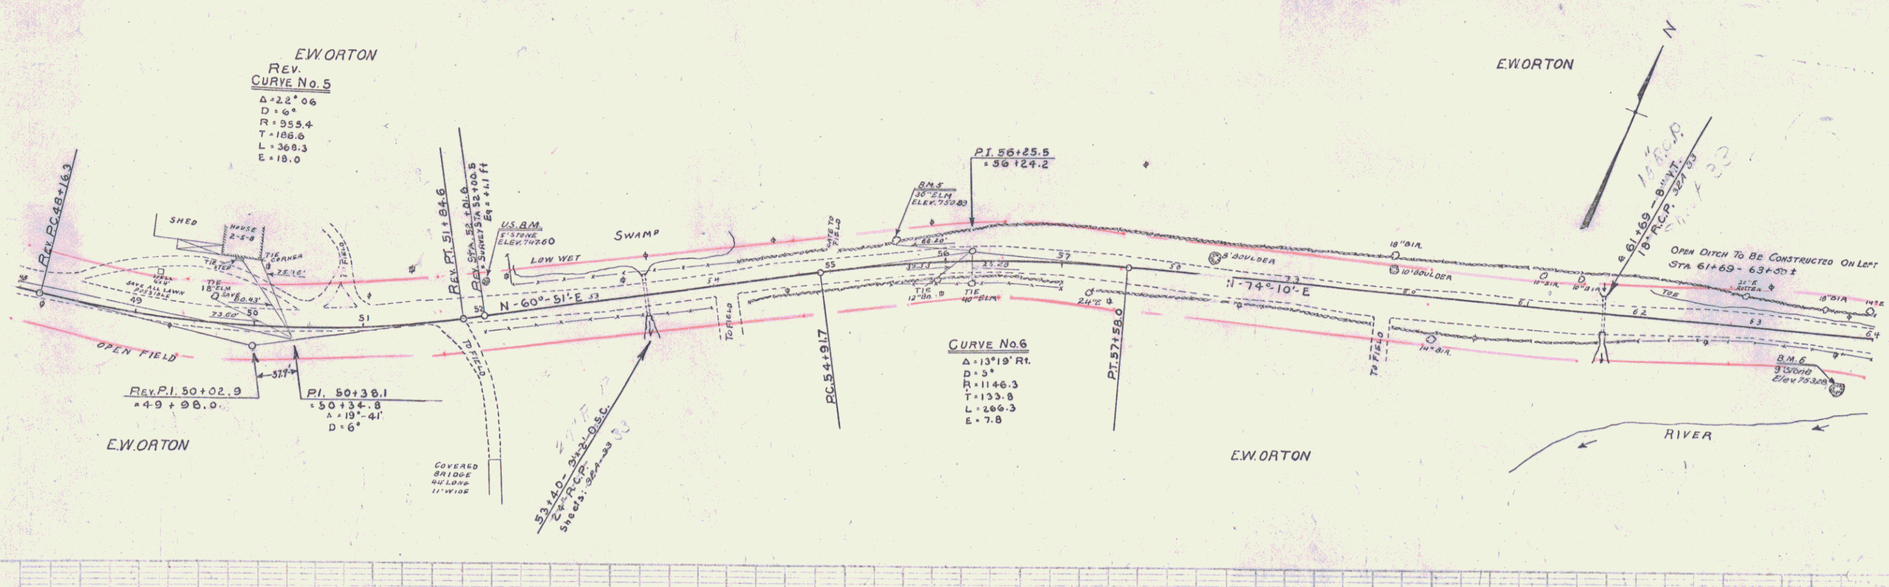

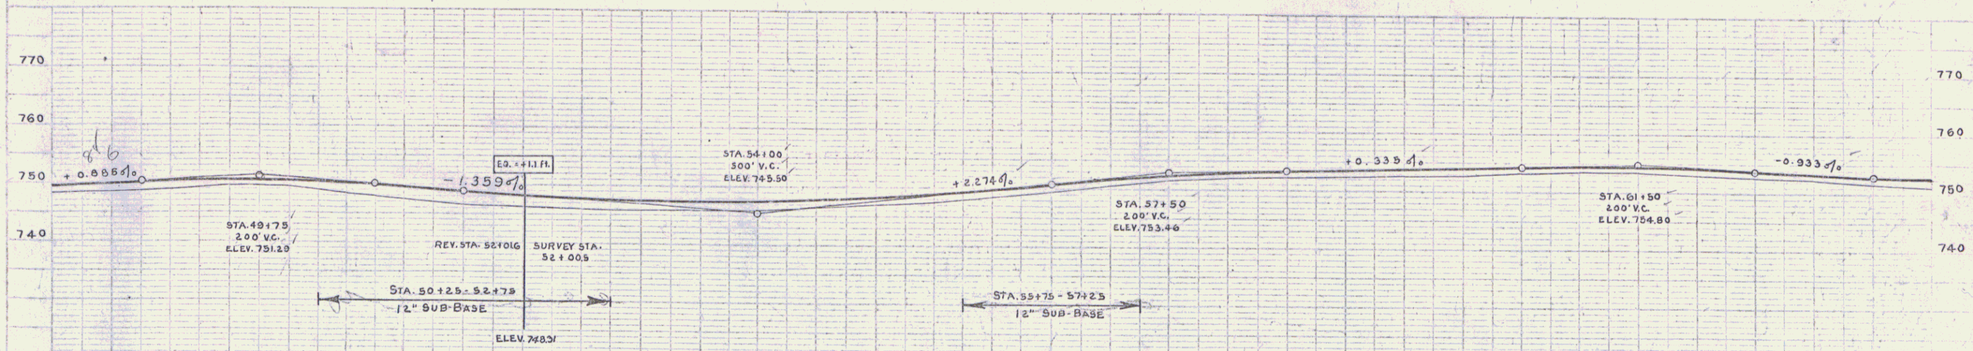

U.S.B.M. 5' Stone 25' Lt. 52+06 Elev. 747.60
B.M. #5 Spike in root 36" Elm 17.5' Lt. 55+59 Elev. 750.89
B.M. #6 Top 9' Boulder in Field 41' Rt 63+72 Elev. 753.28

Sta.	Elev.
48	748.74
+50	749.18
49	750.41
+50	750.60
+68	750.76
+75	750.75
50	750.73
+50	750.64
+50	750.24
+75	749.93
51	749.59
+50	749.32
+85	748.52
52	748.32
+50	747.90
53	747.68
+40	747.63
+50	747.63
54	747.77
+50	748.09
55	748.59
+50	749.47
56	750.14
+50	751.19
57	752.20
+50	752.98
58	753.51
+50	753.80
59	753.87
+50	754.13
60	754.30
+50	754.47
61	754.56
+50	754.48
+69	754.41
62	754.23
+50	754.04
63	753.37
+50	752.91
64	752.58

Series F No. 97D
Sheet 7 of 99

5