FED. ROAD DIST. NO.	STATE	FED. AID PROJ. NO.	ITEM NO.	SHEET NO.	TOTAL SHEETS
9	VT.	97-D	1930	10	99

A31

Wood Guard Rail Required

Sta.	Left	Right
95+18	24'	24'
98+40	—	24'

Wood Guide Posts Required

Station	Left	Right
98+40	1	—
98+52	1	—

Cable Guard Rail Required

Sta. – Sta.	L or R	Length	Constant	Rail Length
93+00 - 98+54	R	154'	20'	174'
108+25 - 109+05	R	80'	40'	120'
108+25 - 108+97	L	72'	40'	112'

Rein. Conc. Pipe Culv. Required

Sta.	Dia.	Leng.	Conc. A	Conc. C	Steel
95+18	24"	36'	2.4 cy.		84#
98+40	24"	32'	2.3 cy.		184#
98+40 Lt.	18"	52'	1.5 cy.		157#
98+52					

Delaying Pipe Culverts

Sta. – Sta.	C.G.M.P. Leng.	Conc. A	Steel	D.I. Grates
106+85 - 108+57 Lt.	12' 172'	3.2 cy.	91#	2

Grouted Cobble Gutter Required

Sta. – Sta.	L or R	Length	Width	Area
108+65 - 109+00	L	40'	9'-0"	13 sq. yds.

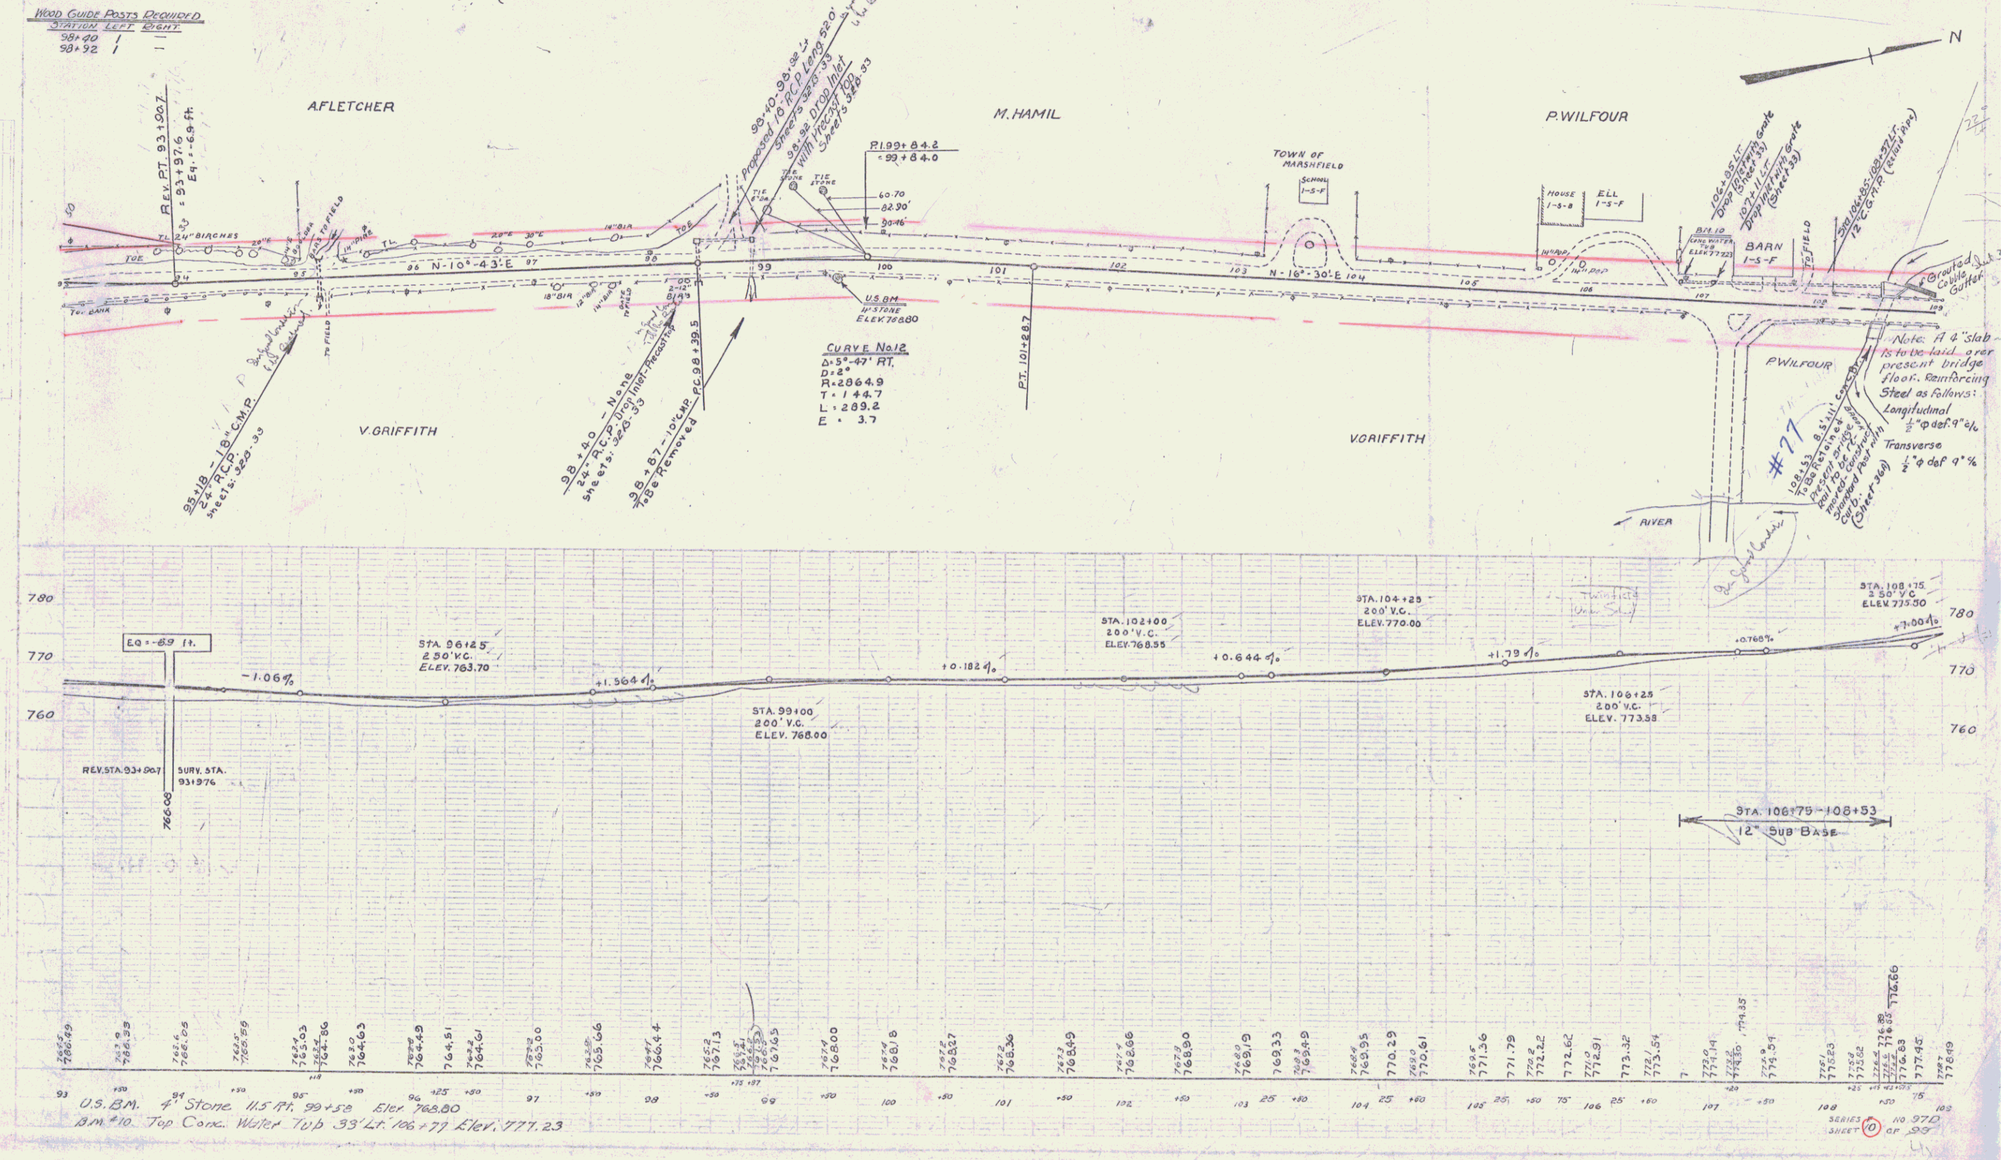

U.S. BM. 4" Stone 11.5 Rt. 99+58 Elev. 768.80
BM. #10 Top Conc. Water Tub 33' Lt. 106+77 Elev. 777.23

SERIES 10 NO. 97D
SHEET 10 OF 99

8