FED. ROAD PROJ. NO.	STATE	FED. AID PROJ. NO.	FISCAL YEAR	SHEET NO.	TOTAL SHEETS
		97-D	1930	20	99

Wood Guard Rail Required

Station	Left	Right
234+97	24'	—
240+11	24'	24'

Wood Guide Posts Required

Station	Left	Right
244+60	1	—

Cable Guard Rail Required

Sta	Sta	Lor-D	Length	Constant	Pay Length
234+75	235+23	2	48'	40'	88'

Reinf. Conc. Pipe Culvert Required

Sta.	Dia.	Leng.	Conc. A	Conc. C	Steel	Di. Grates
234+97	24"	~~[illegible]~~	2.4 c.y.		54#	—
240+11	15"	~~[illegible]~~		3.0 c.y.	33#	—
(244+60) (246+0 (Lt)	12"	150'	3.8 c.y.	—	~~113#~~	~~2~~

Std Underdrain With P.C.G.M.P. (Coated)

Sta.	Dia.	Leng.
233+70 Across Road	6"	14'

C.G.M. Pipe Required

Sta.	Dia.	Leng.	Cem. Rub. Mas.
240+30	12"	28'	2.3 c.y.
237+0	12"	[illegible]	2.3 c.y.

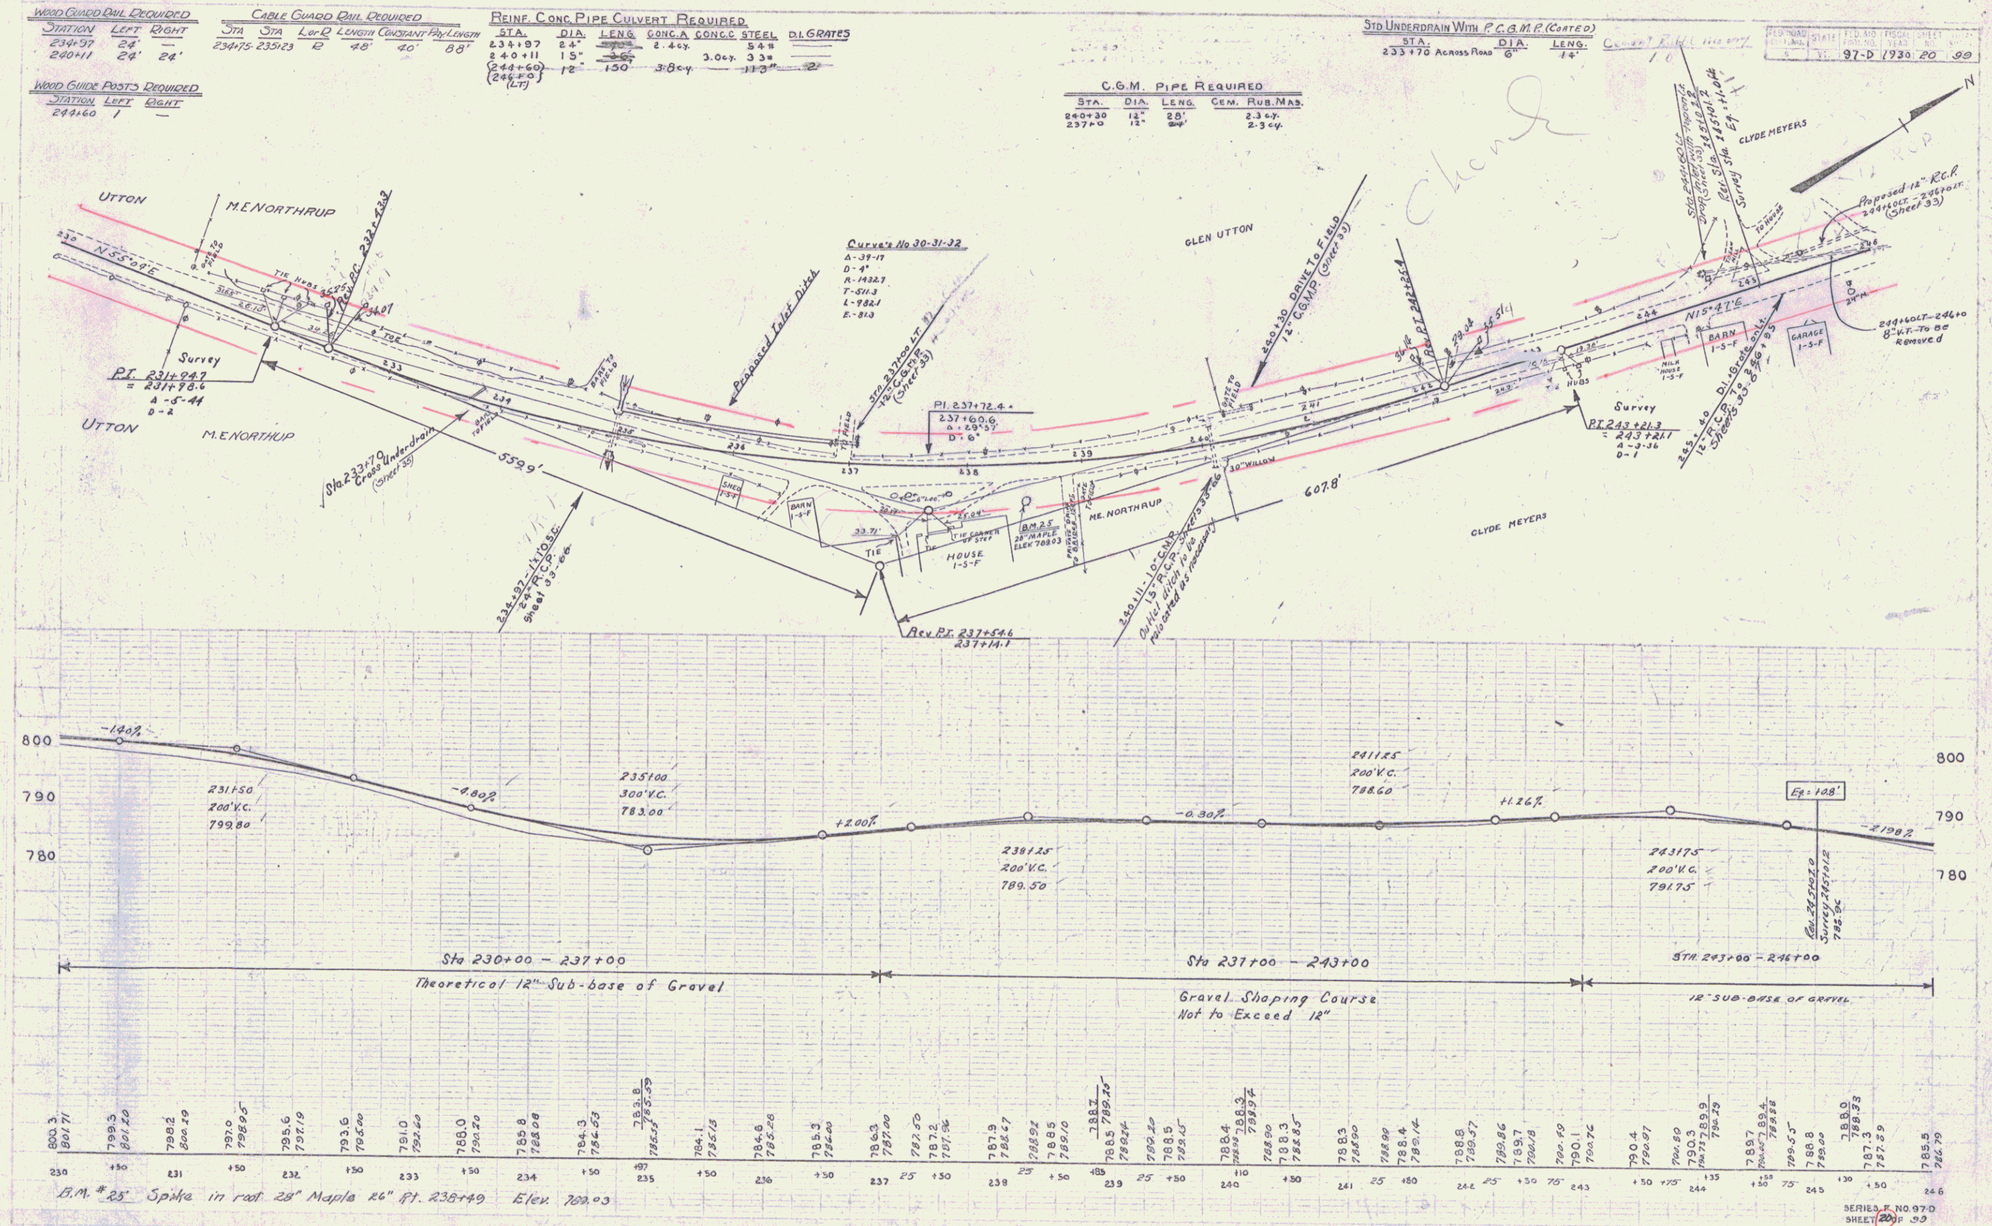

Station	Left	Right
230	800.3	801.71
+50	799.3	801.20
231	799.2	800.29
+50	797.0	798.95
232	795.6	797.19
+50	793.6	795.00
233	791.0	792.60
+50	788.0	790.20
234	785.8	788.08
+50	784.3	786.53
+97	783.8	785.39
235	785.5	
+50	784.1	785.18
236	784.6	785.28
+50	785.3	786.00
237	786.3	787.00
25	787.0	787.50
+50	787.2	787.56
238	787.9	788.67
25	788.2	
+50	788.5	789.10
239	788.7	
+85	788.5	789.25
25	789.2	789.54
+50	789.2	789.50
240	788.4	789.45
+10	788.3	789.34
+30	788.3	788.90
241	788.3	788.85
25	788.4	788.90
+50	788.4	789.14
242	788.8	789.37
25	789.2	789.86
+50	789.7	790.18
75	790.4	790.49
243	790.1	790.76
+50	790.4	790.87
+75	790.5	790.80
244	790.3	789.9
+35	789.9	790.29
+50	789.7	789.4
+55	789.4	789.88
75	789.5	789.55
245	788.8	789.00
+30	788.9	
+50	787.3	788.33
246	785.5	786.79

B.M. #25 Spike in root 28" Maple 26" Rt. 238+49 Elev. 789.03

SERIES F NO. 97-D
SHEET 20 OF 99

18