FED. ROAD DIST. NO.	STATE	PROJ. NO.	FISCAL YEAR	SHEET NO.	TOTAL SHEETS
9	VT.	27	~~1920-21~~ 22	12	75

SEE PROJ. F 028-3(10)

GUARD RAIL REQUIRED

ON LEFT

Sta. 171 + 38 to 171 + 62 Length 24 ft.

~~173 + 87 — 193 + 87 — 20 ft.~~

~~197 + 88 — 199 + 68 — 24 ft.~~

ON RIGHT

Sta. 170 + 28 to 173 + 00 Length 272 ft.

~~193 + 08 — 198 + 00 — 292 ft.~~

TOTAL THIS SHEET ~~[illegible] ft.~~ 296 ft.

NEW CULVERTS REQUIRED

Sta. 171 + 50 16" Cor. Iron Pipe 38 ft.

1-2-4 concrete 15 cu. yds.

Sta. 123 + 37 ~~18" Cor. Iron Pipe 40 ft.~~

~~1-2-4 concrete 1.6 cu. yds.~~

~~Sta. 190 + 50 16" Cor. Iron Pipe 36 ft.~~

~~1-2-4 concrete 1.9 cu. yds.~~

STONE BASE REQUIRED

Sta. 166 + 00 to 167 + 00 100 ft.

Existing stone base to be widened

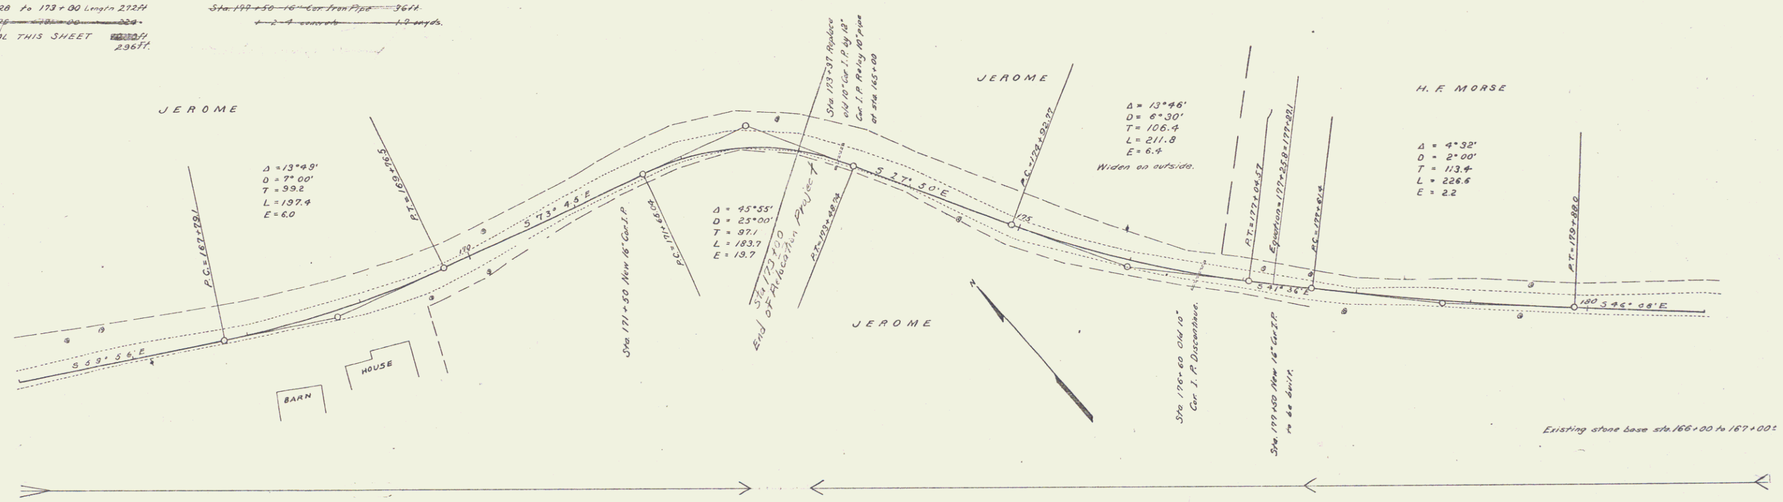

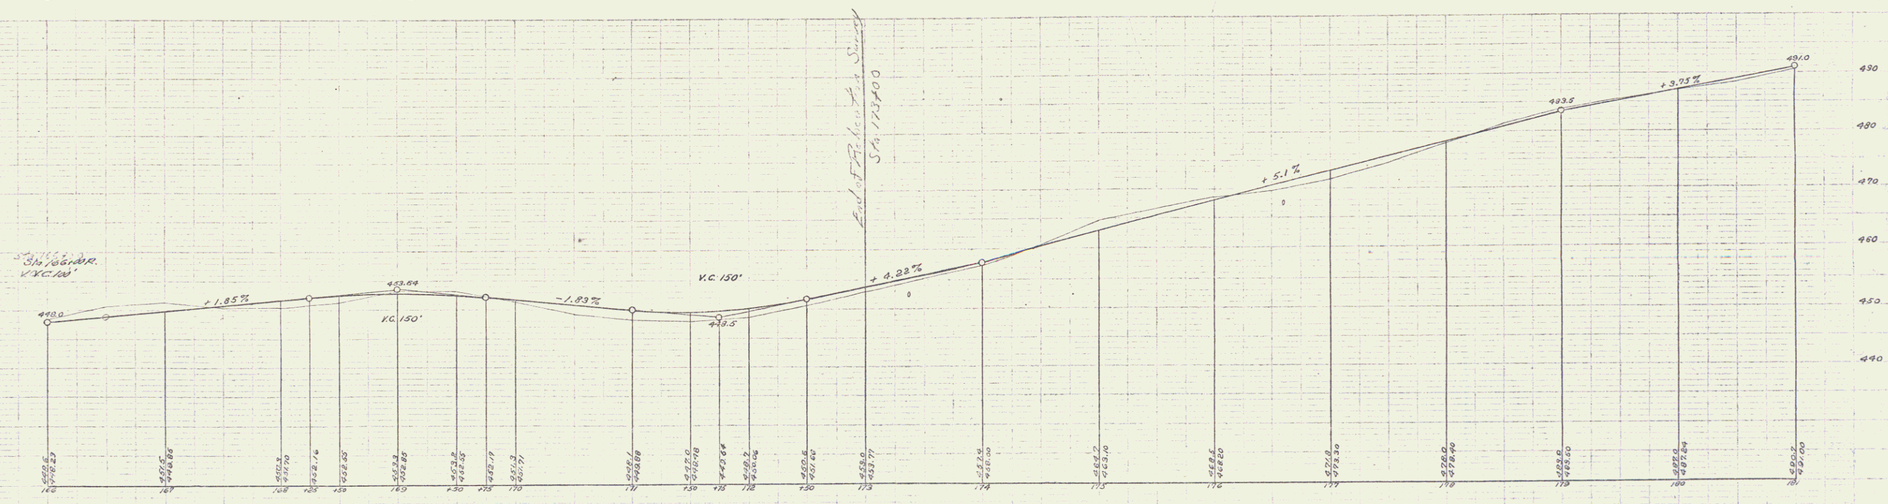

B.M. Bottom base board North Westerly corner of Jerome's house, right at 169 + 00

Series F No. 27 Filed
Sheet 2 of 75

15