FED. ROAD DIST. NO.	STATE	FED. AID PROJ. NO.	FISCAL YEAR	SHEET NO.	TOTAL SHEETS
9	VT	27	192021	17	75

GUARD RAIL REQUIRED

ON LEFT

Sta. 243+22	to	243+46	Length	24 ft.
" 245+54	"	246+50	"	96 "
" 251+88	"	252+12	"	24 "
" 254+25	"	254+49	"	24 "
" 255+63	"	255+87	"	24 "

ON RIGHT

Sta. 243+22	to	243+46	Length	24 ft.
" 245+77	"	246+01	"	24 "
" 251+82	"	252+06	"	24 "
" 254+25	"	254+49	"	24 "
" 255+63	"	255+87	"	24 "

TOTAL THIS SHEET 312 ft.

CULVERT REPAIRS REQUIRED

Sta. 243+43 Lengthen 12" Cor. I.P. 4 ft.
1-2-4 concrete 1.0 cu. yds.

Sta. 245+89 Lengthen 12" Cor. I.P. 4 ft.
1-2-4 concrete 1.0 cu. yds.

Sta. 252+00 Lengthen 16" Cor. I.P. 8 ft.
4 ft. added to both ends.
1-2-4 concrete 1.5 cu. yds.

Sta. 254+37 Lengthen 12" Cor. I.P. 6 ft.
4 ft. added to one end, 2 ft. to the other.
1-2-4 concrete 1.0 cu. yds.

Sta. 255+75 Lengthen 12" Cor. I.P. 2 ft.
1-2-4 concrete 1.0 cu. yds.

RELAYING PIPE CULVERTS

Sta. 243+34 12" Cor. Iron Pipe 28 ft.
" 245+89 12" " " " 28 ft.

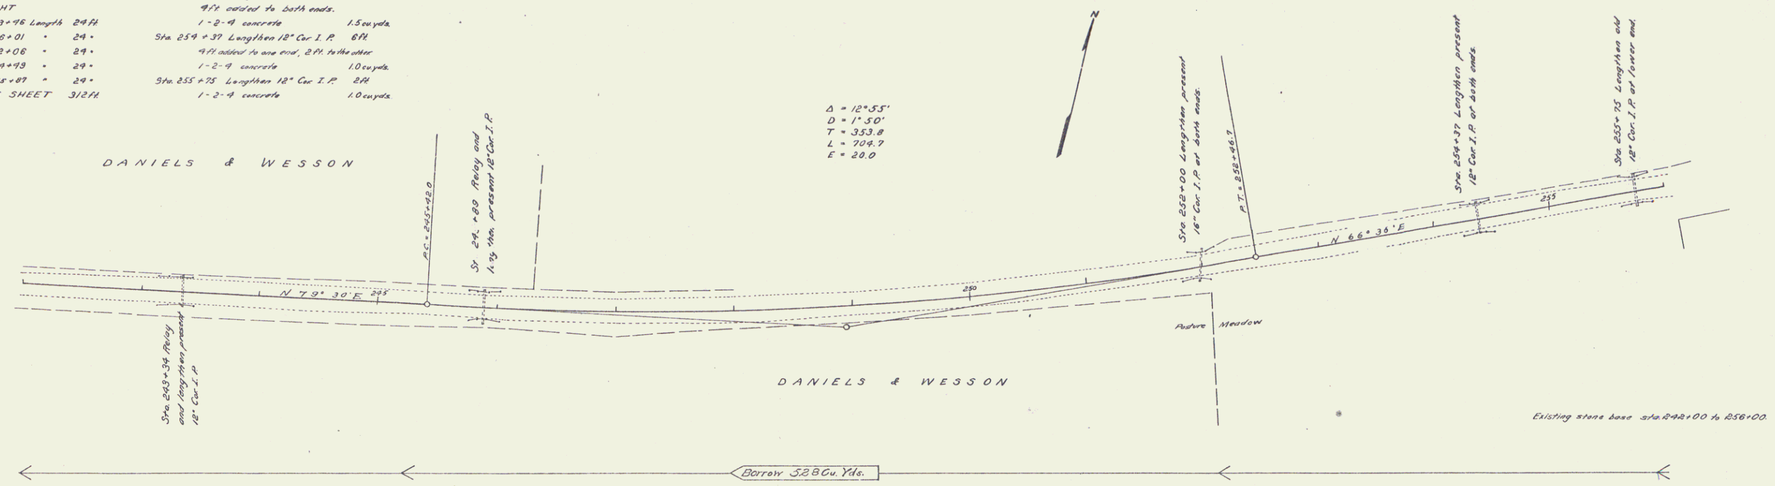

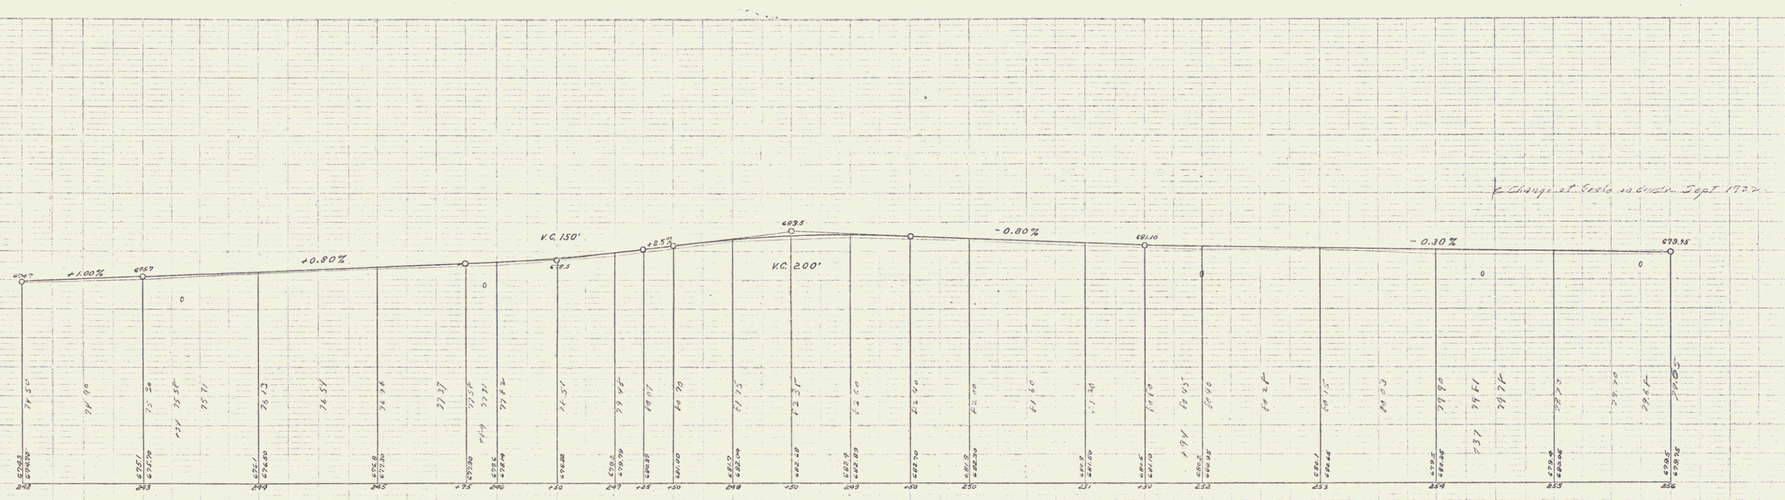

Series F, No. 27 Filed
Sheet 17 of 75

21