FED. ROAD DIST. NO.	STATE	FED. AID PROJ. NO.	FISCAL YEAR	SHEET NO.	TOTAL SHEETS
9	W. Va.	218	1923	7	22

Guard Rail Required

On Left

Sta 161+60	to	Sta 162+64	Length	104 ft.
" 168+88	"	" 169+12	"	24 "
" 175+38	"	" 175+62	"	24 "

On Right

Sta 161+24	to	Sta 163+12	Length	188 ft.
" 163+84	"	" 164+72	"	88 "
" 168+58	"	" 169+38	"	80 "
" 170+82	"	" 172+26	"	144 "
" 174+92	"	" 176+00		108 "
Total this sheet				760 ft.

New Culverts Required

Sta 162+00 16" Corr. Pipe 40'
1-2½-5 Con. 48 Cu. yds. Earth Excav. 2.2 C.Y.

Sta 169+00 16" Corr. Pipe 96' Rock Excav. 2.3 C.Y.
1-2½-5 Con 48 Cu. yds Earth Excav. 0 C.Y.

Sta 175+50 16" Corr. Pipe 96'
1-2½-5 Con 48 Cu. yds. Earth Excav. 1.6 C.Y.

1-2½-5 Con. 1.5 C.Y.
Earth Excav. 2.1 C.Y.

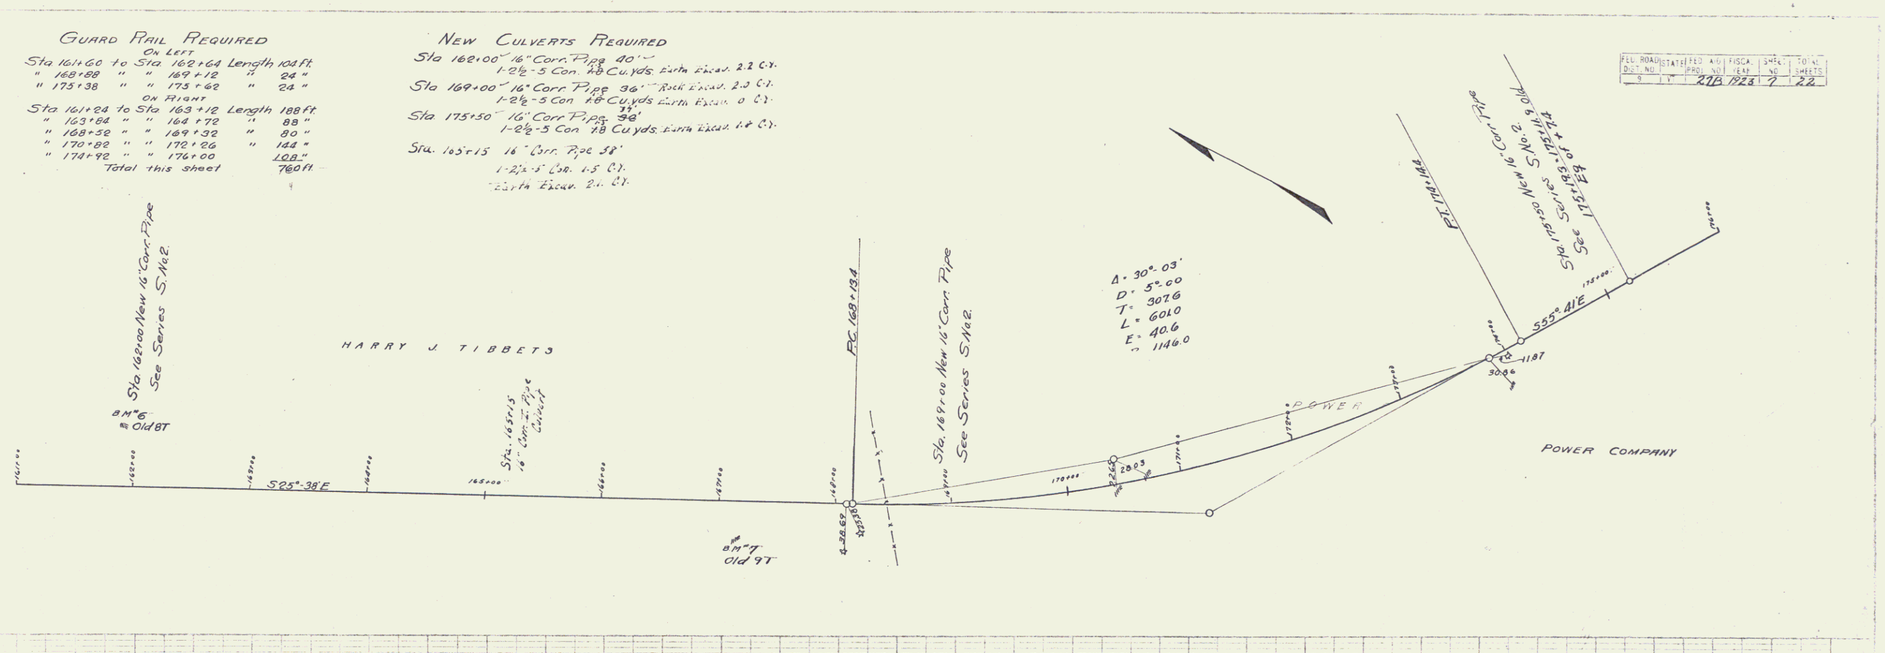

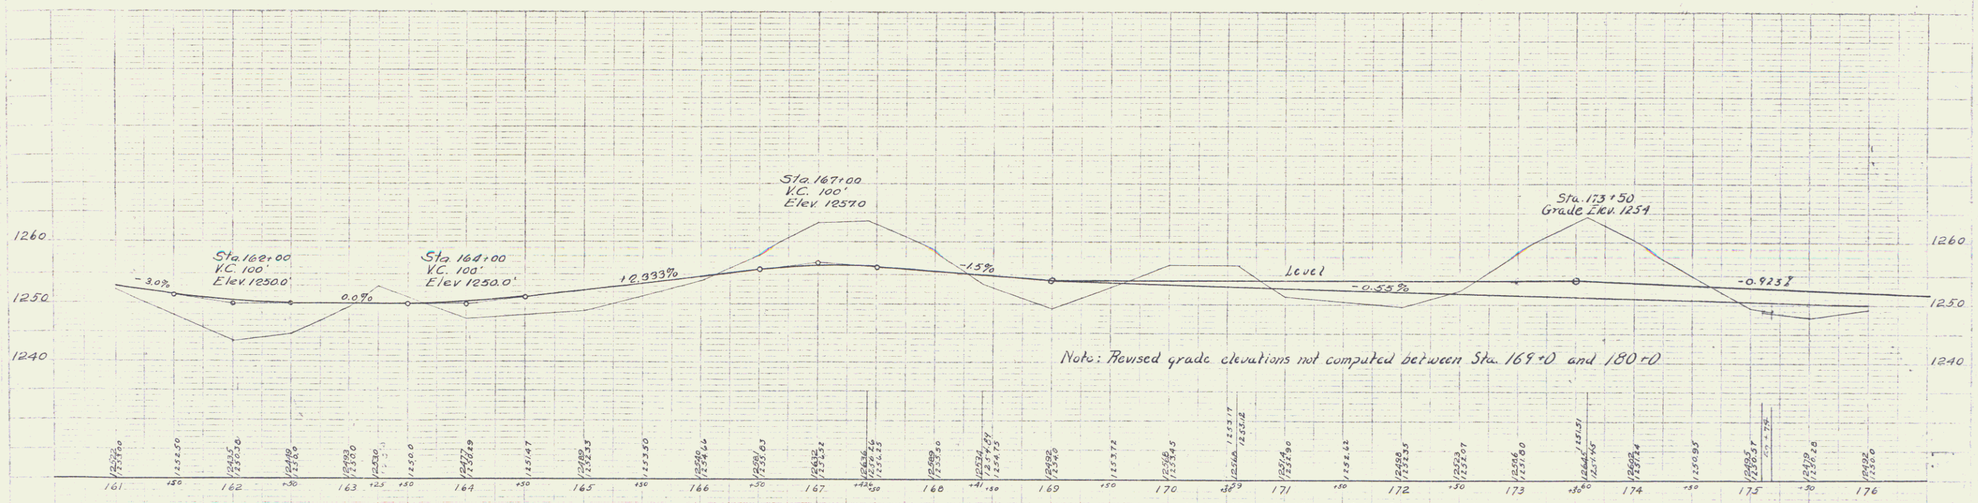

B.M. 46 Drill hole in Rock Old BT Elev. = 1250.55
" " 47 " " " " " 9T " = 1263.80

Series F No. 218. Filed
Sheet 7 of 22

6