FED. ROAD DIST. NO.	STATE	FED. AID PROJ. NO.	FISCAL YEAR	SHEET NO.	TOTAL SHEETS
1		1527	1927	5	55

WOOD GUARD RAIL REQUIRED

STA. 41+78 TO 42+32 – LENGTH 56 FT. (LEFT) — 56 FT.

STA. 27+27 TO 27+75 – LENGTH 48 FT.
STA. 31+44 " 31+68 – " 24 FT.
STA. 41+83 " 42+07 – " 24 FT. (RIGHT) — 96 FT.

TOTAL FOR SHEET – 152 FT.

CABLE GUARD RAIL REQUIRED

STA. 27+00 TO 28+40 – LENGTH 140 FT.
STA. 30+46 TO 33+20 – LENGTH 272 FT. (LEFT)

TOTAL FOR SHEET – 412 FT.

NEW CULVERTS REQUIRED

STA. 27+59 – 18" REINFORCED CONCRETE OR CAST IRON PIPE — LENGTH 44 FT.
CONCRETE CLASS B (1-2½-5) 2.7 CU. YDS.

STA. 31+56 – 24" REINFORCED CONCRETE OR CAST IRON PIPE — LENGTH 36 FT.
CONCRETE CLASS B (1-2½-5) 4.1 CU. YDS.

STA. 41+95 – 3'x3' REINFORCED CONCRETE BOX —
CONCRETE CLASS A (1-2-4) 23.6 CU. YDS.
REINFORCING STEEL 1562 LBS.

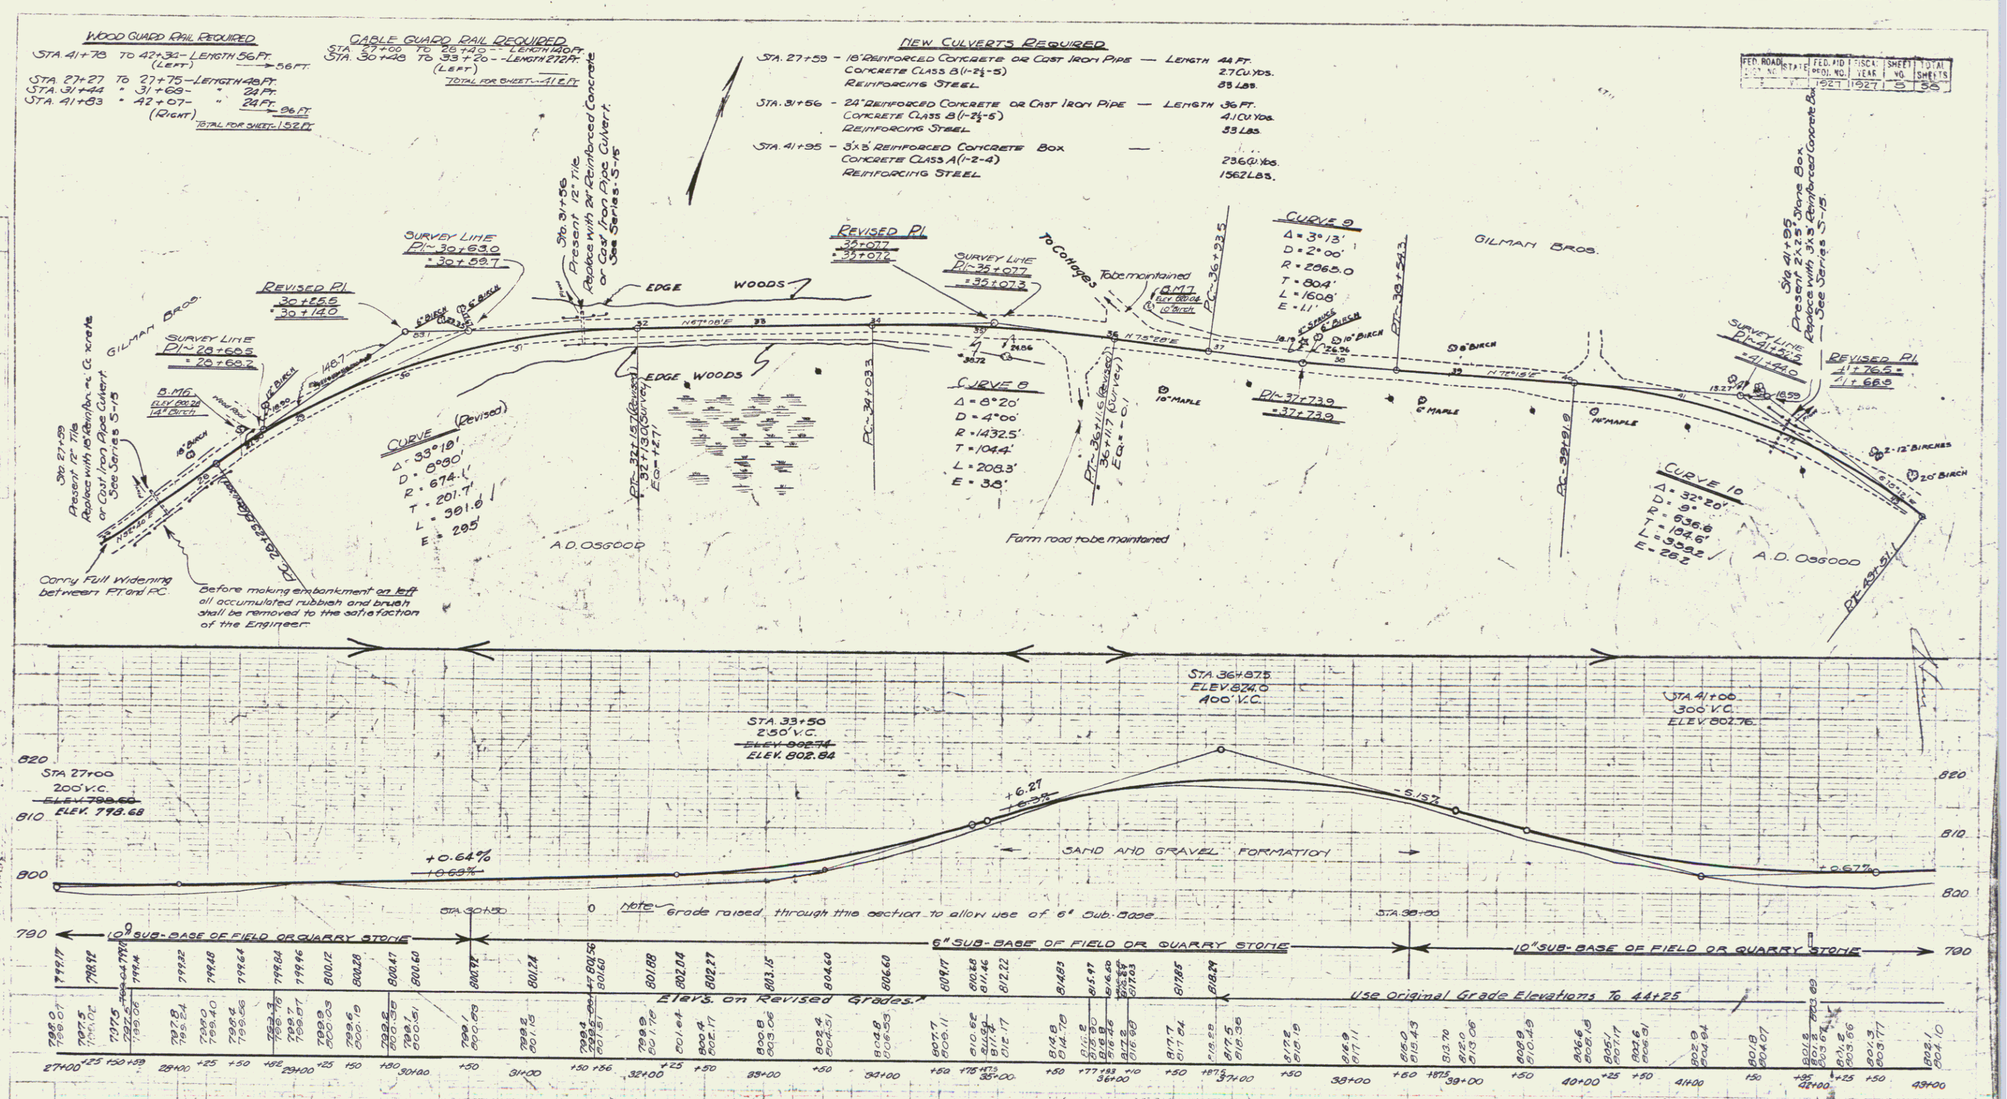

B.M. 6 – Spike in 14" Birch left of Sta. 28+54 – Elev. 800.28.
B.M. 7 – Spike in 10" Birch left of Sta. 35+37 – Elev. 820.04.

SERIES F No. 95A
SHEET 5 OF 56

4